

JUL 16 1961

115 W
4 1/2

New Location
 Drill Deeper
 Abandonment

Map Sh 56 519 E 13 FB 531 P. 30-32

Company Hope Natural Gas Co
 Address Clarksburg, W. Va.
 Farm Margt Reed
 Tract _____ Acres 43 Lease No. 43744
 Well (Farm) No. _____ Serial No. 6939
 Elevation (Spirit Level) 1157'
 Quadrangle Weston
 County Harrison District Grant
 Engineer W M Bowers
 Engineer's Registration No. 900
 File No. _____ Drawing No. _____
 Date 10-27-60 Scale 1"=40P

STATE OF WEST VIRGINIA
 DEPARTMENT OF MINES
 OIL AND GAS DIVISION
 CHARLESTON

WELL LOCATION MAP
 FILE NO. HAR-1780-A

+ Denotes location of well on United States Topographic Maps, scale 1 to 62,500, latitude and longitude lines being represented by border lines as shown.

- Denotes one inch spaces on border line of original tracing.

MARGARET REED No. 6939 - HOPE NG. Co. - HAR-1780-A



1884

STATE OF WEST VIRGINIA
DEPARTMENT OF MINES
OIL AND GAS DIVISION

Quadrangle Wagon
Permit No. 1780A

WELL RECORD

Oil or Gas Well Gas
(KIND)


Company Hope Natural Gas Company
Address Clarksburg, W. Va.
Farm Margaret Road Acres 43
Location (waters) _____
Well No. 6939 Elev. 1157
District Grant County Harrison
The surface of tract is owned in fee by _____
Address _____
Mineral rights are owned by _____
Address _____
Drilling commenced Unknown (Rig completed
Drilling completed 10-7-23)
Date Shot _____ From 2444 To 2452
With 12-7-23 20 qts.
Open Flow _____ /10ths Water in _____ Inch
_____ /10ths Merc. in _____ Inch
Volume Exhausted Cu. Ft.
Rock Pressure - - lbs. hrs.
Oil None bbls., 1st 24 hrs.
WELL ACIDIZED No
WELL FRACTURED No

Casing and Tubing	Used in Drilling	Left in Well	Packers
Size			Kind of Packer
16			
13			
10	238	238	Size of
8 1/4			
6 5/8	1495	1495	Depth set
5 3/16	2008	2008	
3			Perf. top
2	2476	2476	Perf. bottom
Liners Used			Perf. top
			Perf. bottom

CASING CEMENTED _____ SIZE _____ No. Ft. _____ Date _____
No Cementing
COAL WAS ENCOUNTERED AT _____ FEET _____ INCHES
NONE FEET _____ INCHES FEET _____ INCHES
_____ FEET _____ INCHES FEET _____ INCHES

RESULT AFTER TREATMENT _____
ROCK PRESSURE AFTER TREATMENT _____
Fresh Water _____ Feet Salt Water _____ Feet

Formation	Color	Hard or Soft	Top	Bottom	Oil, Gas or Water	Depth	Remarks
Sand			85	125			
Sand			200	230			
Big Dunkard			535	565			
Gas Sand			625	674			
First Salt			696	770			
2nd Salt Sand			785	1040			
Sand			1250	1274			
Maxton			1405	1420			
Little Line			1435	1450			
Pencil Cave			1450	1473			
Big Line			1473	1540			
Big Injun			1540	1688			
GANTZ			1903	1995	Gas & Water	1963	
50' sand			2001	2080			
30' sand			2102-	2155			
Gordon Stray			2220	2260			
Gordon Sand			2280	2305			
Fifth Sand			2428	2452	Gas	2431-49'	
Total Depth				2476'			

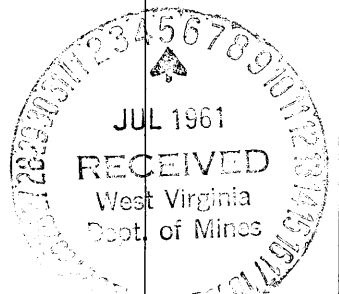

APR 6 1962

November 5, 1960
John R. Bailey
W. V. G. Co.