

4.27S
2.94W
R. O. W.
Y. J. J. A.

New Location
Drill Deeper
Abandonment

SEP 18 1961

Company WILLIAM CASSIDY
 Address 4303 Whitford Drive, Vienna, West Va
 Farm Benjamin F. Boner
 Tract _____ Acres 40 Lease No. _____
 Well (Farm) No. Five Serial No. _____
 Elevation (Spirit Level) 1345.0
 Quadrangle Kadis
 County Harrison District Union
 Engineer W. J. J. A.
 Engineer's Registration No. 1227
 File No. _____ Drawing No. _____
 Date August 1961 Scale 1" = 300'

STATE OF WEST VIRGINIA
DEPARTMENT OF MINES
OIL AND GAS DIVISION
CHARLESTON

WELL LOCATION MAP
FILE NO. HAR-1785-A

+ Denotes location of well on United States Topographic Maps, scale 1 to latitude and longitude lines being represented by border lines as shown.
 - Denotes one inch spaces on border line of original tracing.



1653

STATE OF WEST VIRGINIA
DEPARTMENT OF MINES
OIL AND GAS DIVISION

Quadrangle Volis
Permit No. 1785-A

WELL RECORD

Oil or Gas Well Oil (KIND)

Company William Cassady
Address 4901 - 9th Ave., Vienna, W. Va.
Farm B. F. Boner Acres 40
Location (waters) _____
Well No. 5 Elev. 1345
District Union County Harrison
The surface of tract is owned in fee by _____
Address _____
Mineral rights are owned by _____
Address _____
Drilling commenced _____
Drilling completed _____
Date Shot _____ From _____ To _____
With _____
Open Flow _____ /10ths Water in _____ Inch
_____ /10ths Merc. in _____ Inch
Volume _____ Cu. Ft.
Rock Pressure _____ lbs. _____ hrs.
Oil _____ bbls., 1st 24 hrs.
WELL ACIDIZED _____
WELL FRACTURED _____


Casing and Tubing	Used in Drilling	Left in Well	Packers
Size			Kind of Packer
16			
13			
10		335	Size of
8 1/4		1245	
6 5/8		2208	Set on Packer with Depth set <u>Lead</u>
5 3/16		2683	
3			Perf. top
2			Perf. bottom
Liners Used			Perf. top
			Perf. bottom

CASING CEMENTED _____ SIZE _____ No. Ft. _____ Date _____

COAL WAS ENCOUNTERED AT _____ FEET _____ INCHES
_____ FEET _____ INCHES FEET _____ INCHES
_____ FEET _____ INCHES FEET _____ INCHES

RESULT AFTER TREATMENT _____
ROCK PRESSURE AFTER TREATMENT _____
Fresh Water _____ Feet Salt Water _____ Feet

Formation	Color	Hard or Soft	Top	Bottom	Oil, Gas or Water	Depth	Remarks
Native Coal			195	198			
Pittsburgh Coal			778	783			
Dunkard Sand			1145	1190			
Maxon Sand			1940	1990			
Big Line			2170	2235			
Big Injun			2235	2335	Gas & Water	2275	
Gantz Sand			2560	2580			
Fifty Foot			2660	2665			
Thirty Foot			2768	2788			
Stray Sand			2825				
Pay			2860				
Total Depth				2870			

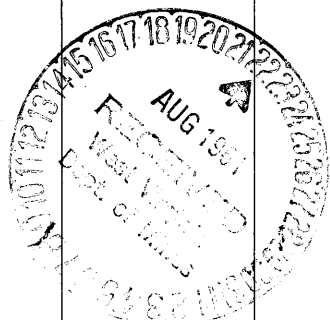

APR 6 1962