


Latitude 39 ° 20'

Longitude 80 ° 25'

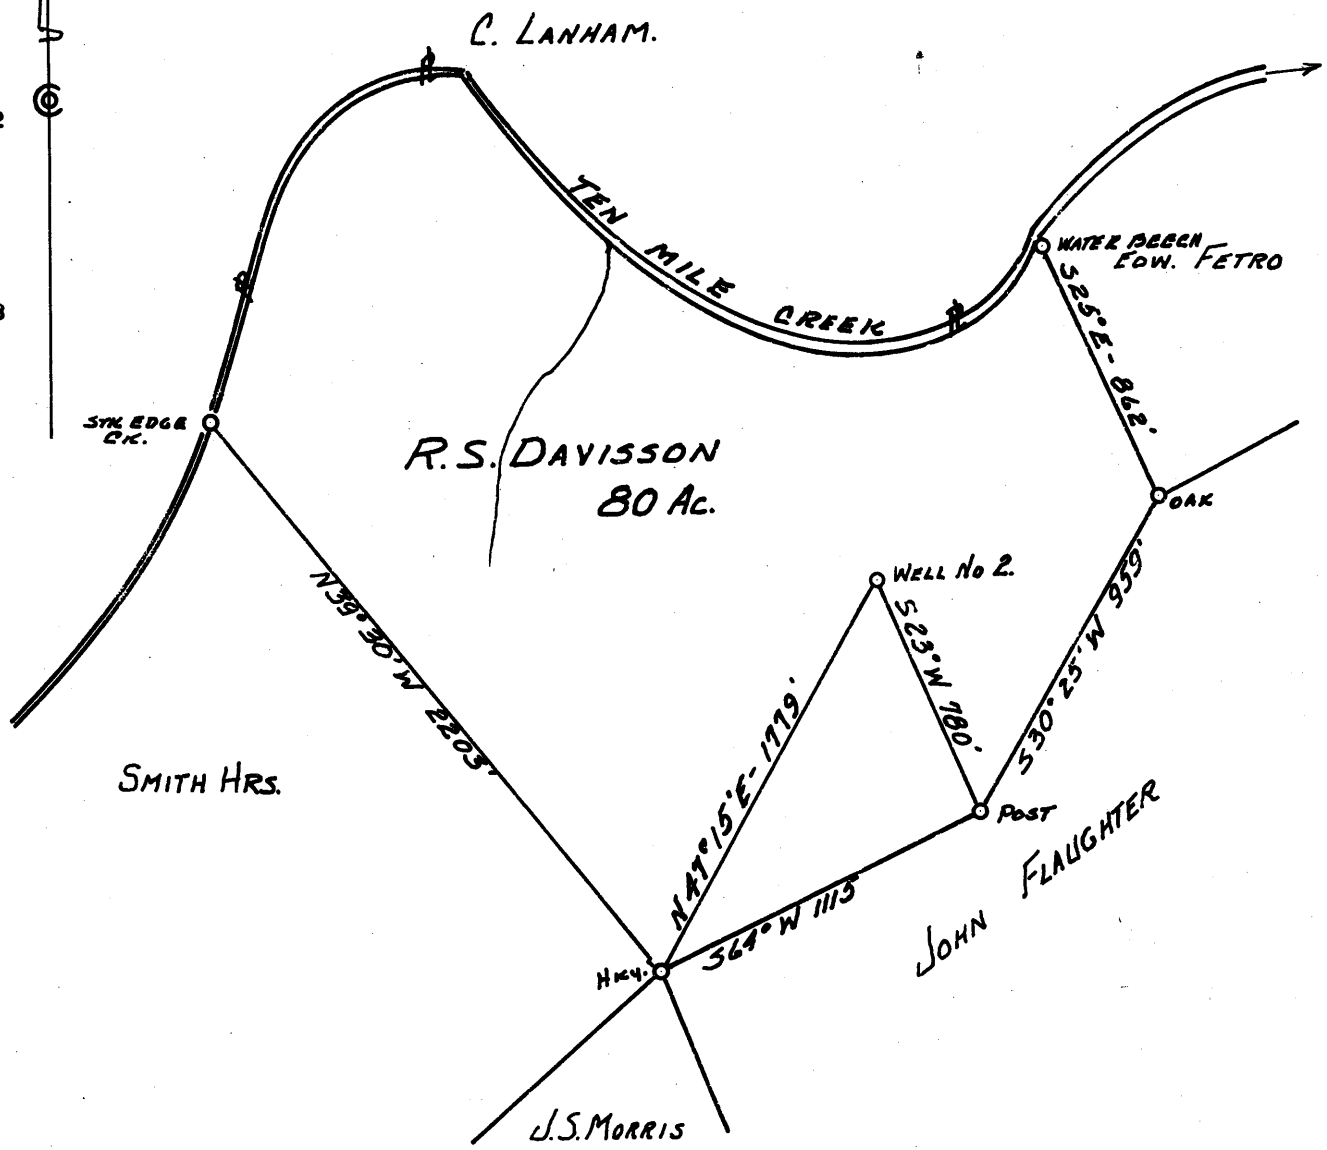

0.625  
2.10W

- New Location
- Drill Deeper
- Abandonment

FORMER SOUTH PENN OIL CO LEASE NO. 33868

Company PACK & JACKSON  
 Address Box 175. HAMLIN. W. Va.  
 Farm R.S. DAVISSON HRS.  
 Tract \_\_\_\_\_ Acres 80 Lease No. \_\_\_\_\_  
 Well (Farm) No. 2 Serial No. \_\_\_\_\_  
 Elevation (Spirit Level) 1296.5'  
 Quadrangle CLARKSBURG  
 County HARRISON District TEN MILE  
 Engineer John W. Hamilton  
 Engineer's Registration No. 2274  
 File No. \_\_\_\_\_ Drawing No. \_\_\_\_\_  
 Date MAR. 26. 1962 Scale 1" = 600'

STATE OF WEST VIRGINIA  
 DEPARTMENT OF MINES  
 OIL AND GAS DIVISION  
 CHARLESTON

WELL LOCATION MAP  
 FILE NO. HAR-1796-A

+ Denotes location of well on United States Topographic Maps, scale 1 to 62,500, latitude and longitude lines being represented by border lines as shown.

- Denotes one inch spaces on border line of original tracing.