


Latitude 39° 20'

Longitude 80° 15' 15,200'

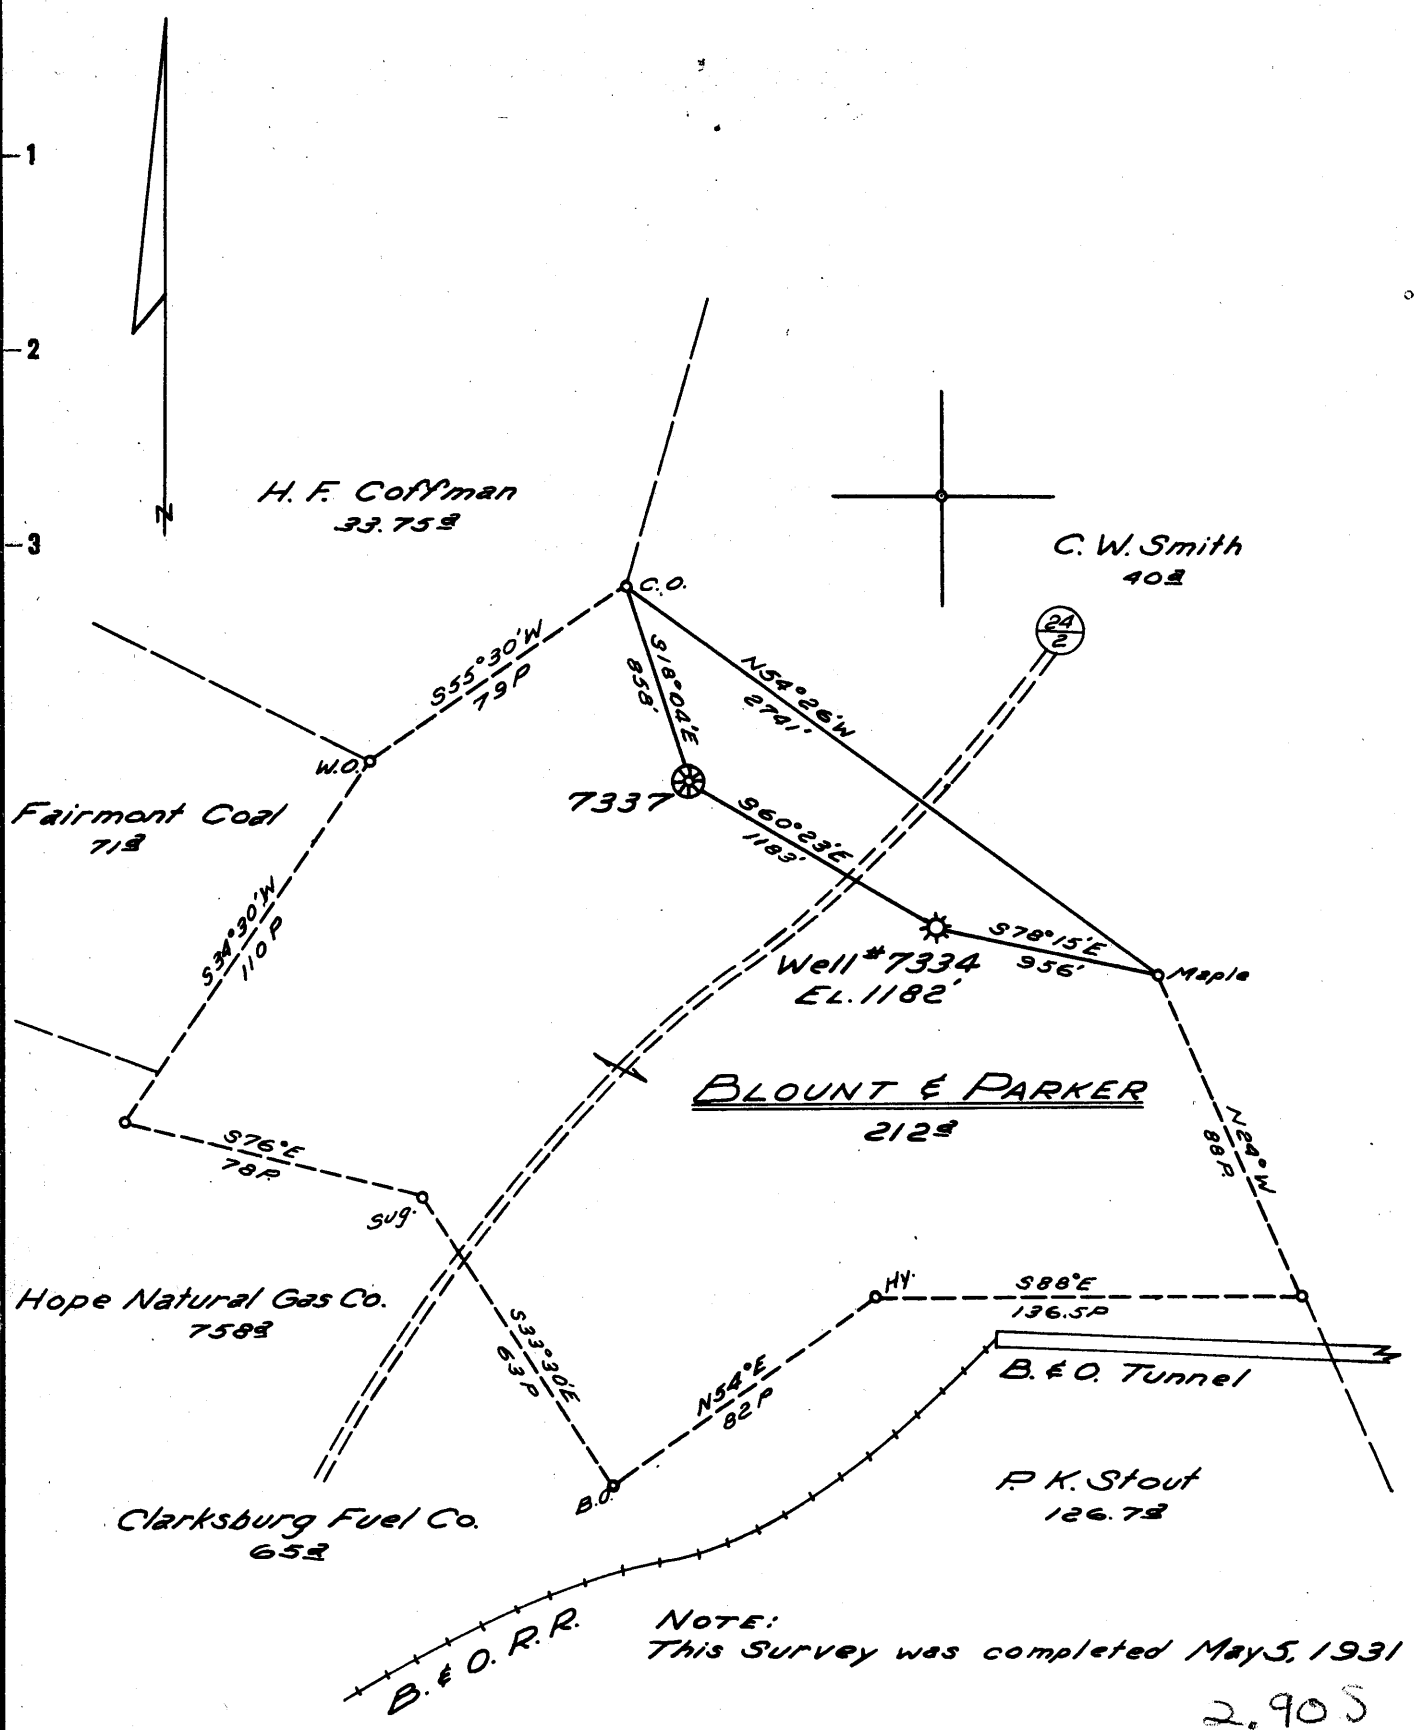

NOTE: This Survey was completed May 5, 1931

2.90 S
2.60 W

- New Location
- Drill Deeper
- Abandonment

Map Sheet 43, S-12, E-17; F.B. 512, P. 3

Company HOPE NATURAL GAS CO.
 Address CLARKSBURG, W. VA.
 Farm BLOUNT & PARKER
 Tract _____ Acres 212 Lease No. 44547
 Well (Farm) No. _____ Serial No. 7334
 Elevation (Spirit Level) 1182'
 Quadrangle CLARKSBURG S. E.
 County HARRISON District COAL
 Engineer Jackson M. Jarvis.
 Engineer's Registration No. 2397
 File No. _____ Drawing No. _____
 Date 10-17-63 Scale 1" = 800'

STATE OF WEST VIRGINIA
DEPARTMENT OF MINES
OIL AND GAS DIVISION
CHARLESTON

WELL LOCATION MAP
FILE NO. HAR-1817-A

+ Denotes location of well on United States Topographic Maps, scale 1 to 62,500, latitude and longitude lines being represented by border lines as shown.

- Denotes one inch spaces on border line of original tracing.