


13,100
P.P. 3/2/73 CEN
LATITUDE 39° 10'
39 09 50
80 18 20

1050'
LONGITUDE 80° 15'

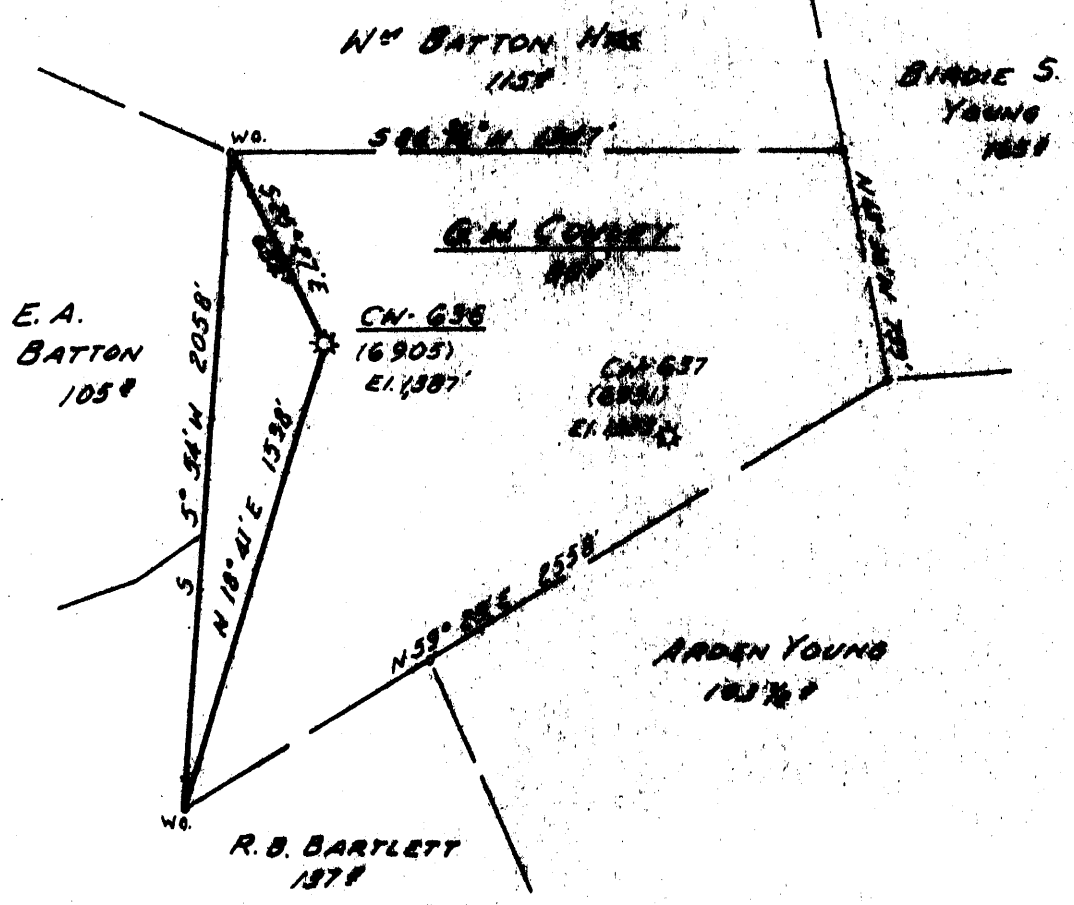

0.195
2.97W

0.185
2.96W

Minimum Error of Closure 1' IN 200'
Source of Elevation CONSOLIDATED GAS SUPPLY CORP
WELL NO. 5620
"I, the undersigned, hereby certify that this map is correct to the best of my knowledge and belief and shows all the information required by paragraph 6 of the rules and regulations of the oil and gas section of the mining laws of West Virginia."

- Partially Plug
- RECONDITION
- New Location
- Drill Deeper
- Abandonment

3/2/73

MAR SHEET 34 S R 17 E R 16 A 17

Company CONSOLIDATED GAS SUPPLY CORP
 Address CLARKSBURG, WEST VA.
 Farm G.W. CONLEY
 Tract _____ Acres 80 Lease No. 43722
 Well (Farm) No. _____ Serial No. CN-656
 Elevation (Spirit Level) 1387'
 Quadrangle WESTON EC
 County HARRISON District ELK
 Engineer JACKSON M. JARVIS
 Engineer's Registration No. 2397
 File No. _____ Drawing No. _____
 Date FEB. 23, 1973 Scale 1" = 600'

STATE OF WEST VIRGINIA
DEPARTMENT OF MINES
OIL AND GAS DIVISION
CHARLESTON

WELL LOCATION MAP
FILE NO. West-1916-A-PP

+ Denotes location of well on United States Topographic Maps, scale 1 to 62,500, latitude and longitude lines being represented by border lines as shown.
 - Denotes one inch spaces on border line of original tracing.



STATE OF WEST VIRGINIA
DEPARTMENT OF MINES
Oil and Gas Division
WELL RECORD

Rotary Oil _____
Cable _____ Gas _____
Recycling _____ Comb. _____
Water Flood _____ Storage
Disposal _____ (Kind)

Quadrangle Weston
Permit No. HAR-1916-PP

Company Consolidated Gas Supply Corp.
Address Clarksburg, WV
Farm G. W. Conley Acres 80
Location (waters) _____
Well No. CW-636 (6905) Elev. 1307
District Elk County Harrison
The surface of tract is owned in fee by _____
G. W. Conley
Address Lost Creek, WV
Mineral rights are owned by Same
Address _____
Drilling Commenced 4-11-73
Drilling Completed 4-24-73
Initial open flow _____ cu. ft. _____ bbls.
Final production 0 cu. ft. per day _____ bbls.
Well open 14 days ~~30~~ before test 55# RP.
Well treatment details:

Casing and Tubing	Used in Drilling	Left in Well	Cement fill up Cu. ft. (Sks.)
Size			
20-16			
Cond.			
13-10"			
9 5/8			
8 5/8			
7			
5 1/2			
4 1/2	2326	2326	525 SKS
3			
2			
Liners Used			

Attach copy of cementing record.

*Reconditioned for Lost Creek Storage.

Coal was encountered at _____ Feet _____ Inches
Fresh water _____ Feet _____ Salt Water _____ Feet _____
Producing Sand Gantz Depth _____

Formation	Color	Hard or Soft	Top Feet	Bottom Feet	Oil, Gas or Water	* Remarks
Big Lime			1385	1459		
Big Injun			1459	1567		
<u>Gantz</u>			1776	1811		<u>Gas</u> 1792-98
Gantz "A"			1821	1851		
<u>50'</u>			1872	1957		
Total Depth				2401 PB	2326	

(over)

* Indicates Electric Log tops in the remarks section.