


LATITUDE 38° 35'

LONGITUDE 81° 35'

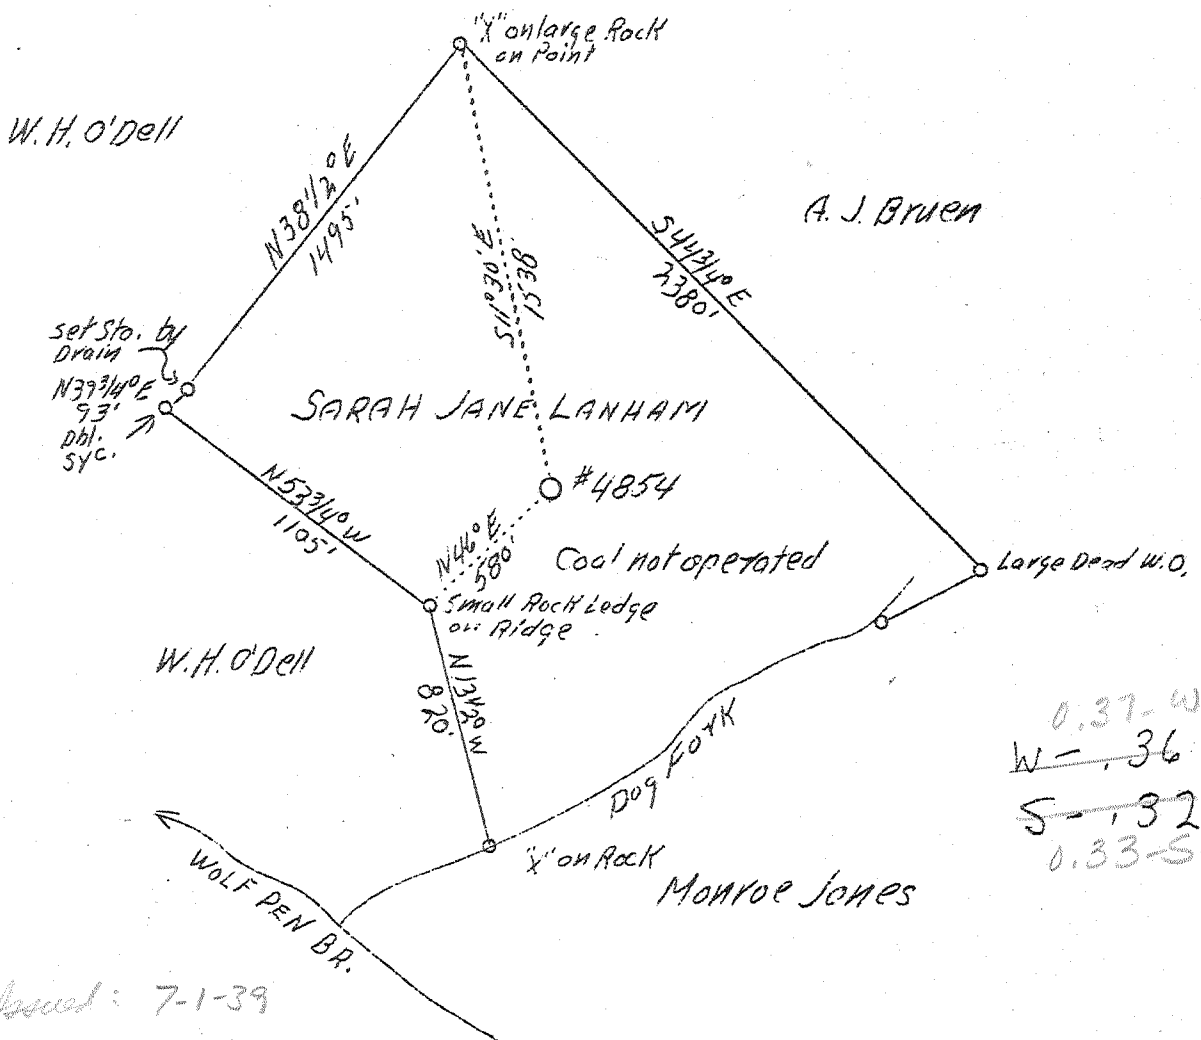

New location

Company	United Fuel Gas Co.
Address	Charleston, W.Va.
Farm	Sarah Jane Lanham et al
Acres	77
Lease No.	40528
Serial No.	4854
Well (Farm) No.	1
Quadrangle	50 Kenna
County	Kanawha Jackson
District	Washington
Eng.	G.A. Cunningham
Eng. Reg. No.	659
File No.	64 - 75
Date	6/20/39
Scale	1" = 660'

STATE OF WEST VIRGINIA
Department of Mines
OIL AND GAS DIVISION
Charleston

WELL LOCATION MAP

File No. 100-49

x Denotes location of well on U.S. Topographic Maps, scale 1 to 62,500, latitude and longitude lines being represented by border lines as shown.

- Denotes one inch spaces on borderline of original tracing.

Deep

