


Latitude 39° 00'

Longitude 81° 36'

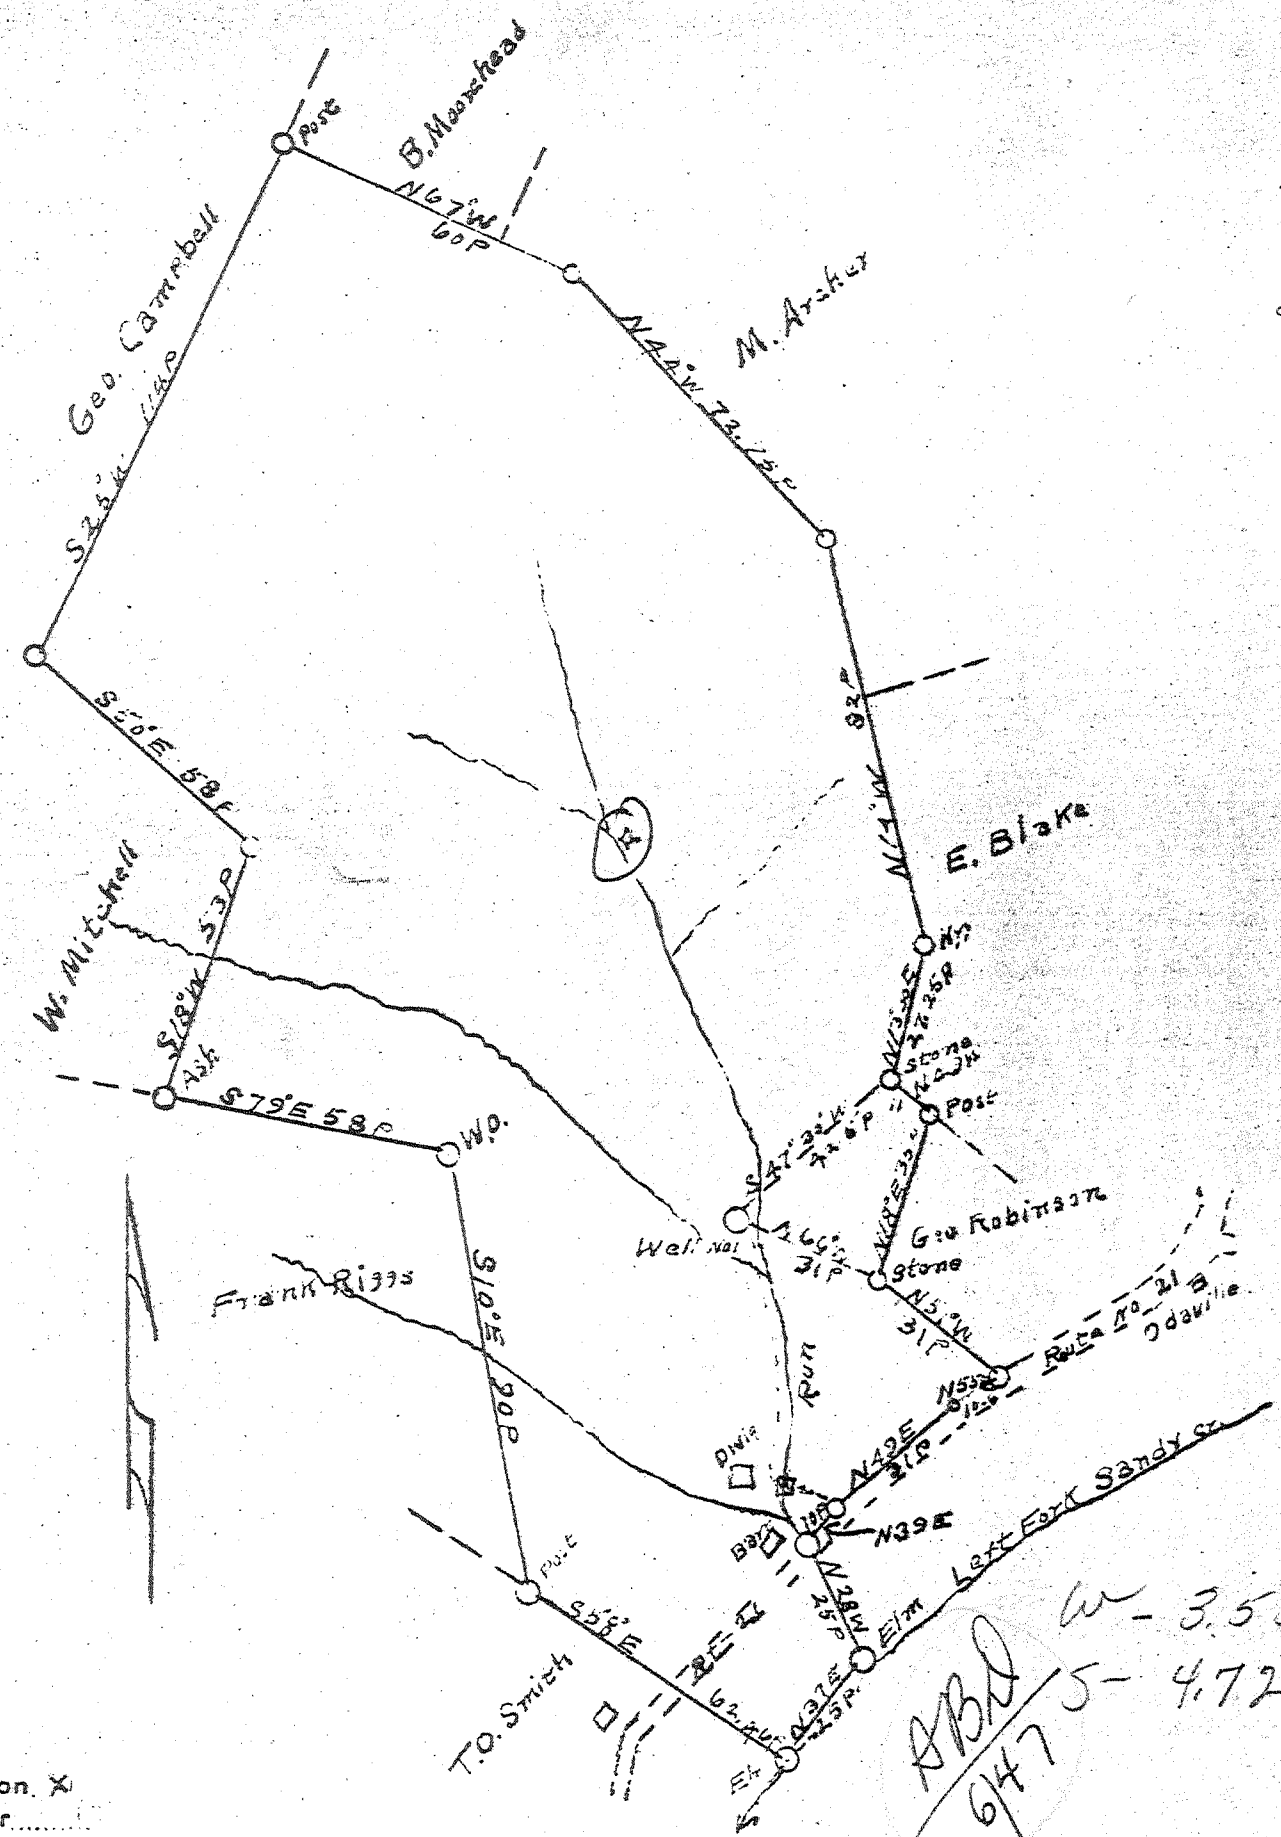

New Location, X
 Drill Deeper.....
 Abandonment.....

ABD
 6/47
 5-3.55
 5-4.72

Company Joe Rubin
 Address Parkersburg WVA.
 Farm Jackson County Bank
 Tract _____ Acres 203 Lease No. _____
 Well (Farm) No. 1 Serial No. _____
 Elevation (Spirit Level) 615'
 Quadrangle Ripley NC
 County Jackson District Havenswood
 Engineer J.E. Anderson
 Engineer's Registration No. Wood Co. Surveyor
 File No. _____ Drawing No. _____
 Date Jan 30, 1941 Scale 1 in = 20 Poles

STATE OF WEST VIRGINIA
 DEPARTMENT OF MINES
 OIL AND GAS DIVISION
 CHARLESTON

WELL LOCATION MAP
 FILE NO. JAC-114

+ Denotes location of well on United States Topographic Maps, scale 1 to 62,500, latitude and longitude lines being represented by border lines as shown.

- Denotes one inch spaces on border line of original tracing.

66-192

WEST VIRGINIA DEPARTMENT OF MINES
OIL & GAS DIVISION
W E L L R E C O R D

Permit No. Jac-114
Ripley Quad.

Gas Well

Company	Joe Rubin, et al	CASING & TUBING	
Address	1900-19th St., Parkersburg, W. Va.	18-3/4	44
Farm	Jackson Co. Bank - ACRES 203	10-1/4	1144
Well No.	1 ELEV. 615	8-1/4	1974
District	Ravenswood - Jackson County	7	4917
Surface & Mineral	Jackson Co. Bk., Ravenswood, W. Va.	2	4950
Commenced	2/19/41 - completed 7/17/41		
Shot	7/10/41 - depth 4926		
Open Flow	- 4383 Mcf, G.P. 1900 (65-00) XVI		
Volume	-		
Rock Pressure	- Shot @ 4926		
Water	-		

Red Rock	0	15	Slate - black	905	935
Shale - brown	15	40	Sand - gray	935	945
Sand	40	65	Lime	945	950
Red Rock	65	80	Slate - black	950	983
Slate - white	80	115	Slate - white	983	1009
Red Rock	115	160	Sandy Lime	1009	1019
Sand	160	170	Sand	1019	1036
Red Rock	170	190	Sand - gray	1036	1074 W 1056
Slate	190	230	Slate	1074	1076
Red Rock	230	245	Sand - gray	1076	1085
Lime Sandy	245	250	Slate - black	1085	1102
Red Rock	250	255	Sand - gray	1102	1110
Lime	255	260	Lime	1110	1147
Red	260	280	Slate - dark	1147	1160
Slate - white	280	290	Sand - gray	1160	1173
Sand - gray	290	295	Lime - white	1173	1175
Slate - white	295	300	Slate - brown	1175	1181
Red Rock	300	312	Sand - gray	1181	1230
Red	312	320	Sandy Slate	1230	1238
Slate - brown	320	335	Lime	1238	1243
Red	335	340	Sand - gray	1243	1250
Rock & Lime - white	340	351	Slate - dark	1250	1278
Lime - gray	351	365	Lime	1278	1289
Red Rock	365	395	Sand	1289	1315
Lime - gray	395	420	Sand	1315	1319
Slate - white	420	430	Slate	1319	1345
Red Rock - broken	430	460	Sand	1345	1350
Red Rock	460	480	Sand	1350	1352
Sand - gray	480	490	Slate	1352	1358
Slate - white	490	495	Lime	1358	1362
Sand	495	543	Slate - brown	1362	1392
Slate	543	545	Slate - dark	1392	1394
Lime - gray	545	550	Sand - gray	1394	1420
Slate - dark	550	554	Slate - dark	1420	1435
Lime - gray	554	584	Sand	1435	1470
Slate - brown	584	624	Slate	1470	1480
Lime - brown	624	642	Sand	1480	1510
Lime - sandy	642	660	Slate	1510	1527
Red Rock	660	725	Lime	1527	1536
Lime & Shell	725	730	Slate	1536	1545
Slate - white	730	750	Lime	1545	1560
Red Rock	750	773	Slate&Lime	1560	1588
Slate - white	773	785	Lime	1588	1602
Sand - white	785	805	Maxon	1602	1669
Slate - white	805	842	Sand	1669	1688
Slate - brown	842	860	Lime - L. lime	1688	1702
Red Rock	860	890	Slate - black	1702	1708
Lime - white	890	895	Slate - white	1708	1725
Red Rock	895	905	Sand	1725	1727

Cont'd to page #2

sample studies

Well record con'td

Permit No. Jac-114
 Company Joe Rubin, et al, Parkersburg, W. Va.
 Farm Jackson Co. Bank - Well #1
 Acres 203
 Commenced 2/19/41 - completed 7/17/41

Sandy Lime	1727	1737	
-Big Lime	1737	1832	
-Sand	1832	1845	
-Injun	1845	1922	
Slate	1922	1923	
-Sand - (SQUAW)	1923	1966	
Lime	1966	2024	
Slate	2024	2053	
Lime	2053	2065	
Slate - white	2065	2120	
Slate	2120	2150	
Lime	2150	2210	
Slate - brown	2210	2272	
-Coffee Shale	2272	2303	S.L.M. Correction 2303 - 2313
-Berea	2313	2318	
Lime	2318	2343	
Slate & Lime Shells	2343	2976	
Slate	2976	3018	
Slate & Shells	3018	3073	
Slate	3073	3452	
Slate & Lime Black	3452	3525	
Lime - black	3525	3608	
Slate Lime & Shells	3608	3673	
Lime - gray	3673	3679	
Slate & Shells	3679	3742	
Lime - black	3742	3832	
Shale - brown - 441	3832	3976	
Slate - black	3976	4000	
Shale	4000	4087	
Slate & Shells	4087	4482	
Slate - blue	4482	4526	
Shale & Shells	4526	4708	
Shale - brown	4708	4720	
Shale - black	4720	4752	
Shale - brown	4752	4797	
-Corniferous Lime 463	4797	4892	
Slate Break	4892	4896	
Lime	4896	4911	
-Oriskany Sand	4911	4950	
Total Depth 495		4950	

4797 4896
 615 615

 4182 4281