


1 2 3

Latitude 38 40

+ Topo. Loc.

Longitude 81 35

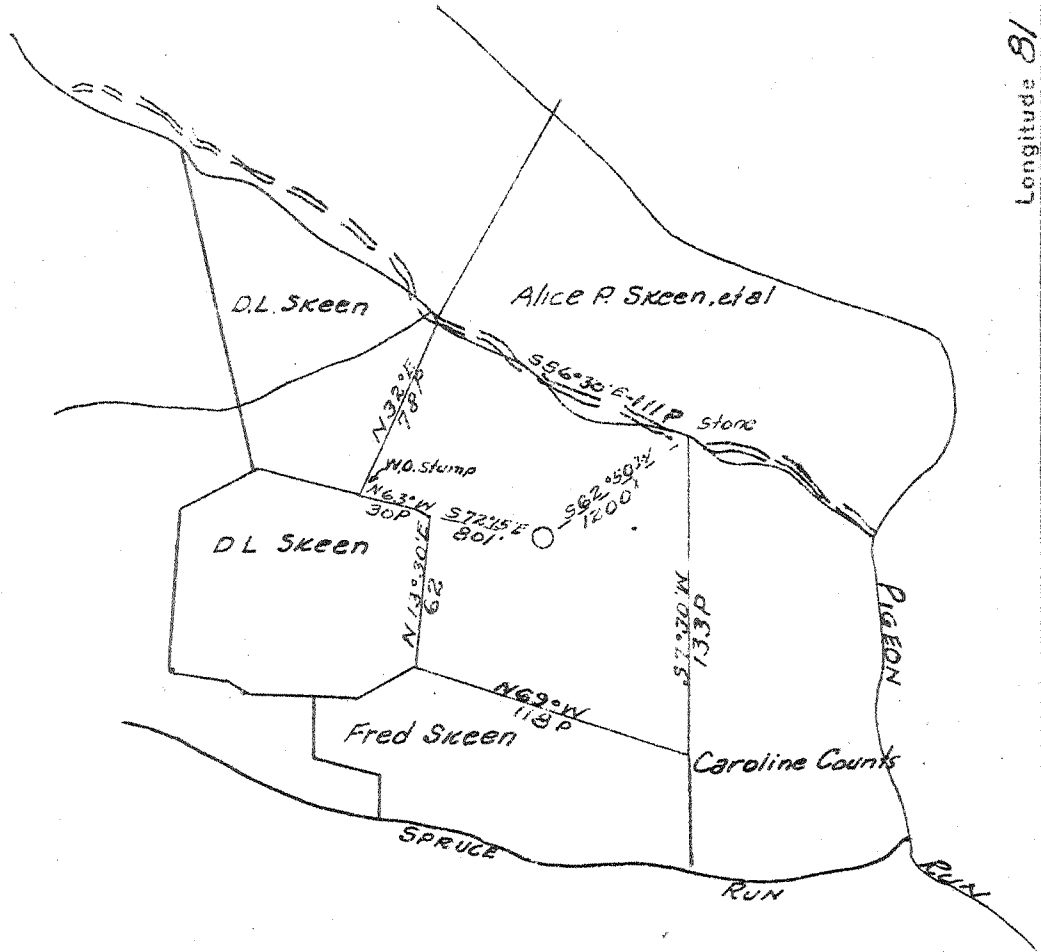

0.86 S  
 1.4 W  
 1.39-W

New Location +  
 Drill Deeper...  
 Abandonment.....

Company GODFREY L. CABOT INC.  
 Address 200 UNION BLDG CHARLESTON WVA  
 Farm A.W. SKEEN  
 Tract \_\_\_\_\_ Acres 90 Lease No. 3-426  
 Well (Farm) No. 1 Serial No. 1035  
 Elevation (Spirit Level) 995.0  
 Quadrangle KENNA C  
 County JACKSON District WASHINGTON  
 Engineer Roy Boston  
 Engineer's Registration No. \_\_\_\_\_  
 File No. \_\_\_\_\_ Drawing No. \_\_\_\_\_  
 Date 1-27-42 Scale 1" = 1320'

STATE OF WEST VIRGINIA  
 DEPARTMENT OF MINES  
 OIL AND GAS DIVISION  
 CHARLESTON

WELL LOCATION MAP  
 FILE NO. Jac-294

+ Denotes location of well on United States Topographic Maps, scale 1 to 62,500, latitude and longitude lines being represented by border lines as shown.

- Denotes one inch spaces on border line of original tracing.

6-0 192

WEST VIRGINIA DEPARTMENT OF MINES  
OIL & GAS DIVISION  
W E L L R E C O R D

Permit No. Jac<sup>o</sup> 294  
Company  
Address  
Farm  
Location  
Well No.  
District  
Surface  
Mineral  
Commenced  
Completed  
Volume  
Rock Pressure  
Fresh Water  
Salt Water  
Not shot

Godfrey L. Cabot, Inc.  
Charleston, W. Va.  
A. W. Skeon Acres ---  
---  
L Ser. 1035 Elev. 975 L  
Washington Jackson County  
---  
---  
March 11, 1942  
Aug. 27, 1942  
Dry Hole  
None  
108  
5344<sup>1</sup> -  $\frac{1}{2}$  blr. pr. hr.

Dry Hole  
CASING & TUBING  
13 3/8 154 --  
10 $\frac{1}{2}$  1046  
8 5/8 2192  
7 5225  
  
Coupling shoe -- 13 3/8  
" " -- 10 $\frac{1}{2}$   
Spang B.H. Packer, 25  
sacks aquagel.  
Special B.H. Packer,  
40 sacks aquagel (230bbbls)

Red Rock	108	108	White Slate & Shells	4432	4921
Grey Slate	108	150	Brown Shale	4921	5115
Sand	150	204	Gray Shale	5115	5144
Shells	204	297	Brown Shale	5144	5200
Red Rock	297	335	Black Shale - MARCELLUS	5200	5205
Shells	335	385	Corniferous Lime - 463	5205	5336
Red Rock	385	525	Oriskany Sand	5336	5360
Shells & Slate	525	613	Lime	5360	5373
Sand	613	635	Sand	5373	5397
Lime & Slate	635	735	Lime	5397	5437
Red Rock	735	750	TOTAL DEPTH	485	5437
Gray Slate	750	760	Gas 5342 Small show		
Red Rock	760	780			
Lime	780	796			
Slate, Lime Shells	796	886			
Red Rock	886	910			
Shale	910	984			
Lime	984	1015			
Shale	1015	1035			
Slate & Shells	1035	1060			
Sand	1060	1150			
Slate	1150	1178			
Sandy Lime	1178	1245			
Shale	1245	1265			
Lime & Shell	1265	1285			
Lime	1285	1310			
Slate & Shells	1310	1389			
Lime	1389	1404			
Shale	1404	1446			
Lime Shells & Slate	1446	1487			
Lime	1487	1507			
Slate & Shells	1507	1652			
✓ Salt Sand	1652	1952			
✓ Little Lime	1952	1966			
Slate Break - P. Cave	1966	1968			
✓ Big Lime	1968	2109			
✓ Big Injun	2109	2172			
Break	2172	2174			
Sand - squaw	2174	2182			
Slate & Shells	2182	2281			
Lime	2281	2306			
Slate & Shells	2306	2546			
✓ Brown Shale	2546	2566			
✓ Berea Grit	2566	2576			
Slate & Shells	2576	3811			
Brown Shale - 441	3811	3854			
Slate & Shells	3854	3889			
Slate & Shells	3889	3940			
Brown Shale	3940	3955			
Slate & Shells	3955	4280			
Brown Shale	4280	4388			
Brown Shale	4388	4432			

5205 5336 5397  
 975 975 975  


---

 4230 4361 4422