


Latitude 38 40

+ Topo. Location

Longitude 81 40'

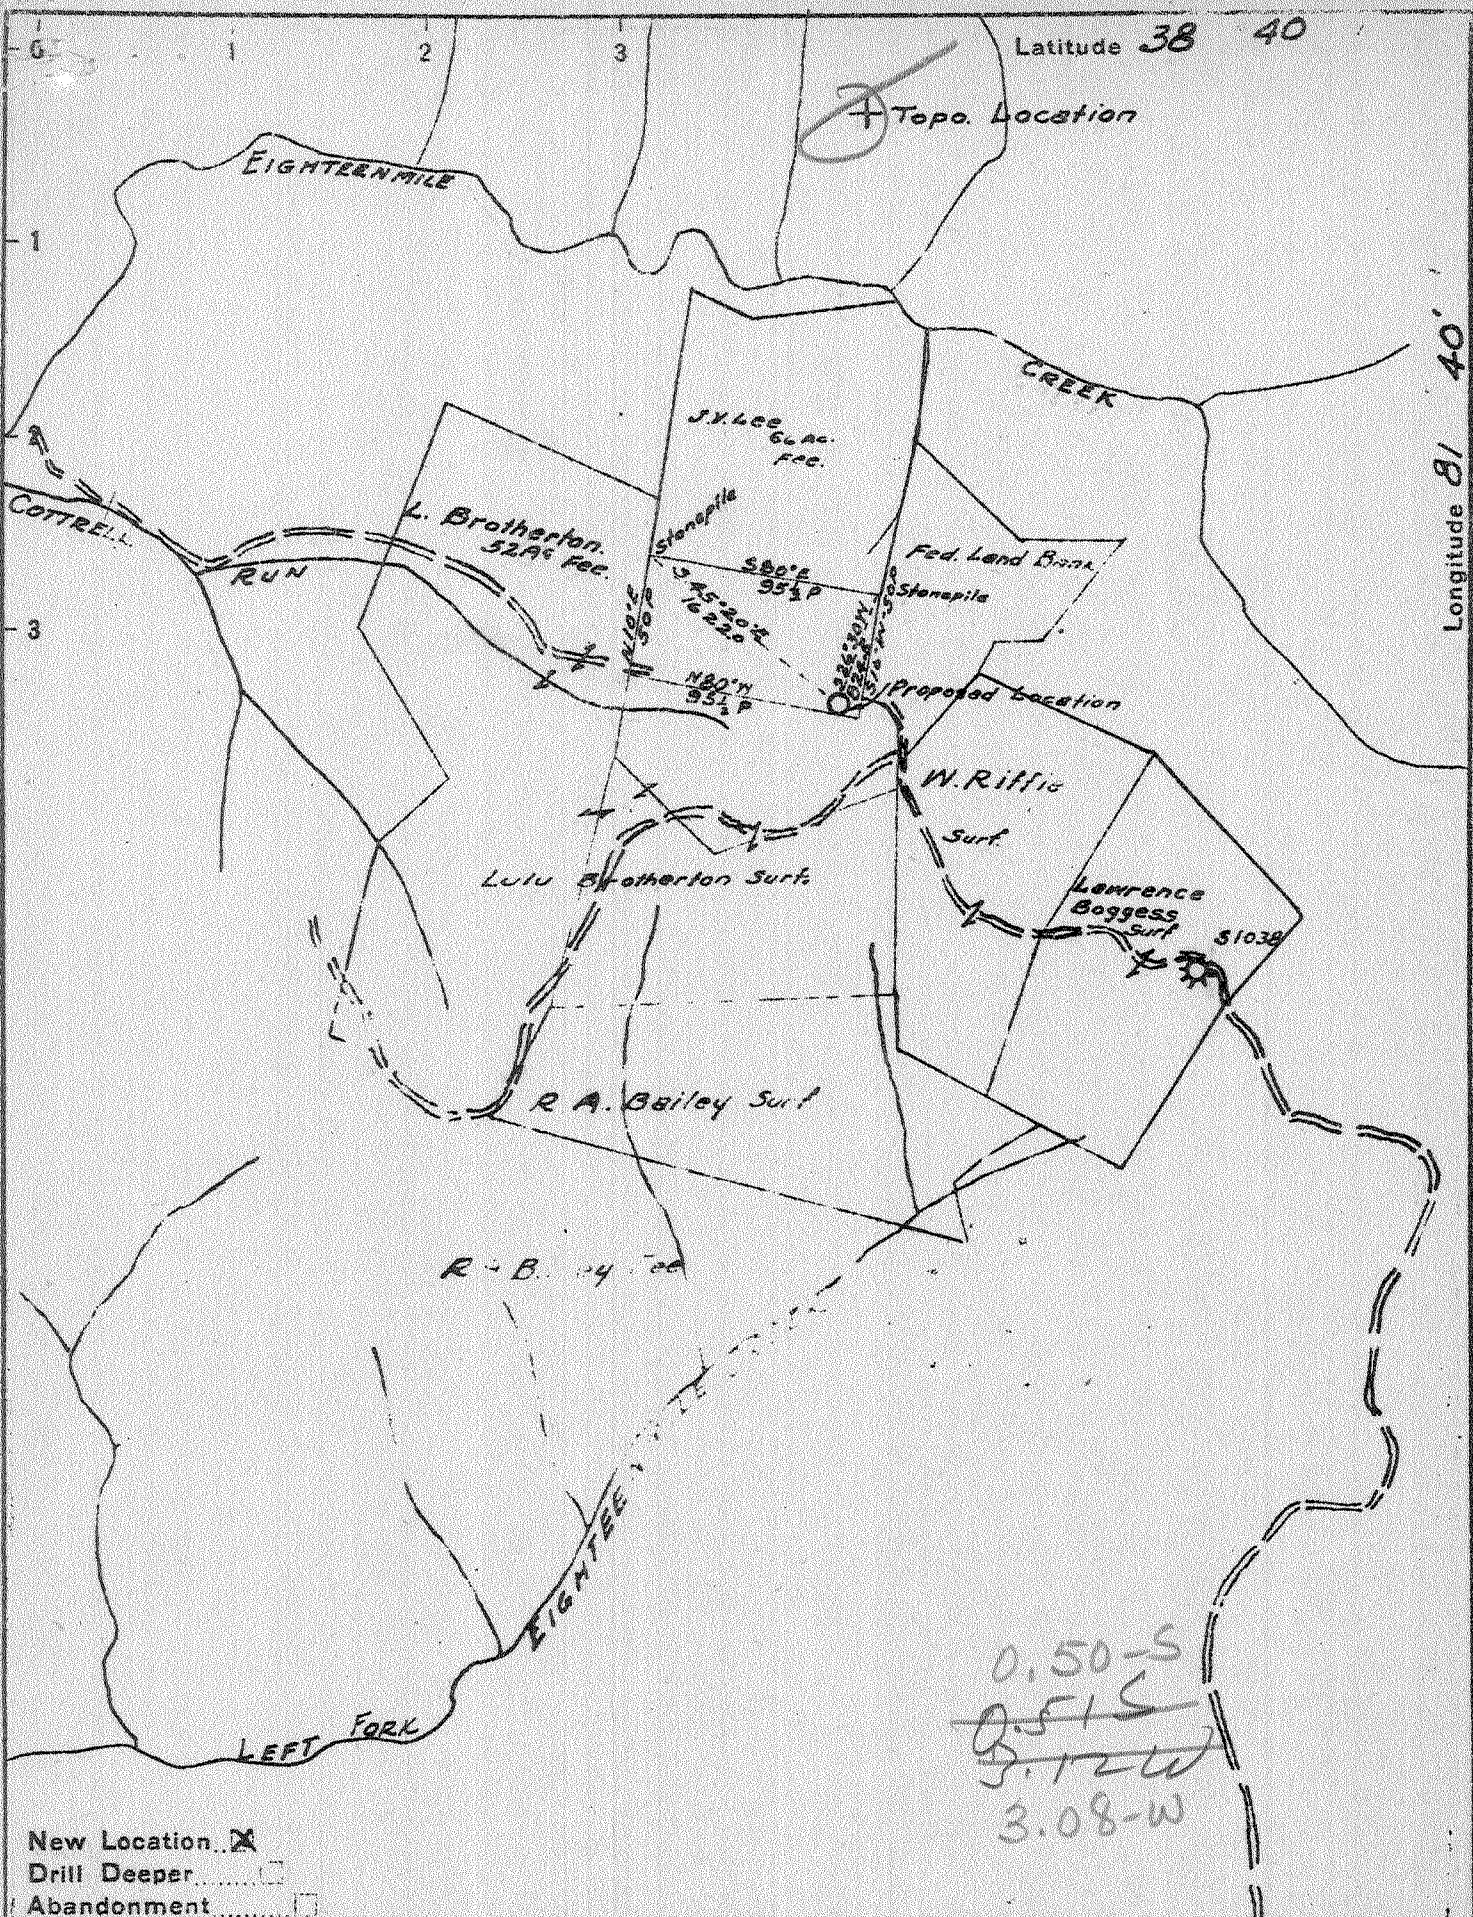

New Location X
 Drill Deeper
 Abandonment

0.50-S
 0.51-S
 3.12-W
 3.08-W

Company Godfrey L. Cabot Inc.
 Address 300 UNION BLDG CHARLESTON W. VA.
 Farm J. L. McLean Mrs
 Tract _____ Acres 160 Lease No. 3-463
 Well (Farm) No. 21 Serial No. 1061
 Elevation (Spirit Level) 961.83
 Quadrangle KENNA WC
 County JACKSON District Ripley
 Engineer Roy Boston
 Engineer's Registration No. _____
 File No. _____ Drawing No. _____
 Date 7-7-42 Scale 1"=1320'

STATE OF WEST VIRGINIA
 DEPARTMENT OF MINES
 OIL AND GAS DIVISION
 CHARLESTON

WELL LOCATION MAP
 FILE NO. Jac 385

+ Denotes location of well on United States Topographic Maps, scale 1 to 62,500, latitude and longitude lines being represented by border lines as shown.

- Denotes one inch spaces on border line of original tracing.

6-6-192

✓

WEST VIRGINIA DEPARTMENT OF MINES
OIL & GAS DIVISION
W E L L R E C O R D

Permit No. Jac 385
Kenna Quad.
Company
Address
Farm
Location
Well No
District
Surface
Mineral
Commenced
Completed
Date shot
Volume
Rock Pressure
Fresh Water
Salt Water

Godfrey L. Cabot, Inc.
Charleston, W. Va.
J.L. McLean Heirs Acres --
--
21 Ser. 1061 Elev. 961.83
Ripley Jackson County
--
--
July 23, 1942
Oct. 18, 1942
10-20-42 Depth 5164 to 5194 60 qts.
B.S. 474 M 20 Mins. A.S. 9,100 M
Oriskany Testing casing 1550#
984-94 9 bailers pr. hr.
1769 H.F.

Gas Well
CASING & TUBING

13 3/8	501	-
10 1/2	1044	1044
8 5/8	2253	-
7	5070	5070
2 3/8	5228	5228
Bottom joint welded		
10 1/2 1/2 coupling shoe		
8 5/8 Spang B.H. Packer;		
25 bags aquagel.		
7" Spec. Orisk. B.H.		
Packer; 40 bags		
aquagel; 4 bags		
17 hrs. fibertex		
Tubed and shut in 10-29-		
42		
Perf. top 5180 bot 5186		
"	"	5222 5227

Red Rock	0	30	Big Lime	2005	2143
Slate	30	40	Injun Sand	2143	2224
Red Rock	40	70	Black Slate	2224	2237
Slate	70	150	White Slate	2247	2248
Lime	150	160	Lime	2248	2258
Red Rock	160	200	Slate & Shells	2258	2628
Slate	200	220	Brown Shale	2628	2636
Lime	220	250	Derea	2636	2650
Slate	250	270	Slate & Shells	2650	3865
Red Rock	270	320	Brown Shale - 441	3865	3940
Sand	320	340	Slate & Shells	3940	4120
Red Rock	340	360	Brown Shale	4120	4243
Lime	360	400	White Slate	4243	4275
Red Rock	400	435	Brown Shale	4275	4400
Lime	435	450	White Slate	4400	4800
Red Rock	450	480	Brown Shale	4800	5030
Lime	480	494	Black Shale - MAROSELUS	5030	5050
Red Rock	494	508	Corniferous Lime - 463	5050	5162
Lime	508	535	Sand - Oriskany	5162	5203
Red Rock	535	545	Lime	5203	5210
Lime	545	600	Sand	5210	5226
Slate & Shells	600	700	Lime	5226	5232
Red Rock	700	750	TOTAL DEPTH	5232	5232 SLM
Slate & Shells	750	800	Gas 2144 No test		
Sand	800	850	Gas show 3867		
Red Rock	850	875	Gas 4323 Show		
Slate & Shells	875	910	GAUGES IN ORISKANY SAND B.S.		
Sand	910	930	5164-67	421 M	
Slate	930	960	5167 B. Drlg.	94 M	
Red Rock	960	982	5170	1,087 M	
Sand	982	1005	5171	3,133 M	
Slate	1005	1018	5172	3,085 M	
Lime, Gritty	1018	1050	5176	1,090 M	
Slate	1050	1110	5177	771 M	
Sand	1110	1170	5180	668 M	
Slate & Shells	1170	1223	5184	1,090 M	
Sand	1223	1254	5188	1,220 M	
Slate	1254	1320	5189	771 M	
Sand	1320	1333	5202	531 M	
Coal	1333	1336	5212-5228	444 M	
Slate	1336	1377	5232	335 M	
Sand	1377	1420	GAUGES IN ORISKANY A.S.		
Slate & Shells	1420	1585	Gauges B.S.	474 M	
Lime	1585	1610	5 Mins. A.S.	10,170 M	
Slate & Shells	1610	1760	10 " "	9,100 M	
Salt Sand	1760	1960	15 " "	9,100 M	
Slate	1960	1964	20 " "	9,100 M	
Salt Sand	1964	1975	Producing Sand Record		
Little Lime	1975	1996	Oriskany 5164 to 5171	3,133 MCF	Net gauge
White Slate	1996	2006	" 5180 5188	552 MCF	