


B-7 93

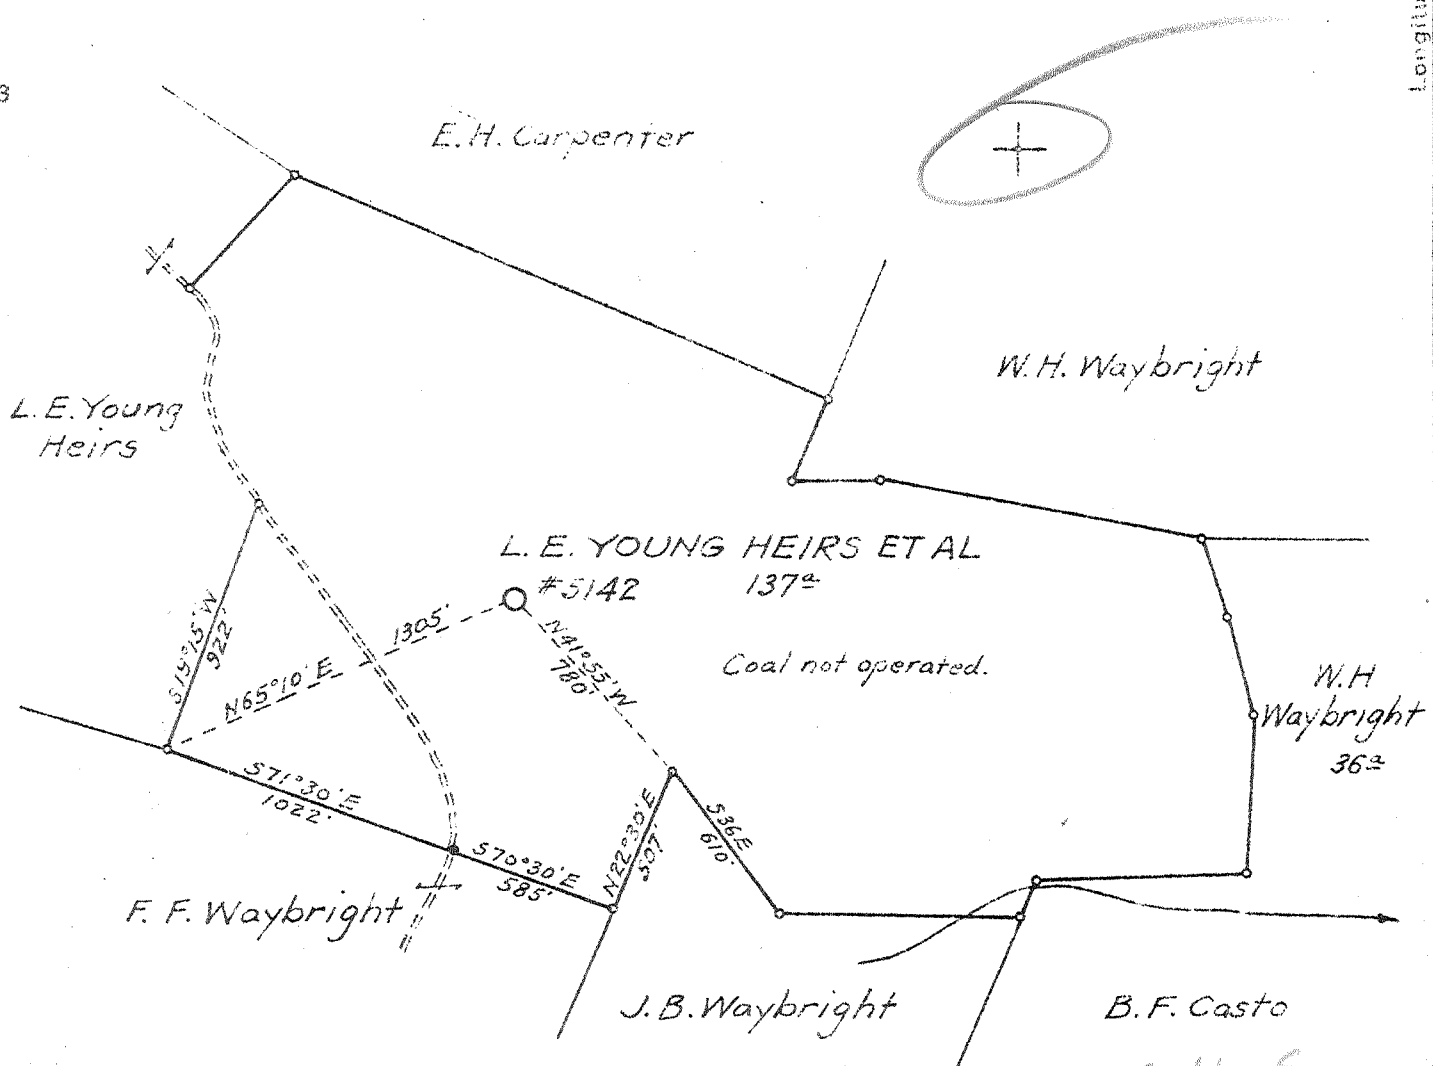

3.46-S
~~3.5 S~~
~~2.15 W~~
 2.13-W

New Location X
 Drill Deeper
 Abandonment

Company	UNITED FUEL GAS CO.
Address	CHARLESTON, W.VA.
Farm	L. E. YOUNG HEIRS ET AL
Tract	Acres 137 Lease No. 41664
Well (Farm) No.	1 Serial No. 5142
Elevation (Spirit Level)	892
Quadrangle	RIPLEY 52
County	JACKSON District WASHINGTON
Engineer	
Engineer's Registration No.	659
File No.	62-89 Drawing No.
Date	AUG. 21, 1942 Scale 1" = 660'

STATE OF WEST VIRGINIA
 DEPARTMENT OF MINES
 OIL AND GAS DIVISION
 CHARLESTON

WELL LOCATION MAP
 FILE NO. J.A.C. 398

+ Denotes location of well on United States Topographic Maps, scale 1 to 62,500. Latitude and longitude lines being represented by border lines as shown.
 - Denotes one inch spaces on border line of original tracing.

60-192

WEST VIRGINIA DEPARTMENT OF MINES
OIL & GAS DIVISION
W E L L R E C O R D

Permit No. Jac 398
Ripley Quad.

Dry Hole
CASING & TUBING

Company	United Fuel Gas Company			
Address	Charleston, W.Va.	13	711	Pulled
Farm	L.E. Young Hrs. et al Acres 137	10	1450	1450
Location	Elk Fork of Mill Creek	85/8	2181	2181
Well No	5142 Elev. 895.43	7	5142	5142
District	Washington Jackson County			
Surface	T.F. Yeung et al, Ripley, W.Va.			
Mineral	Same			
Commenced	Sept. 24, 1942			
Completed	Jan. 16, 1943			
Not shot				
Volume	Dry Hole			
Fresh water	1410' 2 blrs. hr.			
Salt Water	1700 & 1810 H.F.; 5281' 1/2 blr. pr.hr.			

Sand	0	21	
Red Rock	21	205	
Sand	205	230	
Slate	230	250	
Red Rock	250	300	
Sand	300	340	
Slate	340	375	
Red Rock	375	450	
Slate & Shells	450	584	
✓ Pitts. Sand	584	655	
Slate & Shells	655	790	
Red Rock	790	845	
Slate & Shells	845	875	
Red Rock	875	925	
Slate	925	1000	
Red Rock	1000	1025	
Lime shells	1025	1183	
- Dunkard - Big Dunkard	1183	1245	
Slate	1245	1251	
Sand	1251	1280	
Slate	1280	1310	
Sand	1310	1395	
Slate	1395	1401	
Sand	1401	1420	
Blk. Slate	1420	1445	
Sand	1445	1535	
Blk. Shale	1535	1750	
Slate	1750	1790	
✓ Salt Sand	1790	1958	
✓ Big Lime	1958	2095	
✓ Injun	2095	2151	
Slate & Shells	2151	3790	
✓ Brown Shale - 441	3790	3840	
Slate	3840	4150	
Brown Shale	4150	4200	
Gray Shale	4200	4263	
Brown Shale	4263	4400	
White Slate	4400	4805	
Brown Shale	4805	4890	
Gray Shale	4890	5075	
✓ Black Shale - MARCELLUS	5075	5149	
✓ Corniferous Lime - 463	5149	5267	
✓ Oriskany	5267	5312	
Gray Sand	5312	5316	Gas 5281 show
✓ Lime - Held	5316	5320	
TOTAL DEPTH		5320	

485