
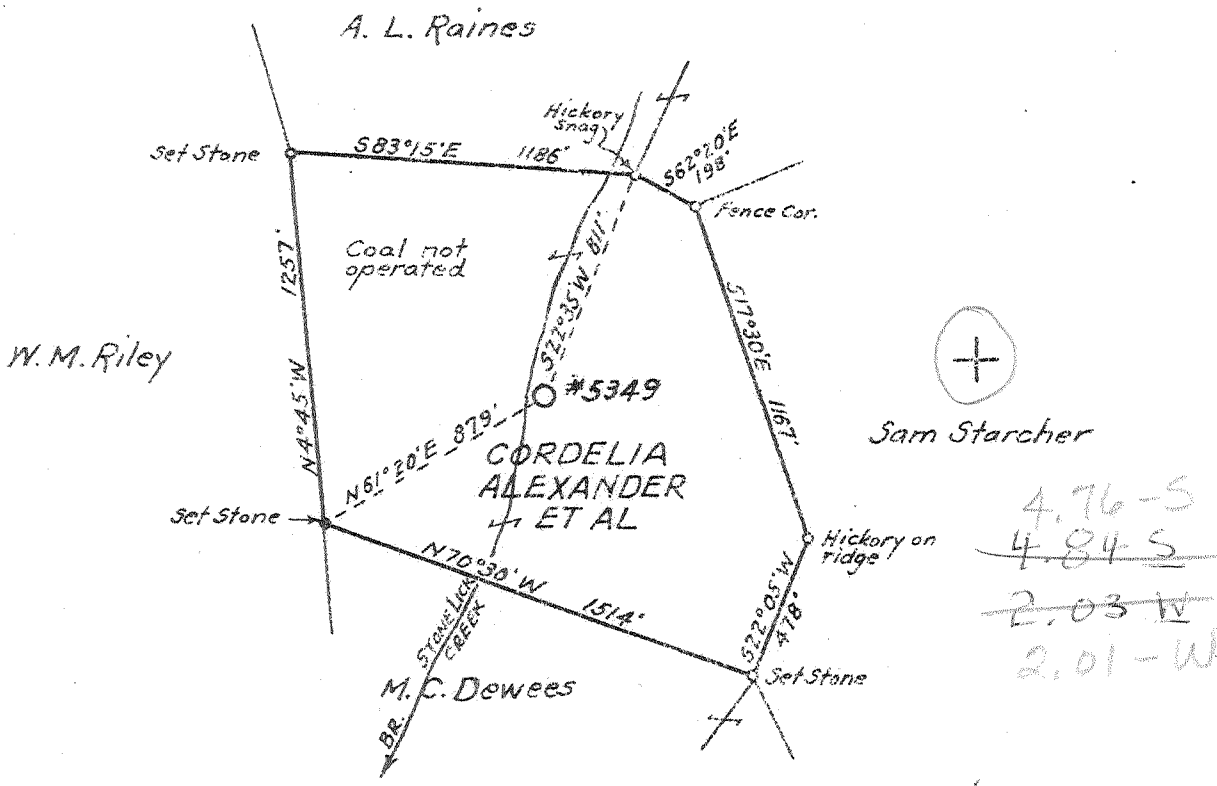


P

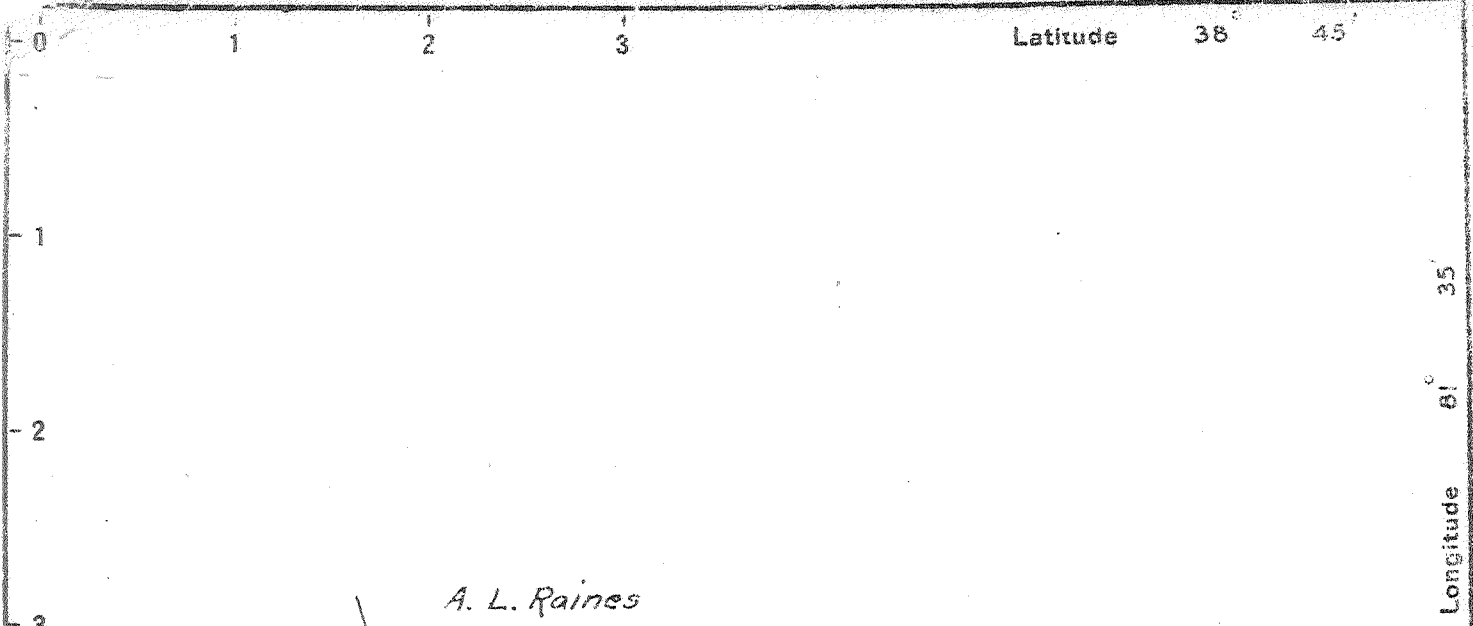

New Location
 Drill Deeper
 Abandonment

Company UNITED FUEL GAS CO.
 Address CHARLESTON, W.VA.
 Farm CORDELIA ALEXANDER ET AL
 Tract _____ Acres 49 Lease No. 40912
 Well (Farm) No. 1 Serial No. 5349
 Elevation (Spirit Level) 787.
 Quadrangle KENNA - NC
 County JACKSON District RIPLEY
 Engineer G.A. Cunningham
 Engineer's Registration No. 659
 File No. 62-81 Drawing No. _____
 Date NOV. 24, 1943 Scale 1" = 660'

STATE OF WEST VIRGINIA
 DEPARTMENT OF MINES
 OIL AND GAS DIVISION
 CHARLESTON

WELL LOCATION MAP
 FILE NO. JAC-467

+ Denotes location of well on United States Topographic Maps, scale 1 to 62,500, latitude and longitude lines being represented by border lines as shown.

- Denotes one inch spaces on border line of original tracing.

6-6-1942 Deep Well

WEST VIRGINIA DEPARTMENT OF MINES
OIL & GAS DIVISION
W E L L R E C O R D

Permit No. Jac 467
Kenna Quad.

Gas Well
CASING & TUBING

Company	United Fuel Gas Company			
Address	Box 1273, Charleston, W.Va.	16	40	40
Farm	Cordelia Alexander et al Acres 49	13	582	Pulled
Location	Stone Lick Creek	10	1060	Pulled
Well No	5349 Elev. 787	8½	2025	2025
District	Ripley Jackson County	6 5/8	5033	5033
Surface	Cordelia Alexander et al, Kenna, W.Va.	2		5159
Mineral	Same			
Commenced	January 12, 1944			
Completed	May 3, 1944			
Not shot				
Volume	Gas Well <i>2,363 Mcf gas</i>			
Fresh Water	45' 5 blrs.			
Salt Water	1592' H.F.			

Surface Soil	0	10	Oriskany Sand	5120	5159
Slate	10	30	TOTAL DEPTH	<i>475</i>	5159
Red Rock	30	40			
Slate	40	46	Gas 5144-5151	Oriskany	
Sand	46	109			
Slate	109	120			
Red Rock	120	198			
Slate & Shells	198	232			
Sand	232	280			
Red Rock	280	310			
Slate	310	357			
Red Rock	357	390			
Slate	390	475			
Sand	475	537			
Slate	537	540			
Red Rock	540	555			
Slate	555	582			
Red Rock	582	640			
Slate	640	700			
Lime	700	715			
Slate	715	745			
Red Rock	745	865			
Slate	865	938			
Sand	938	958			
Red Rock	958	977			
Sand	977	1045			
Slate	1045	1083			
Sand	1083	1145			
Slate & Shells	1145	1185			
Sand	1185	1232			
Slate	1232	1370			
Sand	1370	1390			
Slate & Shells	1390	1440			
Sand	1440	1490			
Slate	1490	1555			
Salt Sand	1555	1680			
Black Lime	1680	1690			
Salt Sand	1690	1781			
Big Lime	1781	1954			
Big Injun	1954	2016			
Slate	2016	2025			
Lime Shell	2025	2030			
Slate & Shells	2030	2408			
Berea Grit	2408	2415	Gas 2409	Small show in Berea	
Slate & Shells	2415	3550			
Lime	3550	3555			
Slate & Shells	3555	3675			
Brown Shale - 441	3675	3715			
Slate & Shells	3715	3875			
Brown Shale	3875	4265			
White Slate	4265	4697			
Shale	4697	4983			
Black Slate - MARCELLUS	4983	5016			
Corniferous Lime - 463	5016	5120			

5016 5120
787 787
229 4333