

WW-7
8-30-06



West Virginia Department of Environmental Protection
Office of Oil and Gas

WELL LOCATION FORM: GPS

API: 47-035-00574 WELL NO.: 5

FARM NAME: Charles and Linda Ankrum

RESPONSIBLE PARTY NAME: Exco Resources

COUNTY: Jackson DISTRICT: Ravenswood

QUADRANGLE: Sandyville

SURFACE OWNER: Charles and Linda Ankrum

ROYALTY OWNER: Blanch Ashcraft et al

UTM GPS NORTHING: 4308925.00 m

UTM GPS EASTING: 437143.00 m GPS ELEVATION: 597 FT (182.57m)

The Responsible Party named above has chosen to submit GPS coordinates in lieu of preparing a new well location plat for a plugging permit or assigned API number on the above well. The Office of Oil and Gas will not accept GPS coordinates that do not meet the following requirements:

1. Datum: NAD 1983, Zone: 17 North, Coordinate Units: meters, Altitude: height above mean sea level (MSL) – meters.
2. Accuracy to Datum – 3.05 meters
3. Data Collection Method:

Survey grade GPS : Post Processed Differential
Real-Time Differential

Mapping Grade GPS : Post Processed Differential
Real-Time Differential

Received

APR 21 2014

Office of Oil and Gas
WV Dept. of Environmental Protection

4. Letter size copy of the topography map showing the well location.

I the undersigned, hereby certify this data is correct to the best of my knowledge and belief and shows all the information required by law and the regulations issued and prescribed by the Office of Oil and Gas.


[Signature] construction specialist 4-21-14
Signature Title Date

35005746
35-574P

FORM WW-9

RECEIVED
Office of Oil & Gas
MAR. 16 2001
WV Division of
Environmental Protection

B. ASHCRAFT LEASE WELL NO. 3 (API #47-035-0574)

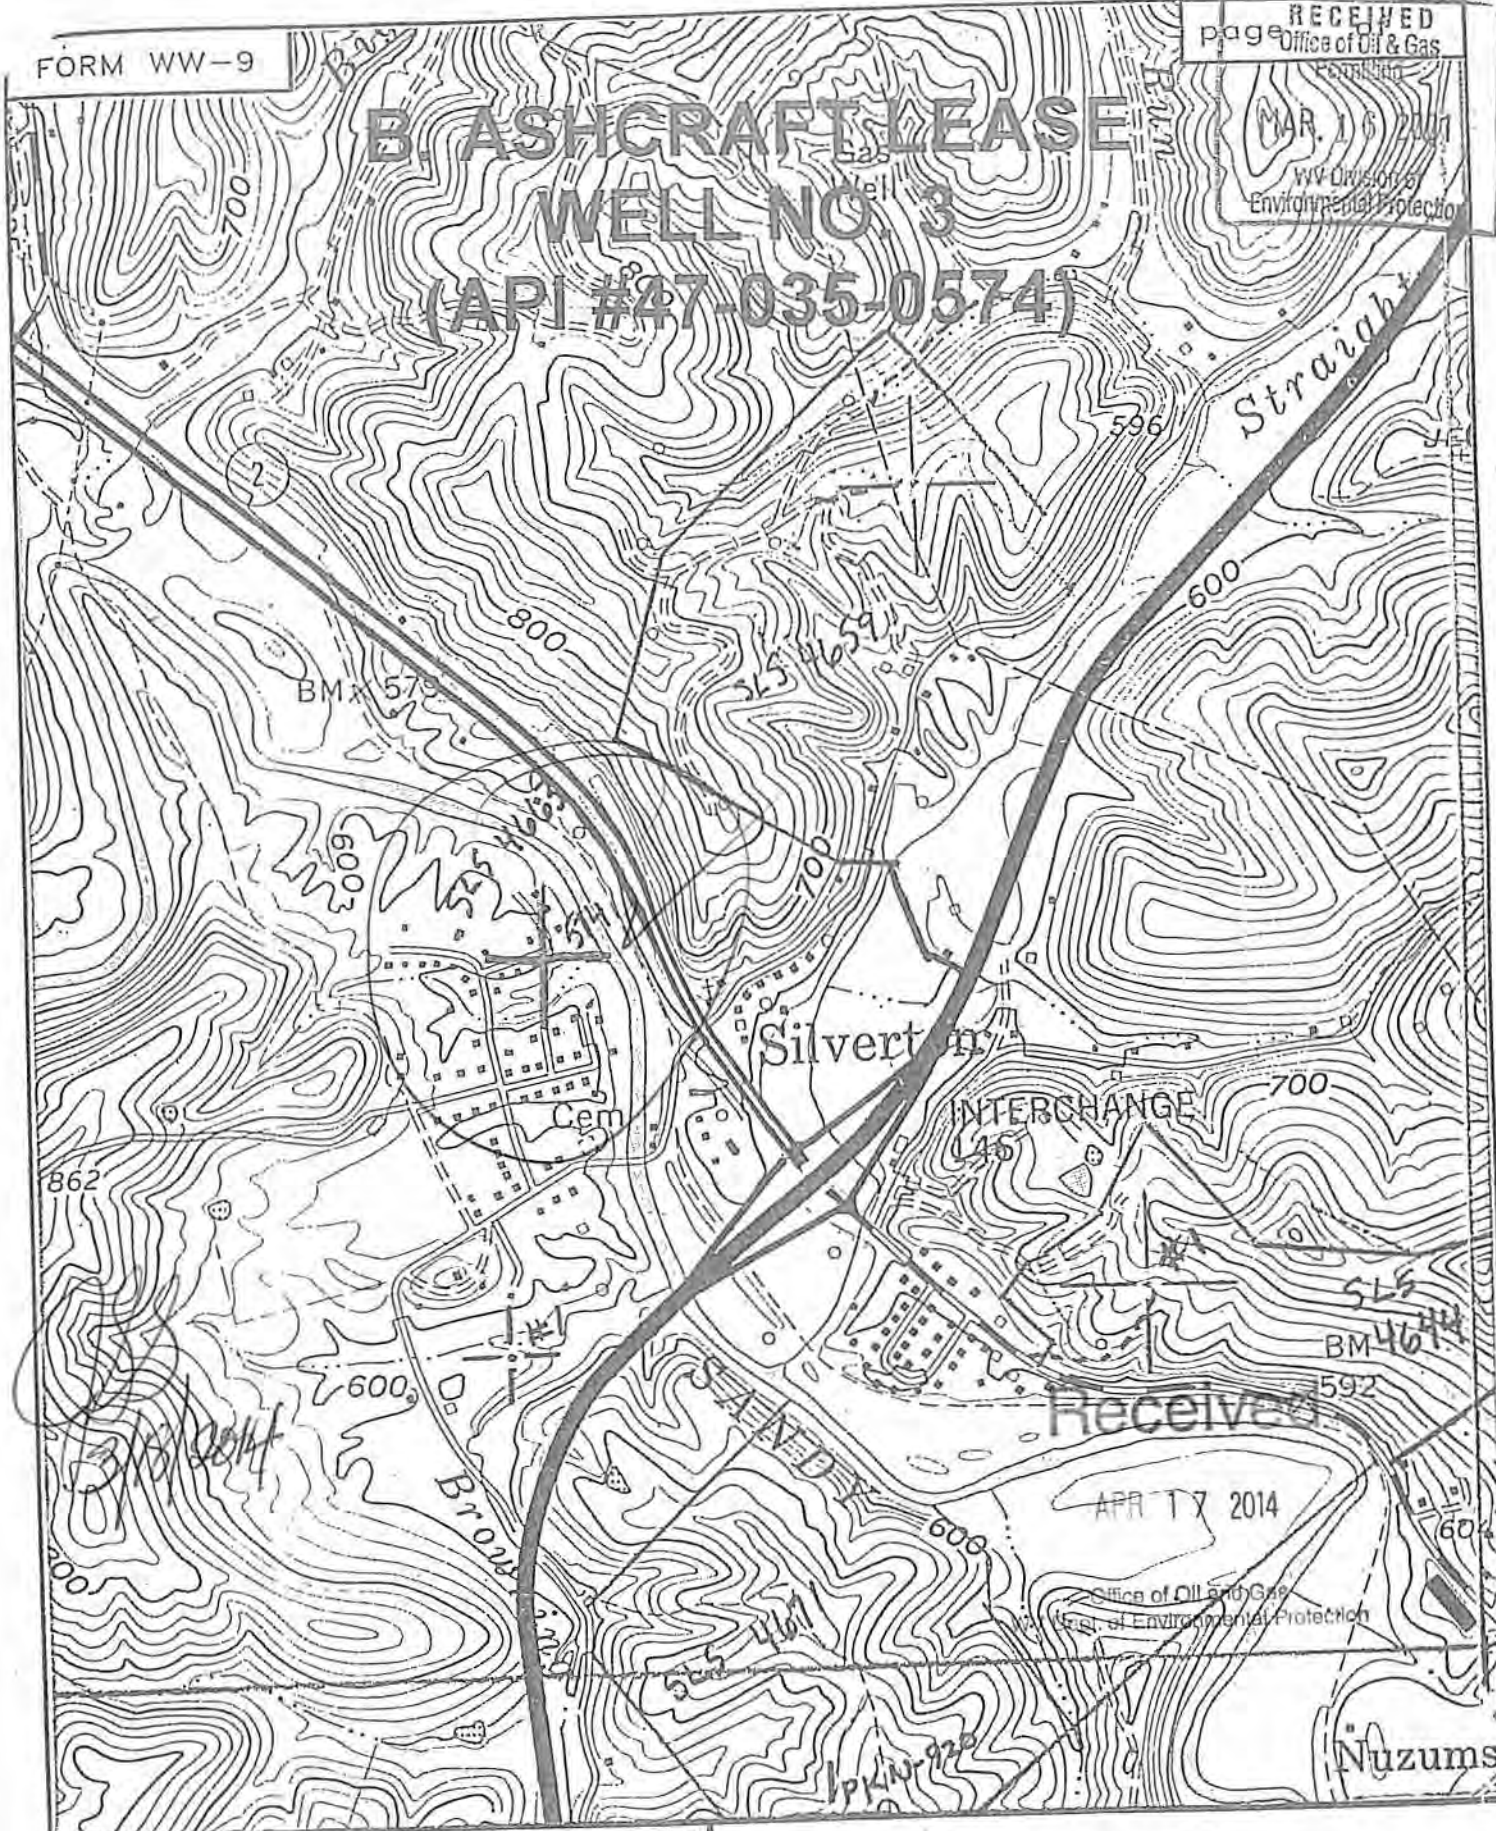

Handwritten signature

Received

APR 17 2014

Office of Oil and Gas
WV Dept. of Environmental Protection

SLS

SMITH LAND SURVEYING
P.O. BOX 150 GLENVILLE, WV. 26351

TOPO SECTION OF Sandyville 7.5'

FILE NO. 4663 DATE 2/27/01 SCALE 1"=1000'