

4.13 S.
2.84 W.

950 (H-5)

New Location
 Drill Deeper
 Abandonment

Company LYNN OIL & GAS CO.
 Address RIPLEY, W. VA.
 Farm J. T. PHILLIPS
 Tract _____ Acres 147.5 Lease No. _____
 Well (Farm) No. 2 Serial No. _____
 Elevation (Spirit Level) 825.00
 Quadrangle RIPLEY - SW
 County JACKSON District RIPLEY
 Engineer L. J. Dye
 Engineer's Registration No. 804
 File No. _____ Drawing No. _____
 Date 4-1-55 Scale 1" = 40 POLES

STATE OF WEST VIRGINIA
 DEPARTMENT OF MINES
 OIL AND GAS DIVISION
 CHARLESTON

WELL LOCATION MAP
 FILE NO. JAC-891

+ Denotes location of well on United States Topographic Maps, scale 1 to 62,500, latitude and longitude lines being represented by border lines as shown.
 - Denotes one inch spaces on border line of original tracing.

66-192 Deep Well



STATE OF WEST VIRGINIA
DEPARTMENT OF MINES
OIL AND GAS DIVISION 6

Quadrangle Ripley
Permit No. 891

WELL RECORD

Oil or Gas Well Gas
(KIND)


Company Lynn Gas Company
Address Ripley, W.V.
Farm J.T. Phillips Acres 147.5
Location (waters) Parcelment
Well No. 2 Elev. 825
District Ripley County Jackson
The surface of tract is owned in fee by J.T. Phillips
Address Ripley, W.Va
Mineral rights are owned by J.T. Phillips & others
Address Ripley, W.Va
Drilling commenced 1-12-55
Drilling completed 7-12-55
Date Shot 7-28-55 From 1050 To 1250
With 2400 lb Gelatin
Open Flow 100 10ths Water in 2" Inch
421,000 10ths Merc. in 21 Inch
Volume 700 Cu. Ft.
Rock Pressure 700 lbs. 21 hrs.
Oil 300 bbls., 1st 24 hrs.
Fresh water 1750 feet
Salt water 1750 feet

Casing and Tubing	Used in Drilling	Left in Well	Packers
Size			Kind of Packer
16			
13	21ft		
10	746"	pulled out	Size of
8 1/4	1125	"	
6 1/2	2141	left in	Depth set
5 3/16			
3			Perf. top
2			Perf. bottom
Liners Used			Perf. top
			Perf. bottom

CASING CEMENTED _____ SIZE _____ No. Ft. _____ Date _____

COAL WAS ENCOUNTERED AT _____ FEET _____ INCHES
_____ FEET _____ INCHES _____ FEET _____ INCHES
_____ FEET _____ INCHES _____ FEET _____ INCHES

Formation	Color	Hard or Soft	Top	Bottom	Oil, Gas or Water	Depth Found	Remarks
Sand	White	Hard	00	5			
Red Rock	Red	"	5	40			
Sand	white	"	40	125			
Red rock	red	"	125	200			
Slate	white	Soft	200	300			
Sand	White	Hard	300	350			
red rock	red	"	350	390			
blue slate	blue	soft	390	410			
red rock	red	hard	410	450			
blue lime	blue	hard	450	460			
slate	white	soft	460	500			
red rock	red	hard	500	510			
slate	white	soft	510	545			
red rock	red	hard	545	565			
blue lime	blue	hard	565	615			
slate	white	soft	615	706			
sand	white	hard	706	716			
blue mud	blue	soft	716	720			
sand	white	hard	720	731			
slate	white	soft	731	748			
red rock	red	hard	748	795			
slate	white	soft	795	825			
red rock	red	hard	825	850			
slate	white	soft	850	860			
sand	white	hard	860	900			
slate	white	soft	900	993			
sand	white	hard	993	1008			
redrock	red	hard	1008	1015			
gray slate	soft	soft	1015	1155			
sand	white	hard	1155	1259			
slate	white	soft	1259	1285			
lime	white	hard	1285	1305			
sand	white	hard	1305	1390			
slate	white	soft	1390	1402			
sand	white	hard	1402	1427			
slate	white	soft	1427	1480			
sand	white	hard	1480	1490			
slate	"	soft	1490	1635			

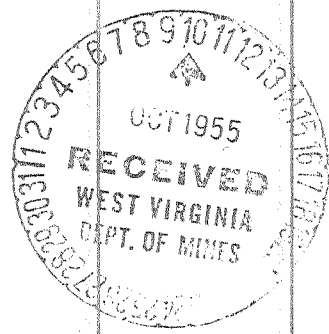

Formation	Color	Hard or Soft	Top 6	Bottom	Oil, Gas or Water	Depth Found	Remarks
black slate	black	soft	1635	1650			
slate	white	soft	1650	1722			
sand	white	hard	1722	1835			
slate	white	soft	1835	1845			
sand	white	hard	1845	1910			
big lime	white	hard	1910	2043			
slate ³⁴⁰	white	soft	2043	2080			
sand-Inj	white	hard	2080	2145			
slate	white	soft	2145	2155			
dark lime	dark	hard	2155	2195			
slate	white	soft	2195	2490			
brown shale	brown	soft	2490	2520	Sunbury		
sand	white	hard	2520	2532			
slate shells	white	soft	2532	3735			
brown shale	brown	soft-441	3735	3815			
slate	white	soft	3815	3990			
brown shale	brown	soft	3990	4100			
slate shells	white	hard	4100	4150			
brown shale	brown	soft	4150	4280			
slate shells	white	soft	4280	4615			
brown shale	brown	soft	4615	4914			
lime-463	white	hard	4914	5012			
criskany sand		hard	5012	5036			
lime ⁴⁸⁵	white	hard	5036	5039			
Total Depts.				5039			

4914 5012 5036

APPROVED C. M. Reynolds Date 10-7, 1955, Owner