

New Location...
 Drill Deeper.....
 Abandonment.....

Company B.H. Putnam (operator)
 Address Box 697 Marietta Ohio
 Farm Roy Kirkhart
 Tract _____ Acres 70 Lease No. _____
 Well (Farm) No. 1 Serial No. _____
 Elevation (Spirit Level) 872'
 Quadrangle Belleville - SW
 County Jackson District Grant
 Engineer Robert R. Anderson
by O. Meredith
 Engineer's Registration No. 296
 File No. _____ Drawing No. _____
 Date June 8 55 Scale 1 in = 30 Poles

STATE OF WEST VIRGINIA
 DEPARTMENT OF MINES
 OIL AND GAS DIVISION
 CHARLESTON

WELL LOCATION MAP
 FILE NO. JAC-898

+ Denotes location of well on United States Topographic Maps, scale 1 to 62,500, latitude and longitude lines being represented by border lines as shown.

- Denotes one inch spaces on border line of original tracing.

66 Neptune 255

Deep Well ✓



STATE OF WEST VIRGINIA
DEPARTMENT OF MINES
OIL AND GAS DIVISION 7

WELL RECORD

Quadrangle Pellsville

Permit No. JAC - 898

Oil or Gas Well Gas
(KIND)


Company B. H. Putnam, Operator
Address 512 Third Street, Marietta, Ohio
Farm Roy Kirkhart Acres 70
Location (waters) Ohio River
Well No. 1 Elev. 872
District Grant County Jackson
The surface of tract is owned in fee by Roy Kirkhart
Address _____
Mineral rights are owned by Roy Kirkhart
Address _____
Drilling commenced 6-10-55
Drilling completed 8-17-55
Date Shot 8-26-55 From _____ To _____
With 1000# Explosive "B"
Open Flow _____ /10ths Water in _____ Inch
_____ /10ths Merc. in _____ Inch
Volume 738,000 Cu. Ft.
Rock Pressure _____ lbs. _____ hrs.
Oil none bbls., 1st 24 hrs.
Fresh water none feet _____ feet
Salt water none feet _____ feet

Casing and Tubing	Used in Drilling	Left in Well	Packers
Size <u>18</u>	<u>18</u>	<u>18</u>	
<u>16</u>	<u>65</u>	<u>65</u>	Kind of Packer
<u>13</u>	<u>735</u>		<u>Gas Anchor</u>
<u>10</u>	<u>1100</u>		Size of <u>8"</u>
<u>8 1/4</u>	<u>1746</u>		
<u>6 5/8</u>			Depth set _____
<u>5 1/16</u>	<u>4394</u>	<u>319</u>	
<u>3</u>	<u>2219</u>	<u>2219</u>	Perf. top _____
<u>2</u>			Perf. bottom _____
Liners Used _____			Perf. top _____
			Perf. bottom _____

CASING CEMENTED 5 1/8 SIZE 300 No. Ft. 804-55 Date

COAL WAS ENCOUNTERED AT none FEET _____ INCHES _____
FEET _____ INCHES FEET _____ INCHES
FEET _____ INCHES FEET _____ INCHES

Formation	Color	Hard or Soft	Top	Bottom	Oil, Gas or Water	Depth Found	Remarks
rock	red		0	30			
sand			30	40			
slate			40	45			
rock	red		45	125			
slate			125	165			
rock	red		165	187			
sand			187	190			
rock	red		190	230			
slate	230		230	260			
rock	red		260	285			
slate			285	290			
sand			290	360			
slate			360	365			
rock	red		365	380			
lime			380	389			
sand			389	405			
rock	red		405	435			
sand			435	450			
rock	red		450	485			
sand			485	495			
rock	red		495	500			
slate			500	530			
rock	red		530	540			
slate			540	545			
sand			545	570			
slate			570	580			
sand			580	615			
slate & shells			615	710			
sand			710	726			
slate			726	745			
rock	red		745	865			
slate & lime shells			865	1042			
rock	yellow		1042	1050			
slate & shells			1050	1072			
lime			1072	1097			
sand			1097	1153			

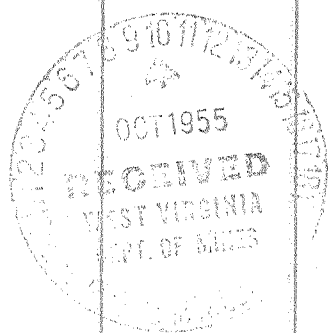

Formation	Color	Hard or Soft	Top ⁷	Bottom	Oil, Gas or Water	Depth Found	Remarks
slate & shells			1158	1255			
sand			1255	1320			
slate & shells			1320	1332			
sand			1332	1412			
slate & shells			1412	1455			
sand			1455	1465			
slate & shells			1465	1580			
sand			1580	1595			
slate			1595	1660			
lime - <i>Biglone</i>			1660	1746			
slate & shells			1746	2170			
shale - <i>Coffee St.</i>			2170	2190			
Berea sand			2190	2193			
slate & shells			2193	3309			
shale & lime			3309	3320			
shale	brown	441	3320	3815			
slate	white		3815	4115			
shale	brown		4115	4328			
lime - <i>Huntersville</i>		463	4328	4487			
sand - <i>ORISKANY</i>			4487	4498			
plugged back to Berea zone			2225				

~~475~~
 475
 4328 4487
 872 872

 3456 3615

Date October 8, 1955

APPROVED B.H. Putnam, Operator, Owner

By B.H. Putnam, Jr., Supt
 (Title)
by E. Embrey