


LAMP



New Location..
 Drill Deeper.....
 Abandonment.....

2.04-S
~~2.07-S~~
~~3.64-W~~
 3.65-W
 9 WC (G5)

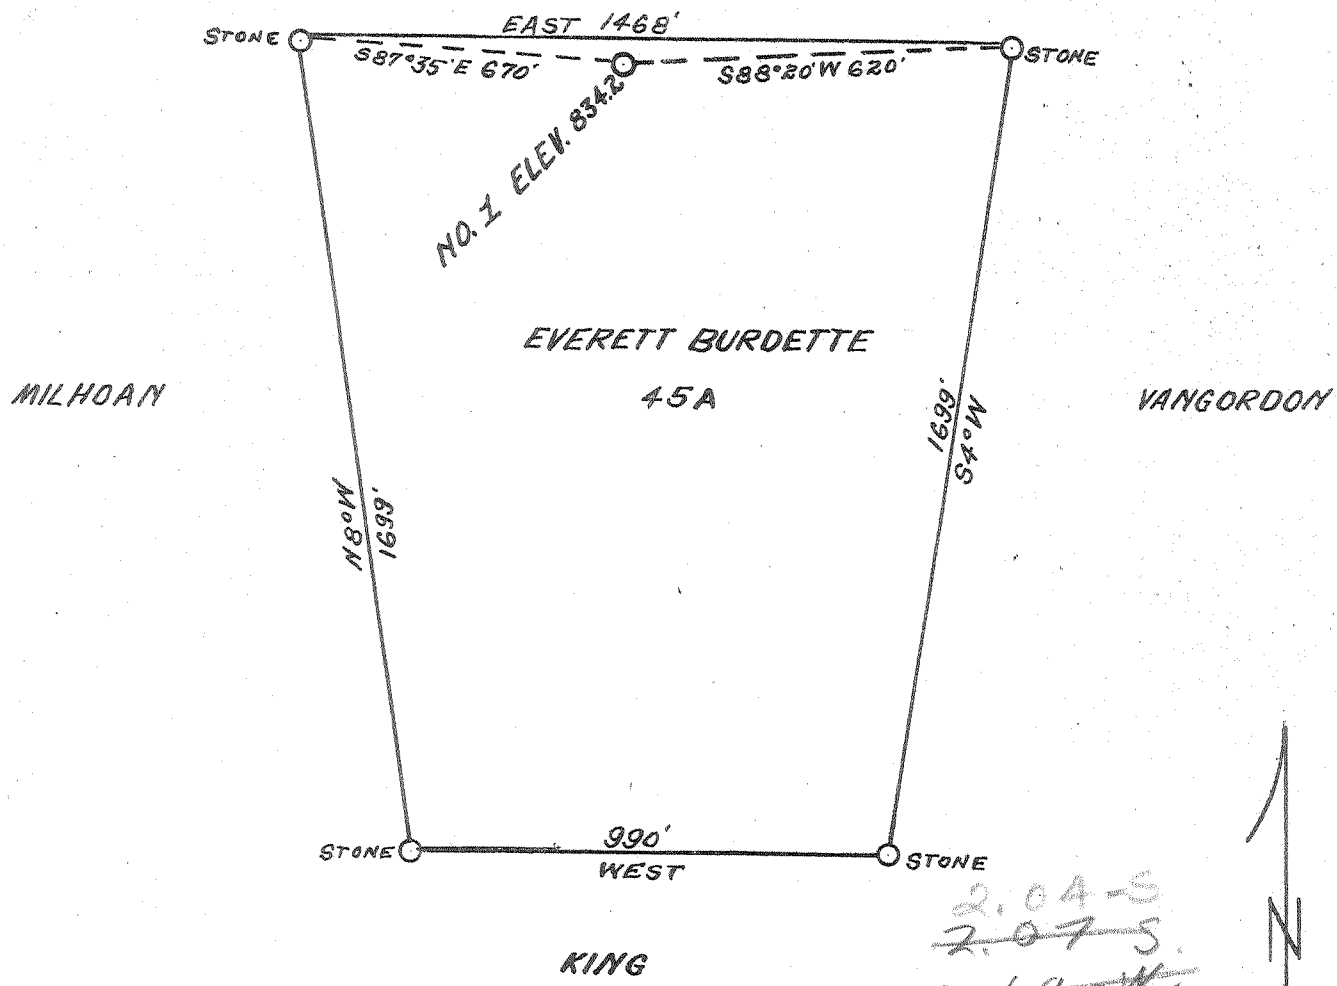

Company D. D. FOSTER
 Address PITTSBURGH, PA.
 Farm EVERETT BURDETTE
 Tract _____ Acres 45 Lease No. _____
 Well (Farm) No. 1 Serial No. _____
 Elevation (Spirit Level) 834.2
 Quadrangle BELLEVILLE - SW
 County JACKSON District GRANT
 Engineer Donald W. Morris
 BY J. F. DEEM
 Engineer's Registration No. 1653
 File No. _____ Drawing No. _____
 Date JUNE 20, 1955 Scale 1" = 400'

STATE OF WEST VIRGINIA
 DEPARTMENT OF MINES
 OIL AND GAS DIVISION
 CHARLESTON

WELL LOCATION MAP
 FILE NO. JAC-900

+ Denotes location of well on United States Topographic Maps, scale 1 to 62,500, latitude and longitude lines being represented by border lines as shown.
 - Denotes one inch spaces on border line of original tracing.

No Sampler 255 6-0 Deep Well ✓



STATE OF WEST VIRGINIA
DEPARTMENT OF MINES
OIL AND GAS DIVISION

Quadrangle Belleville

Permit No. Jac-900

WELL RECORD

Oil or Gas Well Dry
(X1125)

Company D. D. Foster Company

Address 505 Alcoa Building, Pitts., Pa.

Farm Everett Burdette Acres 46

Location (waters) Pond Creek

Well No. 1 Elev. 834.2

District Grant County Jackson

The surface of tract is owned in fee by Everett Burdette

Address Ravenswood

Mineral rights are owned by Everett Burdette

Address Ravenswood

Drilling commenced July 25, 1955

Drilling completed October 5, 1955

Date Shot _____ From _____ To _____

With _____

Open Flow _____ /10ths Water in _____ Inch

_____ /10ths Merc. in _____ Inch

Volume _____ Cu. Ft.

Rock Pressure _____ lbs. _____ hrs.

Oil _____ bbls., 1st 24 hrs.

Fresh water _____ feet _____ feet

Salt water _____ feet _____ feet

Casing and Tubing	Used in Drilling	Left in Well	Packers
Size			Kind of Packer
16			
18 <u>3/8</u>	<u>25' 0"</u>		<u>Shoe</u>
10	<u>679</u>		Size of
8 <u>5/8</u>	<u>1144</u>		Depth set
7 <u>OD</u>	<u>1846</u>		
5 <u>1/2</u>	<u>4352</u>		Perf. top
3			Perf. bottom
2			Perf. top
Liners Used			Perf. bottom


CASING CEMENTED _____ SIZE 5" No. Ft. _____ Date _____

COAL WAS ENCOUNTERED AT _____ FEET _____ INCHES

_____ FEET _____ INCHES _____ FEET _____ INCHES

_____ FEET _____ INCHES _____ FEET _____ INCHES

Formation	Color	Hard or Soft	Top	Bottom	Oil, Gas or Water	Depth Found	Remarks
Red Rock			0	75	Water	300 2 Bailers per hour	4 Bailers per hour
Sand			75	105			
Red Rock			105	225			
Sand			225	300			
White Slate			300	305			
Lime			305	318			
Red Rock			318	365			
Sand			365	400			
Red Rock			400	435			
Lime			435	478			
Blue Mud			478	505			
Red Rock			505	515			
Sand			515	590			
Slate			590	607			
Red Rock			607	620			
Sand			620	672			
Slate & Shells			672	688			
Red Rock			688	698			
Lime Shell			698	702			
Red Rock			702	760			
Gritty Lime			760	785			
Red Rock			785	796			
Slate & Shells			796	880			
Red Rock			880	900			
Slate			900	940			
Sand			940	960			
Slate			960	980			
Red Rock			980	1000			
Slate			1000	1030			
Sand			1030	1075	Water	1075	Salt Water
Slate Shells			1075	1220			
Sand			1220	1265	Water	1250-1265"	
Slate			1265	1300			
Sand			1300	1350	Water	1300-1350"	"
Slate			1350	1550			

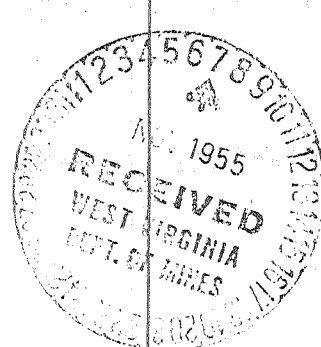

Formation	Color	Hard or Soft	Top <i>5</i>	Bottom	Oil, Gas or Water	Depth Found	Remarks
Sand			1550	1600			
Lime			1600	1605			
Slate			1605	1640			
Lime			1640	1660			
Slate			1660	1680			
Sandy Lime			1680	1700			
Slate			1700	1720			
Slate & Shells			1720	1885			
Lime			1885	1950			
White Slate			1950	2145			
Brown Shale			2145	2165			
Sand			2165	2167	- Brown		
Slate Shells			2167	3330			
Brown Shale - 441			3330	3395			
Lime			3395	3415			
Shell Slate			3415	3580	Gas	3775-3790	Show
Brown Shale			3580	3790			
White Slate			3790	4175			
Brown Shale			4175	4330			
Cornifious Lime - 463			4330	4430			
Oriskony Sand			4430	4456	Gas	4435	Show
Total Depth			4462				
<i>Held 4456-</i>			<u>485</u>				
					4330	4456	
					834	834	
					<u>3496</u>	<u>3622</u>	

Date....., 19.....

APPROVED....., Owner

By..... (Title)