

New Location
 Drill Deeper
 Abandonment

Company B. H. Putnam (operator)
 Address Box 647, Marietta, Ohio.
 Farm W. M. Hudson
 Tract _____ Acres 147 1/2 Lease No. _____
 Well (Farm) No. 1 Serial No. _____
 Elevation (Spirit Level) 989'
 Quadrangle Belleuille - SW
 County Tackson District Grant
 Engineer Robert R. Anderson
by O. Meredith
 Engineer's Registration No. 296
 File No. _____ Drawing No. _____
 Date 7/6 1955 Scale 30 Feet to 1 inch

STATE OF WEST VIRGINIA
 DEPARTMENT OF MINES
 OIL AND GAS DIVISION
 CHARLESTON

WELL LOCATION MAP
 FILE NO. JAC-902

+ Denotes location of well on United States Topographic Maps, scale 1 to 62,500, latitude and longitude lines being represented by border lines as shown.
 - Denotes one inch spaces on border line of original tracing.

66 255

Deep Well ✓



STATE OF WEST VIRGINIA
DEPARTMENT OF MINES
OIL AND GAS DIVISION 3

Belleville

WELL RECORD

Oil or Gas Well Gas
(KIND)

Permit No. J A C - 902


Company B. H. Putnam, Operator
Address 512 Third Street, Marietta, Ohio
Farm W. M. Hudson (DeLong-Michael Acres 147
Location (waters) Ohio
Well No. 1 Elev. 984
District Grant County Jackson
The surface of tract is owned in fee by W. M. Hudson
Address _____
Mineral rights are owned by W. M. Hudson, et al
Address _____
Drilling commenced 7-28-55
Drilling completed 11-1-55
Date Shot 11-7-55 From _____ To _____
With Hydracore
Open Flow _____ /10ths Water in _____ Inch
972 MCF /10ths Merc. in _____ Inch
Volume _____ Cu. Ft.
Rock Pressure _____ lbs. _____ hrs.
Oil _____ bbls., 1st 24 hrs.
Fresh water _____ feet _____ feet
Salt water _____ feet _____ feet

Casing and Tubing	Used in Drilling	Left in Well	Packers
Size			
16			Kind of Packer <u>Baker</u>
13	<u>748</u>	<u>748</u>	<u>Open hole retrievable</u>
10	<u>1184</u>	<u>1184</u>	Size of <u>5 1/2</u>
8 1/4	<u>2030</u>	<u>2030</u>	
6 5/8			Depth set <u>4639</u>
5 3/16	<u>4528</u>	<u>4528</u>	
3			Perf. top _____
2	<u>4639</u>	<u>4639</u>	Perf. bottom _____
Liners Used			Perf. top _____
			Perf. bottom _____

CASING CEMENTED 5 1/2 SIZE 4528 No. Ft. 10-14-55 Date

COAL WAS ENCOUNTERED AT _____ FEET _____ INCHES
_____ FEET _____ INCHES FEET _____ INCHES
_____ FEET _____ INCHES FEET _____ INCHES

Formation	Color	Hard or Soft	Top	Bottom	Oil, Gas or Water	Depth Found	Remarks
Rock	Red		0	15			
Slate	Blue		15	70			
Rock	Red		70	100			
Slate			100	125			
Rock	Red		125	185			
Slate			185	220			
Rock	Red		220	360			
Slate Blue			360	425			
Sand			425	495			
Slate			495	505			
Sand			505	530			
Salte			530	575			
Rock	Red		575	600			
Line			600	615			
Slate & Shells			615	685			
Sand			685	740			
Slate			740	785			
Sand			785	795			
Slate & Shells			795	845			
Sand			845	870			
Slate	Blue		870	880			
Rock	Red		880	915			
Slate & Shells			915	930			
Sand			930	960			
Rock	Red		960	990			
Slate	Blue		990	1045			
Rock	Red		1045	1100			
Slate			1100	1150			
Sand			1150	1165			
Slate			1165	1200			
Rock	Red		1200	1204			
Slate			1204	1220			
Rock	Red		1220	1232			
Slate			1232	1260			
Sand			1260	1315			
Slate			1315	1342			
Slate & Shells			1342	1360			
Sand			1360	1375			
Slate & Shells			1375	1405			

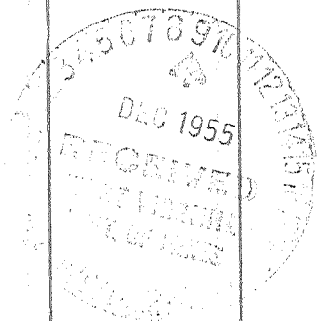

(Over)

Formation	Color	Hard or Soft	Top <u>3</u>	Bottom	Oil, Gas or Water	Depth Found	Remarks
1405 Sand			1405	1542			
Slate & Shells			1542	1625			
Sand			1625	1655			
Lime			1655	1690			
Slate & Shells			1690	1765			
Sand			1765	1777			
Lime			1777	1805			
Slate & Shells			1805	1840			
Lime	White		1840	1855			
Sand			1855	1880			
Lime <i>Big lime</i>			1880	1930			
Slate & Shells			1930	2311			
Shale	Brown		2311	2323			
Berea Sand			2323	2327			
Slate & Shells			2327	3450			
Shale	Brown - 441		3450	3525			
Slate & Shells			3525	3740			
Shale	Brown		3740	3925			
Slate	White		3925	4300			
Slate	Black		4300	4460			
Lime - <i>Huntsville</i>			4460	4577			
Sand - <i>ORISKANY</i>			4577	4603			
Lime - <i>Huntsville</i>			4603	4609			
			(485)				
					4460	4577	4603
					984	984	984
					3476	3593	3619

Date _____, 19__

APPROVED _____, Own

By _____