

4703501007P

WW-7
8-30-06



West Virginia Department of Environmental Protection
Office of Oil and Gas

WELL LOCATION FORM: GPS

API: 47-035-01007 WELL NO.: 1

FARM NAME: John T Moore Etal

RESPONSIBLE PARTY NAME: Diversified Production LLC

COUNTY: Jackson DISTRICT: Ripley

QUADRANGLE: Winfield

SURFACE OWNER: Daron W. Tanner

ROYALTY OWNER: DP Bluegrass LLC

UTM GPS NORTHING: 4284034.08

UTM GPS EASTING: 434272.57 GPS ELEVATION: 1022.18

The Responsible Party named above has chosen to submit GPS coordinates in lieu of preparing a new well location plat for a plugging permit or assigned API number on the above well. The Office of Oil and Gas will not accept GPS coordinates that do not meet the following requirements:

1. Datum: NAD 1983, Zone: 17 North, Coordinate Units: meters, Altitude: height above mean sea level (MSL) – meters.
2. Accuracy to Datum – 3.05 meters
3. Data Collection Method:

Survey grade GPS : Post Processed Differential

Real-Time Differential

Mapping Grade GPS : Post Processed Differential

Real-Time Differential

4. Letter size copy of the topography map showing the well location.

I the undersigned, hereby certify this data is correct to the best of my knowledge and belief and shows all the information required by law and the regulations issued and prescribed by the Office of Oil and Gas.

[Signature]
Signature

Director Technical Services
Title

3/7/2022
Date

RECEIVED
Office of Oil and Gas

MAR 10 2022

WV Department of
Environmental Protection

03/25/2022



DIVERSIFIED
energy

100 Diversified Way
Pikeville KY, 41051

47-035-01007


Plugging Map

Legend


- Well
- Access Road
- Pits
- Pad
- Public Roads

1 Pit
 10' W
 20' L
 8' D

 285 bbl

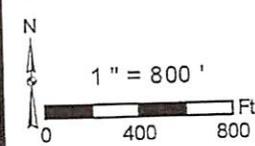

Well No.: 47-035-01007
 UTM83-17, Meters
 East: 434272.57
 North: 4284034.08
 Elev.: 311.64 M
 Elev.: 1022.18 Ft

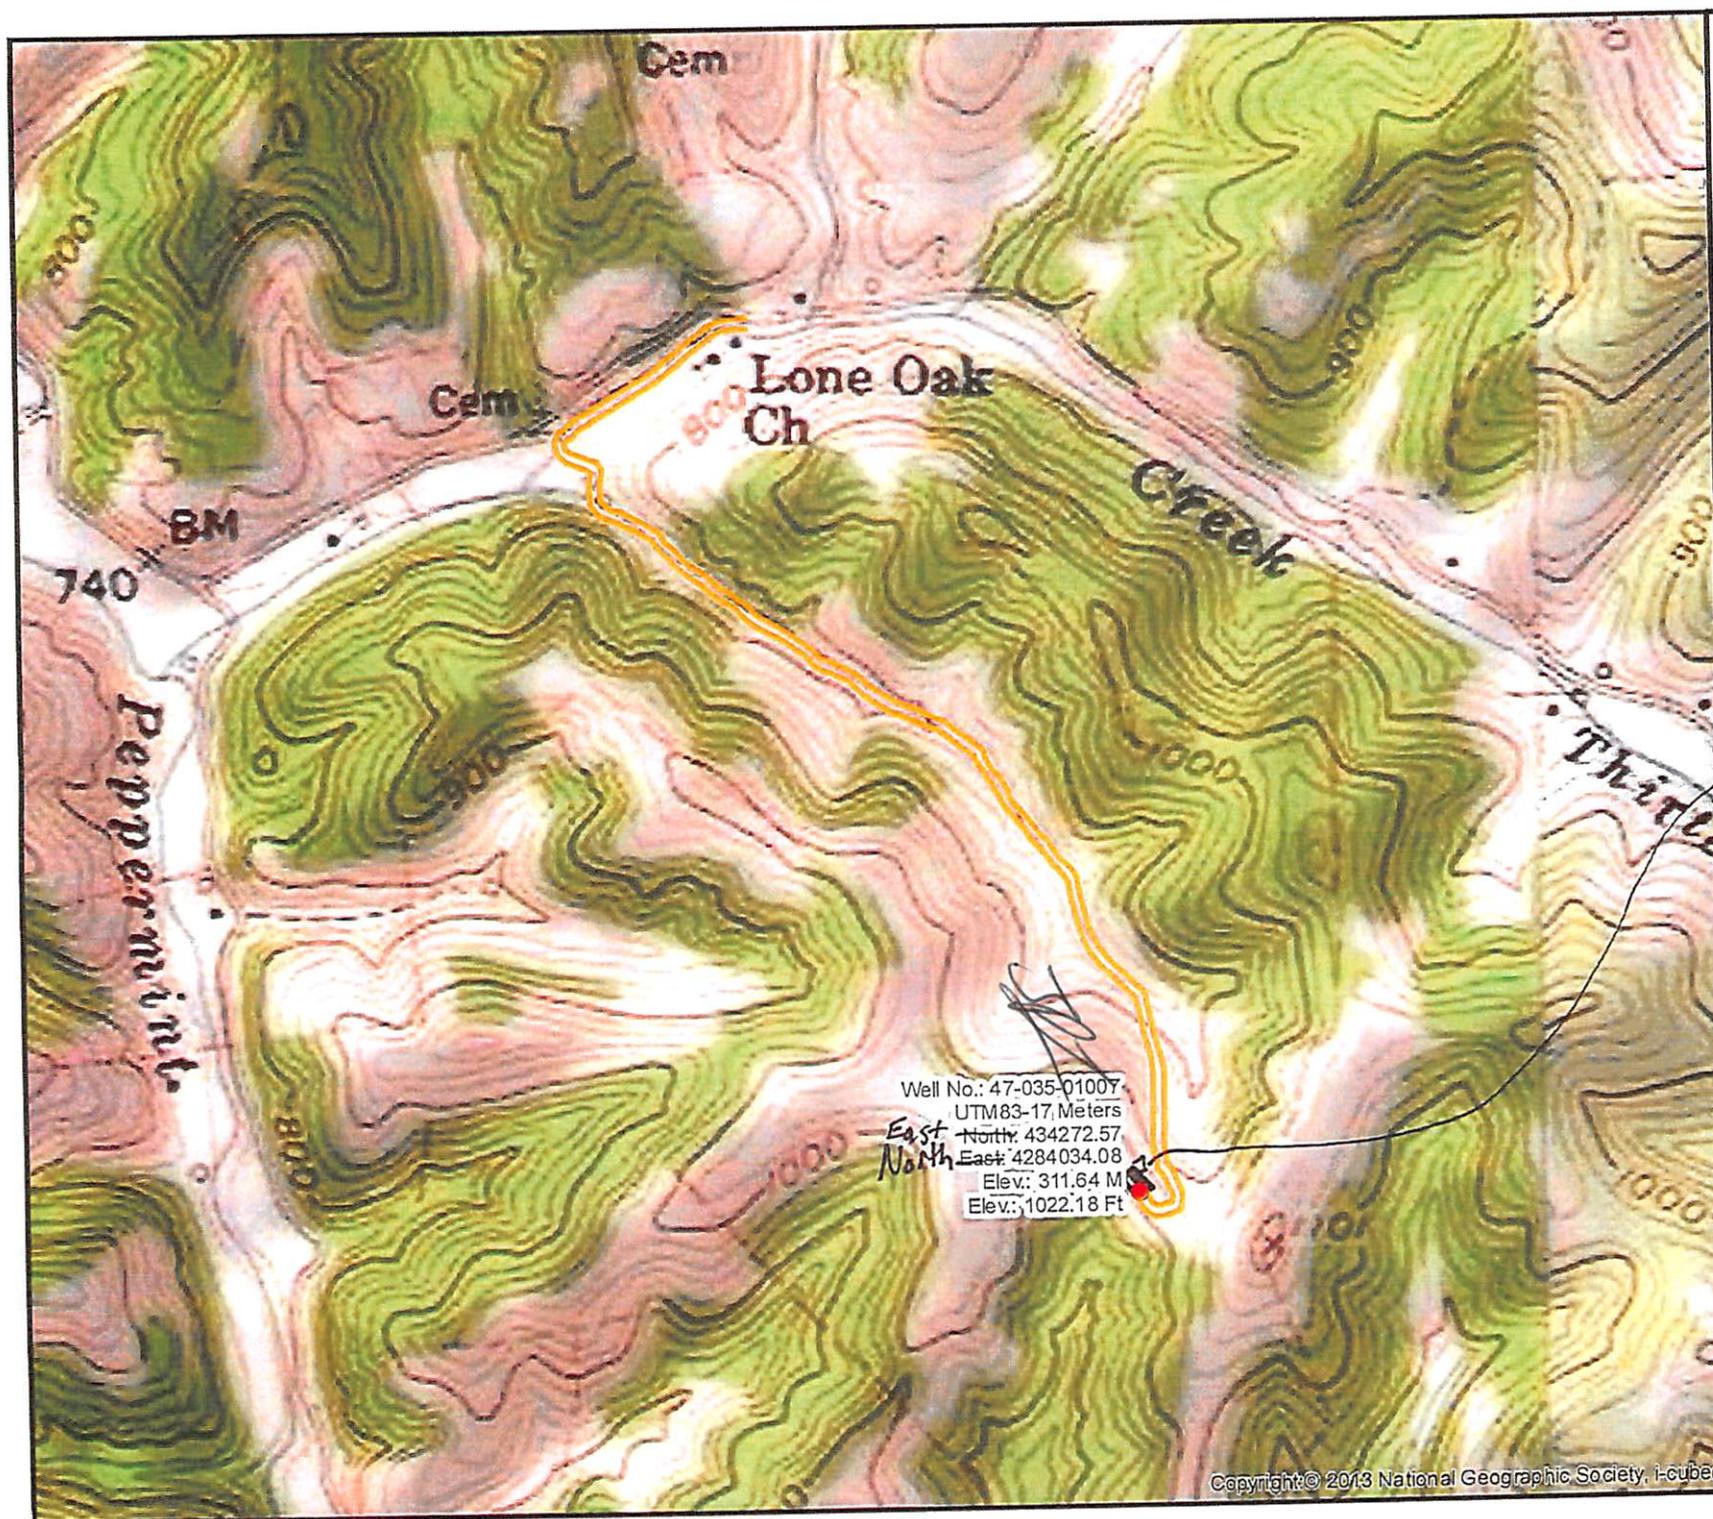

4703501007P