

WW-7
8-30-06



West Virginia Department of Environmental Protection
Office of Oil and Gas
WELL LOCATION FORM: GPS

API: 47-035-01321 WELL NO.: #2-755-B

FARM NAME: Stewart Sayre

RESPONSIBLE PARTY NAME: Mountaineer Gas Services, LLC

COUNTY: Jackson DISTRICT: Ripley

QUADRANGLE: Jackson

SURFACE OWNER: Stewart Sayre

ROYALTY OWNER: Stewart Sayre

UTM GPS NORTHING: 4293755.8

UTM GPS EASTING: 433267.2 GPS ELEVATION: 594.2

The Responsible Party named above has chosen to submit GPS coordinates in lieu of preparing a new well location plat for a plugging permit or assigned API number on the above well. The Office of Oil and Gas will not accept GPS coordinates that do not meet the following requirements:

1. Datum: NAD 1983, Zone: 17 North, Coordinate Units: meters, Altitude: height above mean sea level (MSL) – meters.
2. Accuracy to Datum – 3.05 meters
3. Data Collection Method:

Survey grade GPS ____: Post Processed Differential ____


Real-Time Differential ____

Mapping Grade GPS ____: Post Processed Differential XX

Real-Time Differential ____

4. Letter size copy of the topography map showing the well location.

I the undersigned, hereby certify this data is correct to the best of my knowledge and belief and shows all the information required by law and the regulations issued and prescribed by the Office of Oil and Gas.

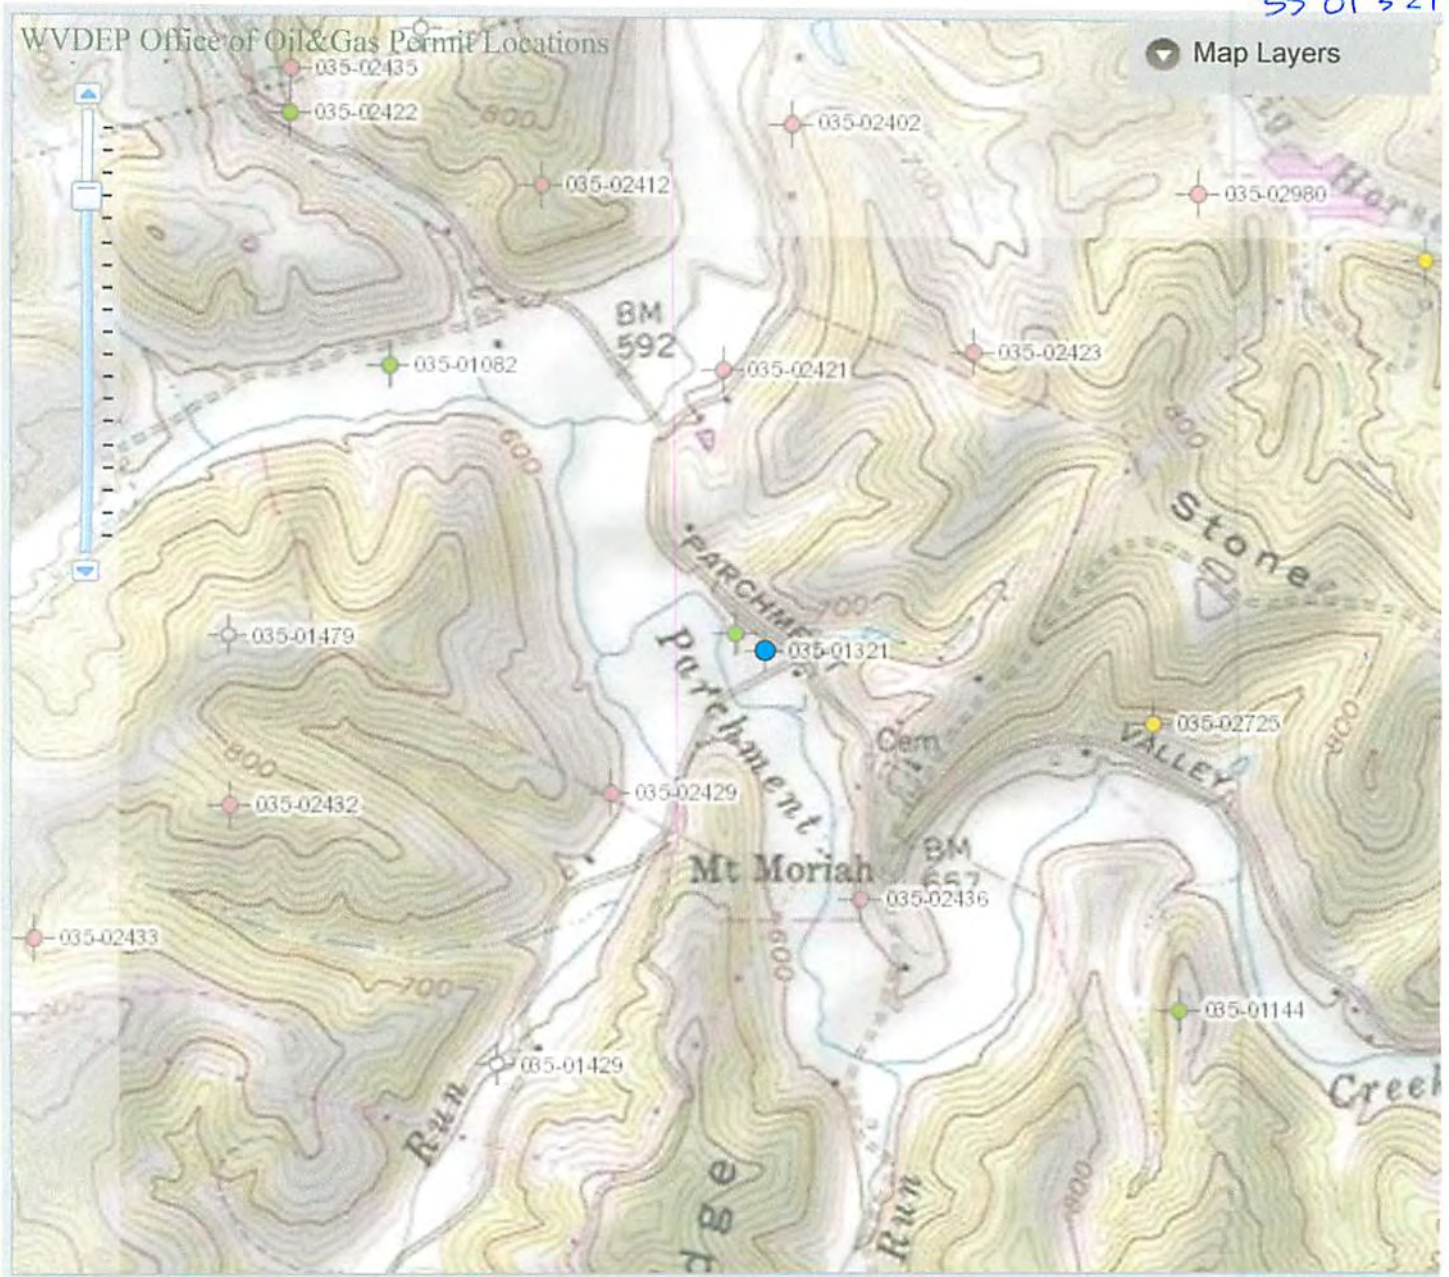

Signature

Office Manager
Title

9-17-2014
Date

Received
Office of Oil & Gas
JAN 26 2015

3501321P



Stewart Sayre # 2-755-B

Received
 Office of Oil & Gas
 JAN 26 2015