

WW-7
8-30-06



West Virginia Department of Environmental Protection
Office of Oil and Gas
WELL LOCATION FORM: GPS

API: 47 035 01407 WELL NO.: DEK 42

FARM NAME: Wayne Hughes

RESPONSIBLE PARTY NAME: EXCO Resources (PA), LLC

COUNTY: Jackson DISTRICT: Union - 4

QUADRANGLE: Ravenswood 7.5 - 570

SURFACE OWNER: Lowell Gene Hughes

ROYALTY OWNER: Lowell Gene Hughes

UTM GPS NORTHING: 4307675

UTM GPS EASTING: 431943 GPS ELEVATION: 711

The Responsible Party named above has chosen to submit GPS coordinates in lieu of preparing a new well location plat for a plugging permit or assigned API number on the above well. The Office of Oil and Gas will not accept GPS coordinates that do not meet the following requirements:

- Datum: NAD 1983, Zone: 17 North, Coordinate Units: meters, Altitude: height above mean sea level (MSL) – meters.
- Accuracy to Datum – 3.05 meters
- Data Collection Method:

Survey grade GPS : Post Processed Differential

Real-Time Differential

Mapping Grade GPS : Post Processed Differential

Real-Time Differential

RECEIVED
Office of Oil and Gas

JUL 05 2016

WV Department of
Environmental Protection


- Letter size copy of the topography map showing the well location.

I the undersigned, hereby certify this data is correct to the best of my knowledge and belief and shows all the information required by law and the regulations issued and prescribed by the Office of Oil and Gas.

Randall D. Stebbins
Signature

Supervisor
Title

6/22/16
Date

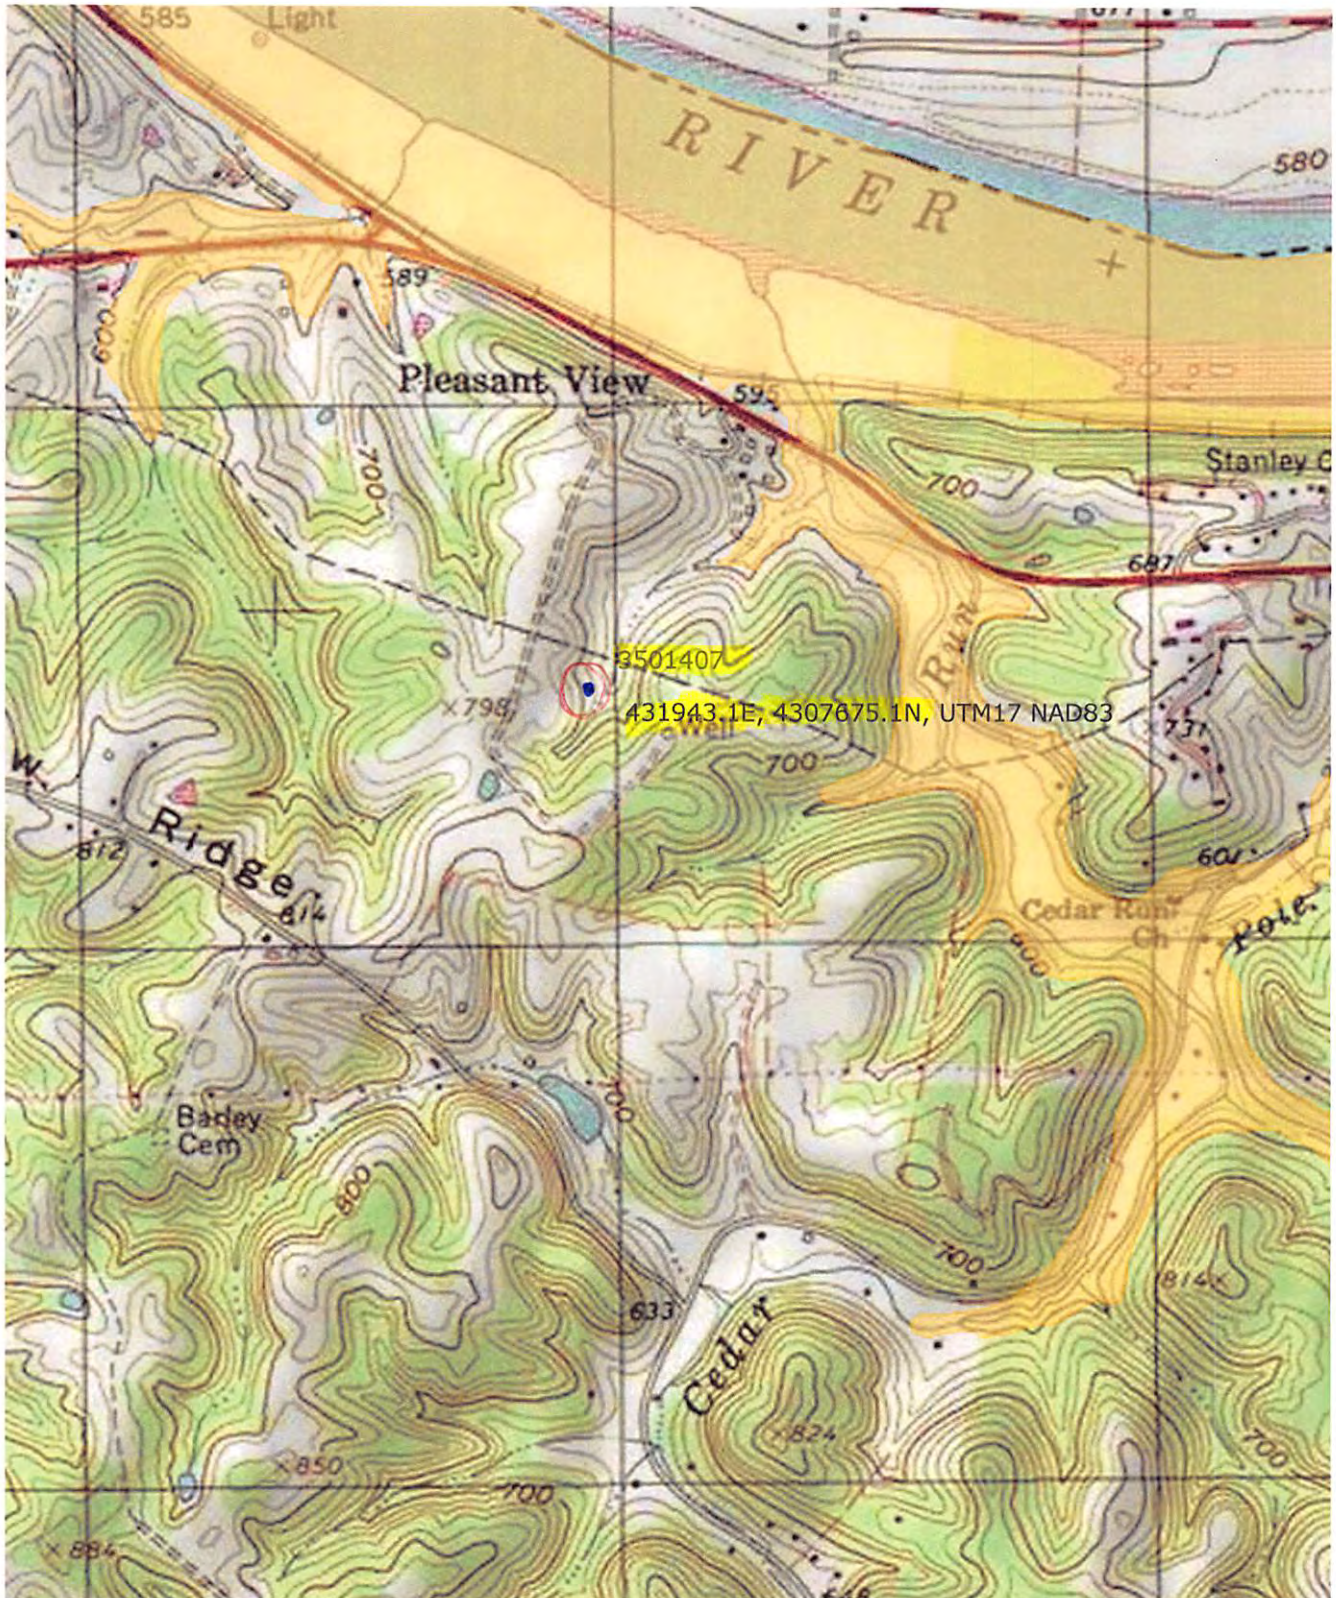

08/05/2016