

LATITUDE

38° 47' 30"


38° 50' - 15'

81° 30' - 15'

81° 30' 30"

LONGITUDE

FARM IS CORRECT,
LOCATIONS ARE CORRECT,
CORRESPONDING NUMBERS
ARE QUESTIONABLE,
46-A MAY BE 47-A
LOCATION, etc.

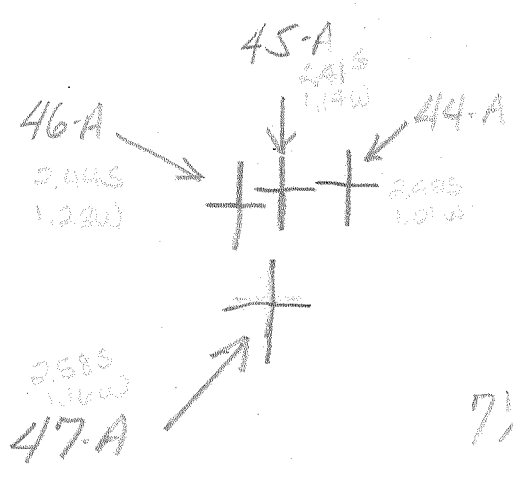

calc. 15' locs

- 44-A 5285; 339W
- 45-A 5295; 339W
- 46-A 5325; 347W
- 47-A 5465; 340W

Abd. permit issued: 6-1-34 (all 4 wells)

* LOCATED FROM OLD FARM-LINE MAPS

Company WALKER BEREN

Farm M.V. RHODES

- 44-A (3683)
- 45-A (3685)
- 46-A (3674)
- 47-A (3694)

Reply SE-15
GAY 7 1/2'

Quad _____

County JACKSON

District WASHINGTON

WELL LOCATION MAP

JAC- File No. 44-A, 45-A, 46-A, 47-A

ABANDONED WELL FILE
PRE-PERMIT

Washington District, Jackson County, W. Va. 44-1
 Walker-Beren Oil Co., Parkersburg, W. Va. (W.W.Walker, partner).
 On 50 acres.
 Elevation, 685'.
 13" conductor, 16'; 6-5/8" casing, 1190'.
 No coal was encountered.
 Abandonment reported to Dept. of Mines May 25, 1934.

	Top.	Bottom.
Mud	0	10
Sand	10	60
Lime	60	80
Red rock	80	140
Slate and shells	140	265
✓Pittsburgh Sand - ⁴⁵	265	330
Red rock	330	430
Slate shells	430	515
Slate and red rock	515	915
✓Big Dunkard Sand	915	1010
Slate	1010	1040
✓Gas Sand	1040	1135
Slate	1135	1145
Sand	1145	1215
Slate shells	1215	1275
Sand (oil show)	1275	1340
Slate	1340	1400
Slate shells	1400	1425
Black slate	1425	1466
✓Salt Sand (oil), to bottom	1466	1490 (TD-1480?)

285

oil on 185, 1466