


LATITUDE

38° 47' 30"  
38° 50' - 15'

81° 30' - 15'  
81° 32' 30"

LONGITUDE

Farm is correct,  
Locations are correct,  
Corresponding numbers  
are questionable,  
46-A may be 47-A  
Location, etc.

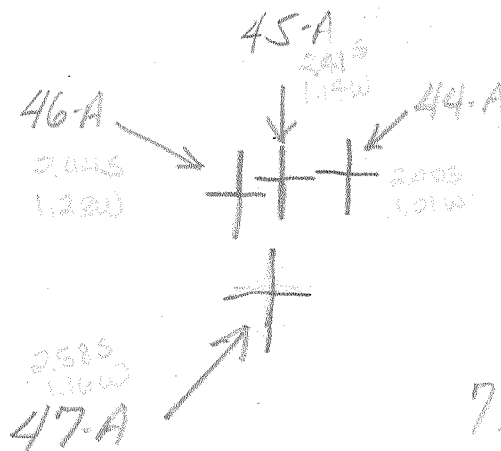

calc. 15' locs  
 44-A 5.225; 3.28W  
 45-A 5.295; 3.38W  
 46-A 5.325; 3.47W  
 47-A 5.465; 3.40W

Abd. permit issued: 6-1-34 (all 4 wells)

\* LOCATED FROM OLD FARM-LINE MAPS

Company WALKER BEREN  
 Farm M.V. RHODES  
 44-A (3683)  
 45-A (3685)  
 46-A (3674)  
 47-A (3694)  
 Quad GAY 7 1/2'  
 County JACKSON  
 District WASHINGTON

WELL LOCATION MAP

File No. 44-A, 45-A, 46-A, 47-A

ABANDONED WELL FILE  
PRE-PERMIT

46-A

Washington District, Jackson County, W. Va.  
Walker-Beran Oil Co., Parkersburg, W. Va.

On 50 acres.

Elevation, 687'.

1 1/2" conductor, 16'; 10" casing, 90'; 6-5/8", 1238'.

Steel shoe, 6-5/8".

No coal encountered.

Abandonment reported to Dept. of Mines May 25, 1934.

	Top.	Bottom.
Sand	0	80
Slate and shell	80	270
✓ Pittsburgh Sand - 1 <sup>st</sup>	270	345
Slate and shells	345	435
✓ Pittsburgh Sand - 2 <sup>nd</sup>	435	470
Slate	470	490
Red rock	490	595
Lime	595	610
Red rock	610	645
Lime	645	660
Slate	660	696
Red rock	696	790
Slate and shells	790	930
✓ Big Dunkard Sand	930	1014
Slate	1014	1040
Gas Sand	1040	1195
Slate and shells	1195	1230
Sand	1230	1260
Slate	1260	1320
Sand	1320	1330
Slate and shells	1330	1485
✓ Salt Sand (gas and oil), to bottom	1485	1518 (to 1518)

oil @ 1485  
gas @ 1485

285