


LATITUDE 38°47'30"
38°50'15"

81°20'15"
81°32'30"

LONGITUDE

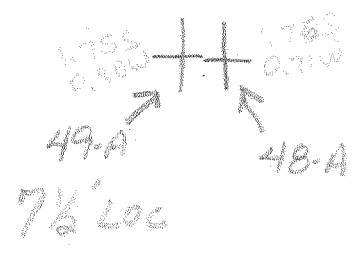

Abd. Permit Issued: 6-1-34

Calc 15' loc.

48-A-4,645; 2.95W
49-A-4,635; 3.04W

*LOCATED FROM OLD FARM-LINE MAPS

Company WALKER-BEREN Oil Co

Farm J.G. Greenleaf
#1403 (48-A)
#1404 (49-A)

Quad GAY 7 1/2', Ripley 15' SE

County JACKSON

District WASHINGTON

WELL LOCATION MAP
File No. JAC-48-A, 49-A
ABANDONED WELL FILE
PRE-PERMIT

Washington District, Jackson County, W. Va.
Walker-Seven Oil Co., Parkersburg, W. Va.

49-A

On 32 acres.

Elevation, 820'.

13" conductor, 16'; 6-5/8" casing, 1385'.

No coal encountered.

Abandonment reported to Dept. of Mines May 25, 1934.

	Top.	Bottom.
✓ 1st Gas-Rm Sand - LITTLE DUNKARD	956	995
✓ 2nd Gas-Rm Sand - BIG DUNKARD	1110	1215
✓ 3rd Salt Sand (oil), to bottom	1669	1699 (73-1699)

oil-1669'

345