


LATITUDE 38° 47' 30"  
38° 50' 15"

91° 30'

LONGITUDE

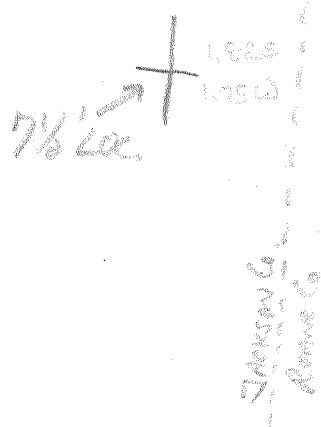

Abd. Permit issued: 9-27-34

Calc. 15' loc. 2.70 S  
175 W

\* LOCATED FROM OLD FARM-LINE MAPS

Company U.F.G. #711

Farm B.F. Thomas

Quad GAY 7 1/2' ; Ripley 15' SE

County Jackson Co.

District WASH.

WELL LOCATION MAP

File No. JAC. 52-A

ABANDONED WELL FILE  
PRE-PERMIT

Washington District, Jackson County, W. Va.  
 United Fuel Gas Co.

52-A

On 125 acres, surface and mineral rights owned by H. F. Thomas,  
 Gay, W. Va.

Elevation, 1010' B.

13" conductor, 12"; 5 1/2" casing, 1614'.

Anchor pulker, 3 x 3 1/4, set at 1727'.

No coal encountered.

Abandonment reported to Dept. of Mines Sept. 21, 1934.

Well was not shot.

Water not recorded.

	Top.	Bottom.
✓ Pittsburgh Sand / Ac	585	655
✓ 2nd Pittsburgh Sand	735	790
Bed rock shell	840	1060
✓ Little Dunkard Sand	1060	1120
White slate	1120	1240
✓ Big Dunkard Sand	1240	1340
White slate	1340	1380
✓ Gas Sand	1380	1520
✓ Salt Sand (gas, 1803'; gas, 1805')	1803	
Total depth		1837

285