


4/24/73 CE

Latitude 38° 55'

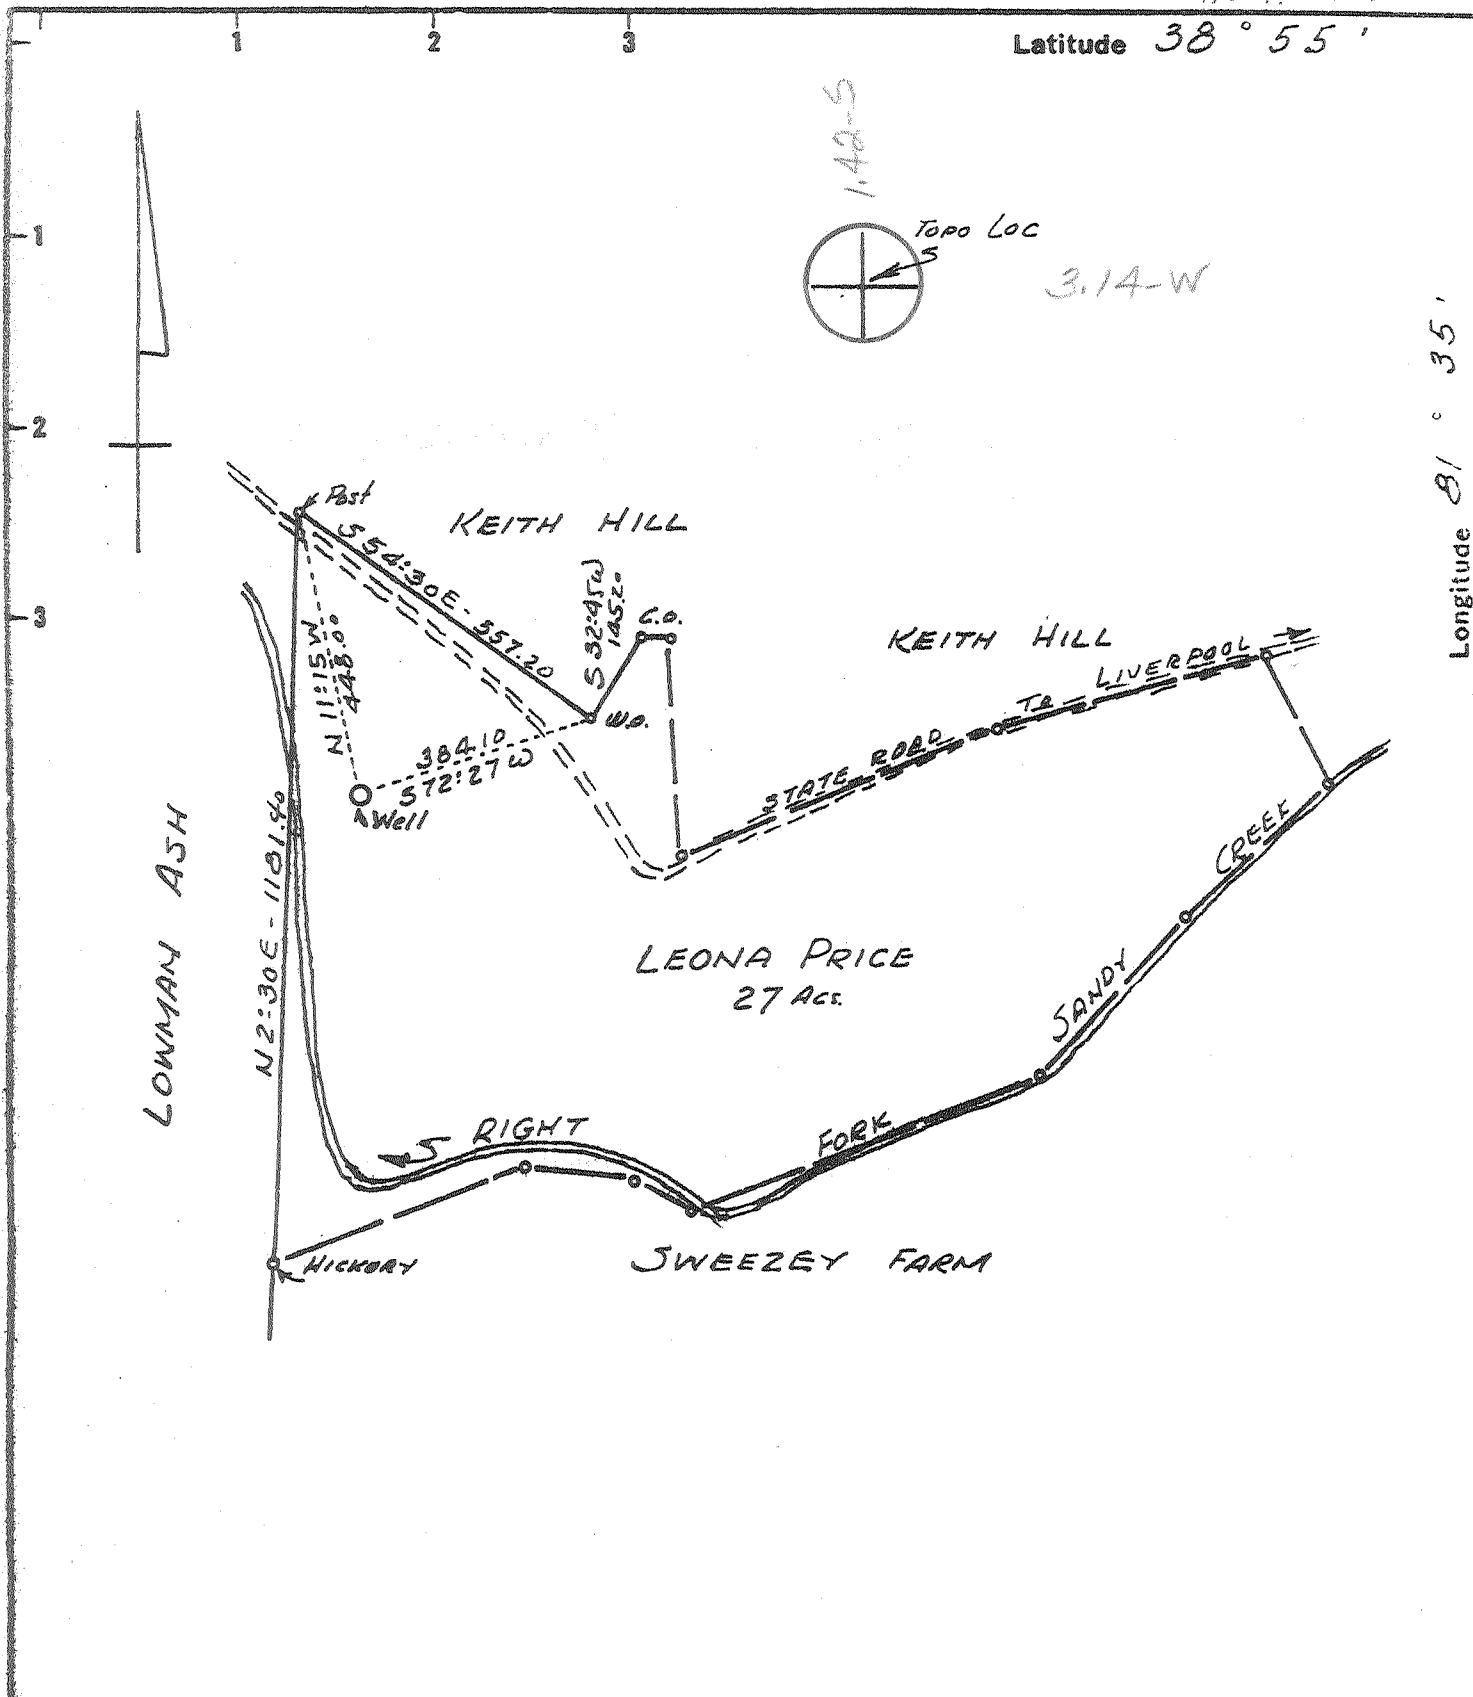

New Location   
 Drill Deeper   
 Abandonment

6-28-73

Minimum Error of Closure 1 in 200  
 Source of Elevation USGS Elev BM 594' BRIDGE PIER Rt. Fk. SANDY CREEK

"I, the undersigned, hereby certify that this map is correct to the best of my knowledge and belief and shows all the information required by paragraph 6 of the rules and regulations of the oil and gas section of the mining laws of West Virginia."

West Va. Department of Mines,  
 Oil & Gas Division  
 Company Oil & Gas Division  
 Address 2000 Quarrier St., Charleston, W. Va., 25311  
 Farm LEONA PRICE  
 Tract \_\_\_\_\_ Acres 27 Lease No. \_\_\_\_\_  
 Well (Farm) No. 1 Serial No. \_\_\_\_\_  
 Elevation (Spirit Level) 600.0  
 Quadrangle RIPLEY C  
 County JACKSON District RAVENSWOOD  
 SURVEYOR James D. Sifton  
 SURVEYOR James D. Sifton  
 Engineer's Registration No. 149  
 File No. \_\_\_\_\_ Drawing No. \_\_\_\_\_  
 Date \_\_\_\_\_ Scale \_\_\_\_\_

STATE OF WEST VIRGINIA  
 DEPARTMENT OF MINES  
 OIL AND GAS DIVISION  
 CHARLESTON  
**WELL LOCATION MAP**  
 FILE NO. JAC-156 (A)

+ Denotes location of well on United States Topographic Maps, scale 1 to 62,500 latitude and longitude lines being represented by border lines as shown.

- Denotes one inch spaces on border line of original tracing.

STATE OF WEST VIRGINIA  
DEPARTMENT OF MINES  
OIL AND GAS WELLS DIVISION

RECEIVED

JUL 16 1973

DEPT. OF MINES

AFFIDAVIT OF PLUGGING AND FILLING WELL

AFFIDAVIT SHOULD BE MADE IN TRIPPLICATE, ONE COPY MAILED TO THE DEPARTMENT, ONE COPY TO BE RETAINED BY THE WELL OPERATOR AND THE THIRD COPY (AND EXTRA COPIES IF REQUIRED) SHOULD BE MAILED TO EACH COAL OPERATOR AT THEIR RESPECTIVE ADDRESSES.

None  
COAL OPERATOR OR OWNER

A.A. Pursley dba:  
Pursley's Pulling & Well Service  
NAME OF WELL OPERATOR

Box 51, Leroy, West Virginia 25252  
COMPLETE ADDRESS

July 22 19 73  
WELL AND LOCATION

Ravenswood District

Jackson County

Loana Price  
LEASE OR PROPERTY OWNER

Sandyville, West Virginia 25275  
ADDRESS

Well No. # 1

Loana Price Farm

STATE INSPECTOR SUPERVISING PLUGGING Fred Marlette, Box 190, Sissonsville, W.V.

AFFIDAVIT

STATE OF WEST VIRGINIA, }  
County of Jackson } ss:  
Eugene Pursley and A.A. Pursley  
being first duly sworn according to law depose and say that they are experienced in the work of plugging and filling oil and gas wells and were employed by Pursleys Pulling & Well Service, well operator, and participated in the work of plugging and filling the above well, that said work was commenced on the 17 day of July, 19 73, and that the well was plugged and filled in the following manner:

SAND OR ZONE RECORD	FILLING MATERIAL	PLUGS USED	CASING	
			CSG PULLED	CSG LEFT IN
FORMATION	<u>Cement &amp; 6% Bentonite Gel</u>	SIZE & KIND <u>5 1/2</u> <u>10"</u>	<u>450'</u>	<u>Unknown</u> <u>Left in</u>
	<u>Cement 789'-700'</u>			
	<u>6% gel 700-500' , pull 5 1/2 casing</u>			
	<u>Cement 500'-400'</u>			
	<u>6% gel 400-100'</u>			
	<u>Cement 100'- 80'</u>			
	<u>6% gel 80'-20'</u>			
	<u>Cement 20' to surface.</u>			
COAL BEAMS		DESCRIPTION OF MONUMENT		
(NAME)		<u>Erected marker as prescribed by</u>		
(NAME)		<u>Oil &amp; Gas Division</u>		
(NAME)				
(NAME)				

and that the work of plugging and filling said well was completed on the 20th day of July, 19 73.

And further deponents saith not.

Sworn to and subscribed before me this 21 day of July, 19 73.

My commission expires:  
March 22, 1980

Eugene Pursley  
A.A. Pursley  
Jean Pursley  
Notary Public

Permit No. Jac-156-A E. NOLL

JUL 17 1973