


LATITUDE 38°45'

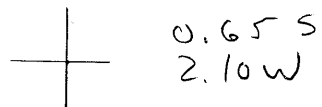

41°45'

LONGITUDE

7.5 OGIS topo location

7.5' loc \_\_\_\_\_ 15' loc \_\_\_\_\_  
 \_\_\_\_\_ (calc.) \_\_\_\_\_

Company Staats et Al

Farm Staats et Al 3

Quad \_\_\_\_\_

County Jackson

District Washington

WELL LOCATION MAP

File No. 035-70057

# 15 in WVGES

Jackson County Report