


LATITUDE 38° 35'

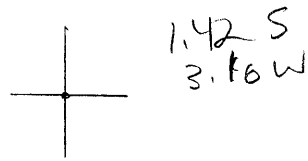

LONGITUDE 81° 35'

7.5 OGIS topo location

7.5' loc \_\_\_\_\_ 15' loc \_\_\_\_\_  
 \_\_\_\_\_ (calc.) \_\_\_\_\_

Company Moore E, Bros

Farm Moore 1

Quad \_\_\_\_\_

County Jackson

District Ravenswood

WELL LOCATION MAP

File No. 025-70064

#24 in WUGES

Jackson County Report