

WW-7
8-30-06



West Virginia Department of Environmental Protection
Office of Oil and Gas
WELL LOCATION FORM: GPS

API: 47-39-00170 WELL NO.: Kanawha Land Co. 829
 FARM NAME: Kanawha Land Co.
 RESPONSIBLE PARTY NAME: South Charleston Development LLC
 COUNTY: Kanawha DISTRICT: ~~South Charleston Corp.~~
LOU DON
 QUADRANGLE: Charleston West
 SURFACE OWNER: South Charleston Municipal Building Commission
 ROYALTY OWNER: South Charleston Municipal Building Commission
 UTM GPS NORTHING: 4246192.2
 UTM GPS EASTING: 437936.8 GPS ELEVATION: 582.16

The Responsible Party named above has chosen to submit GPS coordinates in lieu of preparing a new well location plat for a plugging permit or assigned API number on the above well. The Office of Oil and Gas will not accept GPS coordinates that do not meet the following requirements:

1. Datum: NAD 1983, Zone: 17 North, Coordinate Units: meters, Altitude: height above mean sea level (MSL) – meters.
2. Accuracy to Datum – 3.05 meters
3. Data Collection Method:

Survey grade GPS ____ : Post Processed Differential ____

Real-Time Differential ____

Mapping Grade GPS ^X ____ : Post Processed Differential ____

Real-Time Differential ____

4. Letter size copy of the topography map showing the well location.


I the undersigned, hereby certify this data is correct to the best of my knowledge and belief and shows all the information required by law and the regulations issued and prescribed by the Office of Oil and Gas.

Ray Gyles
Signature

Land Manager
Title

8/12/21
Date

FMC Sat

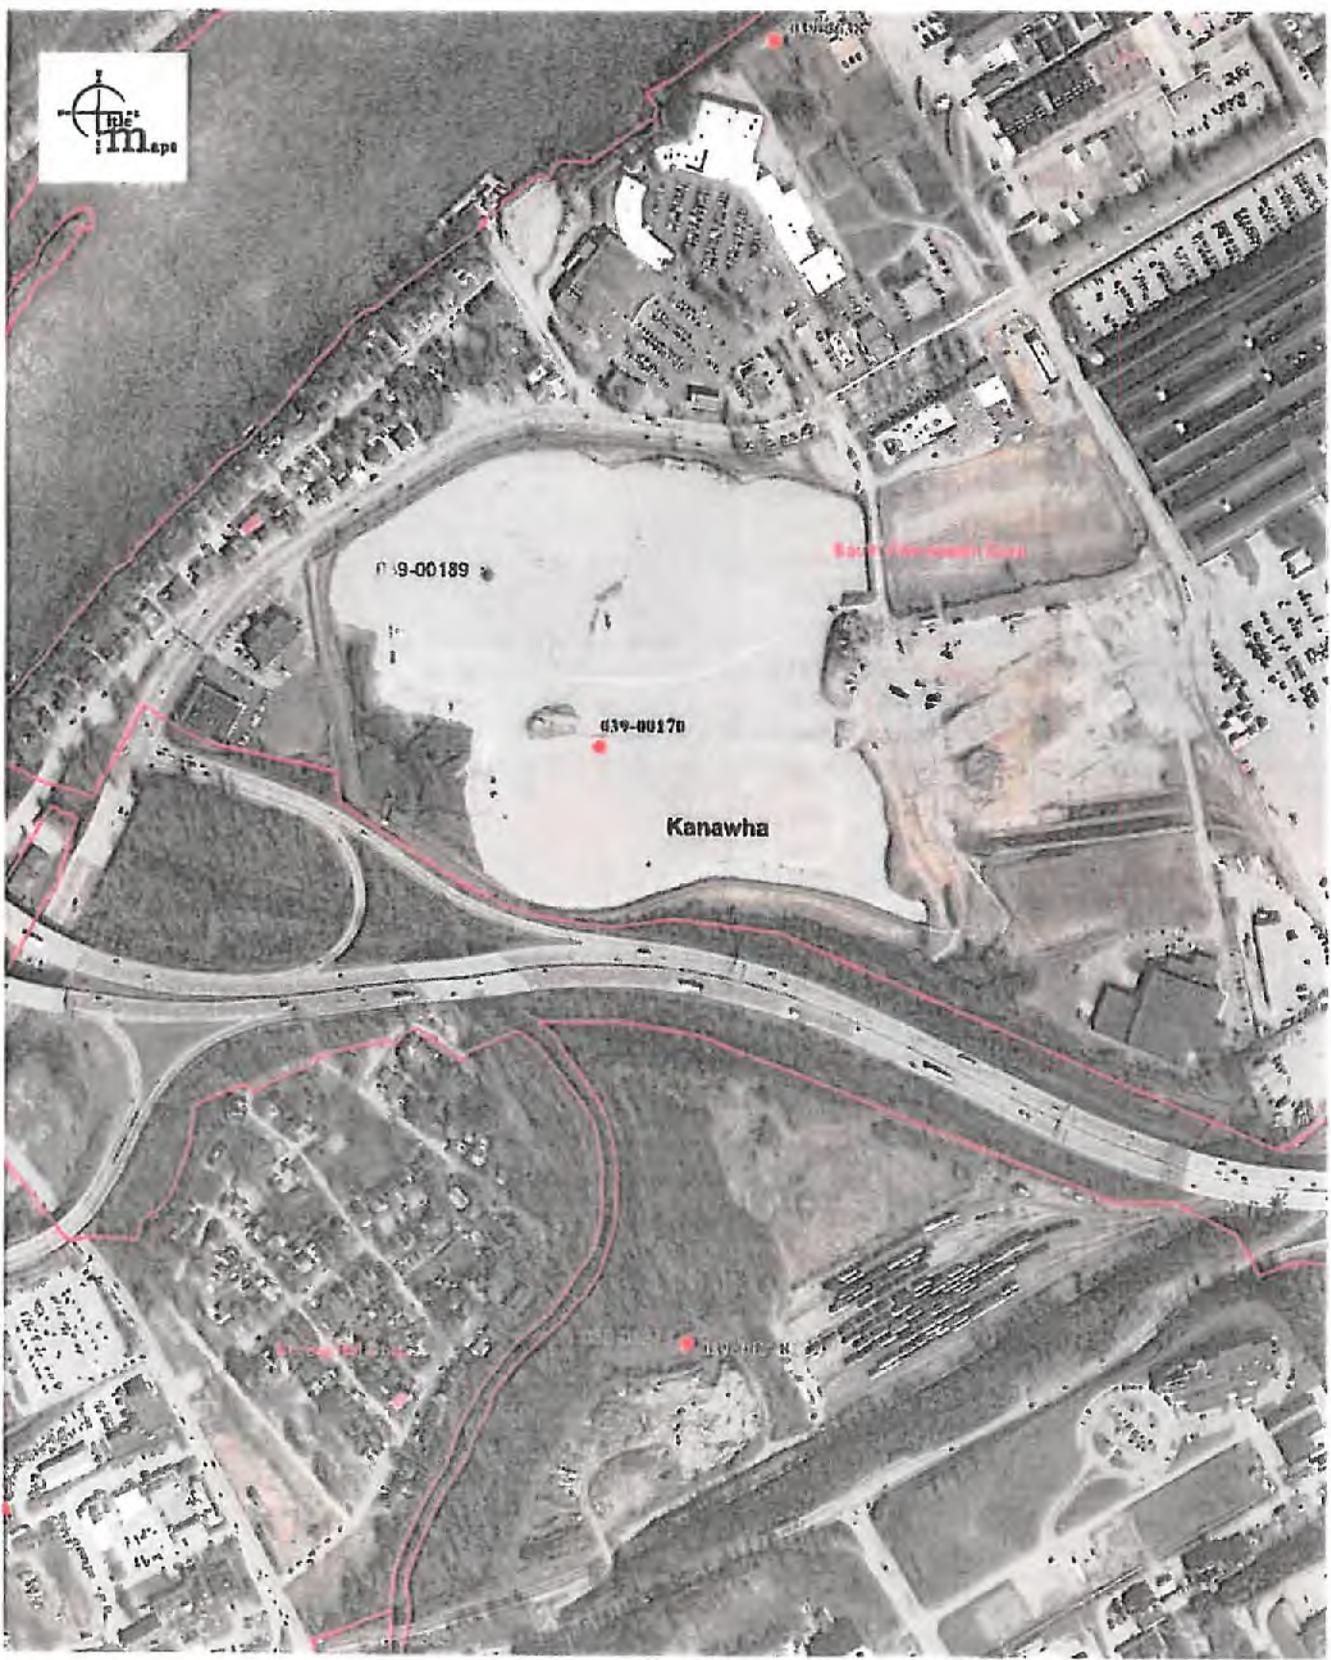

500ft


Approximate Scale 1:6,000

08/12/2021 - 02:08:51 PM

Disclaimer: The map information shown is from various sources including but not limited to tax maps and state and federal agency web sites. The map information does not represent and should not be relied upon as a land survey or legal depiction of the property or information shown. This Maps LLC does not warrant the accuracy or correctness of the map information shown.

09/17/2021

FMC Well topo

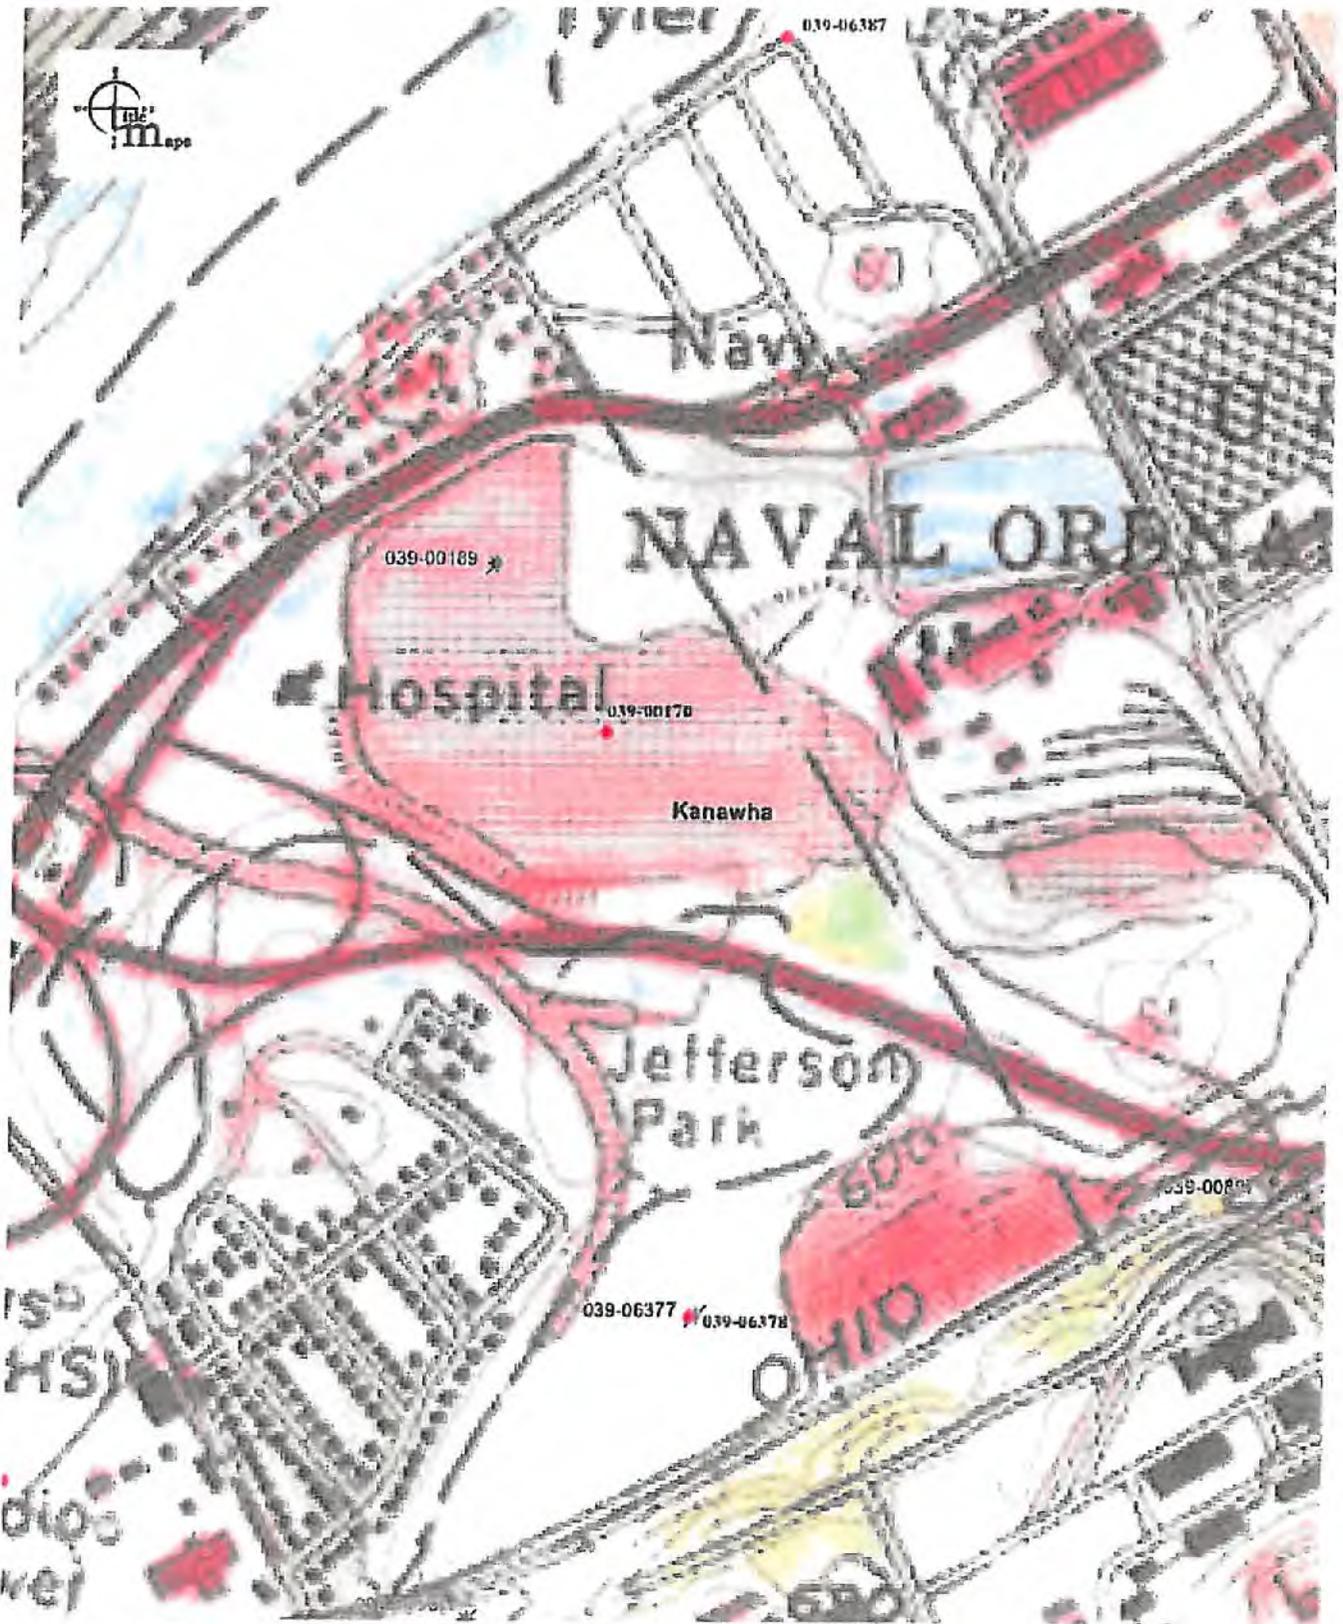

Approximate Scale 1:6,000

08/12/2021 - 02:11:44 PM

Disclaimer: The map information shown is from various sources including but not limited to tax maps and state and federal agency web sites. The map information does not represent and should not be relied upon as a land survey or legal depiction of the property or information shown. Title Maps LLC does not warrant the accuracy or correctness of the map information shown herein.

09/17/2021