

WW-7  
8-30-06



West Virginia Department of Environmental Protection  
Office of Oil and Gas  
**WELL LOCATION FORM: GPS**

API: 47-39-00425 WELL NO.: BESS 1

FARM NAME: Laura B. Bess

RESPONSIBLE PARTY NAME: Shale Gas Production, LLC

COUNTY: Kanawha DISTRICT: Union

QUADRANGLE: Charleston West

SURFACE OWNER: Kenneth U Preece & Jennifer Cadle

ROYALTY OWNER: Bess heirs

UTM GPS NORTHING: 4247276

UTM GPS EASTING: ~~563760.3~~ 436239 GPS ELEVATION: 768.4

The Responsible Party named above has chosen to submit GPS coordinates in lieu of preparing a new well location plat for a plugging permit or assigned API number on the above well. The Office of Oil and Gas will not accept GPS coordinates that do not meet the following requirements:

1. Datum: NAD 1983, Zone: 17 North, Coordinate Units: meters, Altitude: height above mean sea level (MSL) – meters.
2. Accuracy to Datum – 3.05 meters
3. Data Collection Method:

Survey grade GPS  : Post Processed Differential

Real-Time Differential

Mapping Grade GPS  : Post Processed Differential

Real-Time Differential

4. Letter size copy of the topography map showing the well location:

I the undersigned, hereby certify this data is correct to the best of my knowledge and belief and shows all the information required by law and the regulations issued and prescribed by the Office of Oil and Gas.

Day Ogden  
Signature


Land Manager  
Title

02/28/2018  
Date

RECEIVED  
Office of Oil and Gas

MAR 21 2019

WV Department of  
Environmental Protection

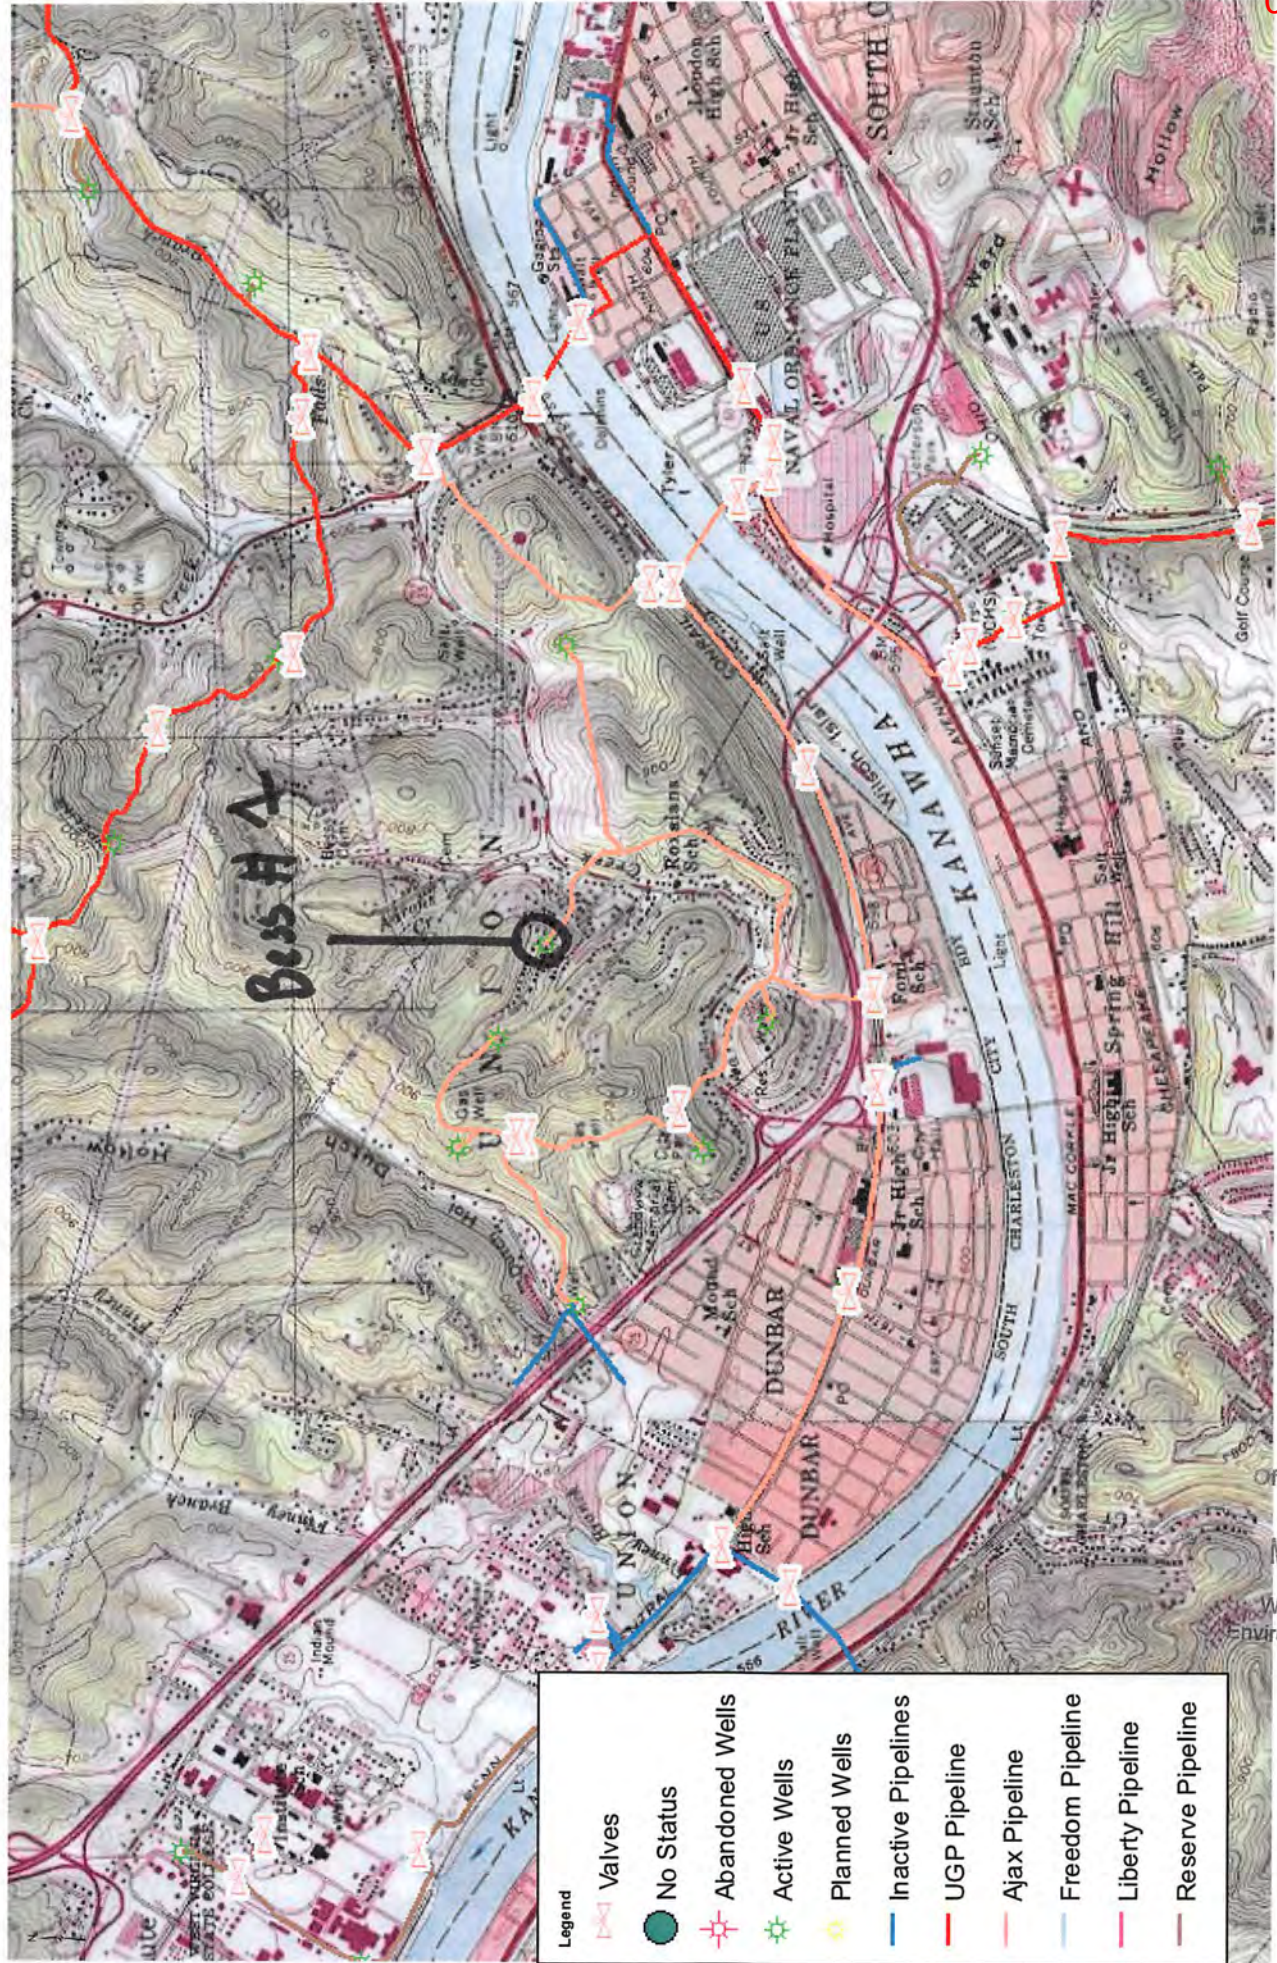

- Legend**
- Valves
  - No Status
  - Abandoned Wells
  - Active Wells
  - Planned Wells
  - Inactive Pipelines
  - UGP Pipeline
  - Ajax Pipeline
  - Freedom Pipeline
  - Liberty Pipeline
  - Reserve Pipeline

PREPARED BY DATE DETAILS Coordinate System: WGS 1984 Web Mercator Auxiliary Sphere Projection: Mercator Auxiliary Sphere Datum: WGS 1984 SCALE	Administrator 2/28/2018 WGS 1984 Web Mercator Auxiliary Sphere Mercator Auxiliary Sphere WGS 1984 1:35,496

RECEIVED  
 Office of Oil and Gas  
 Bess #1  
 MAR 21 2019  
 WV Department of  
 Environmental Protection

TITLE