


LATITUDE 38° 35'

LONGITUDE 81° 35' 30"

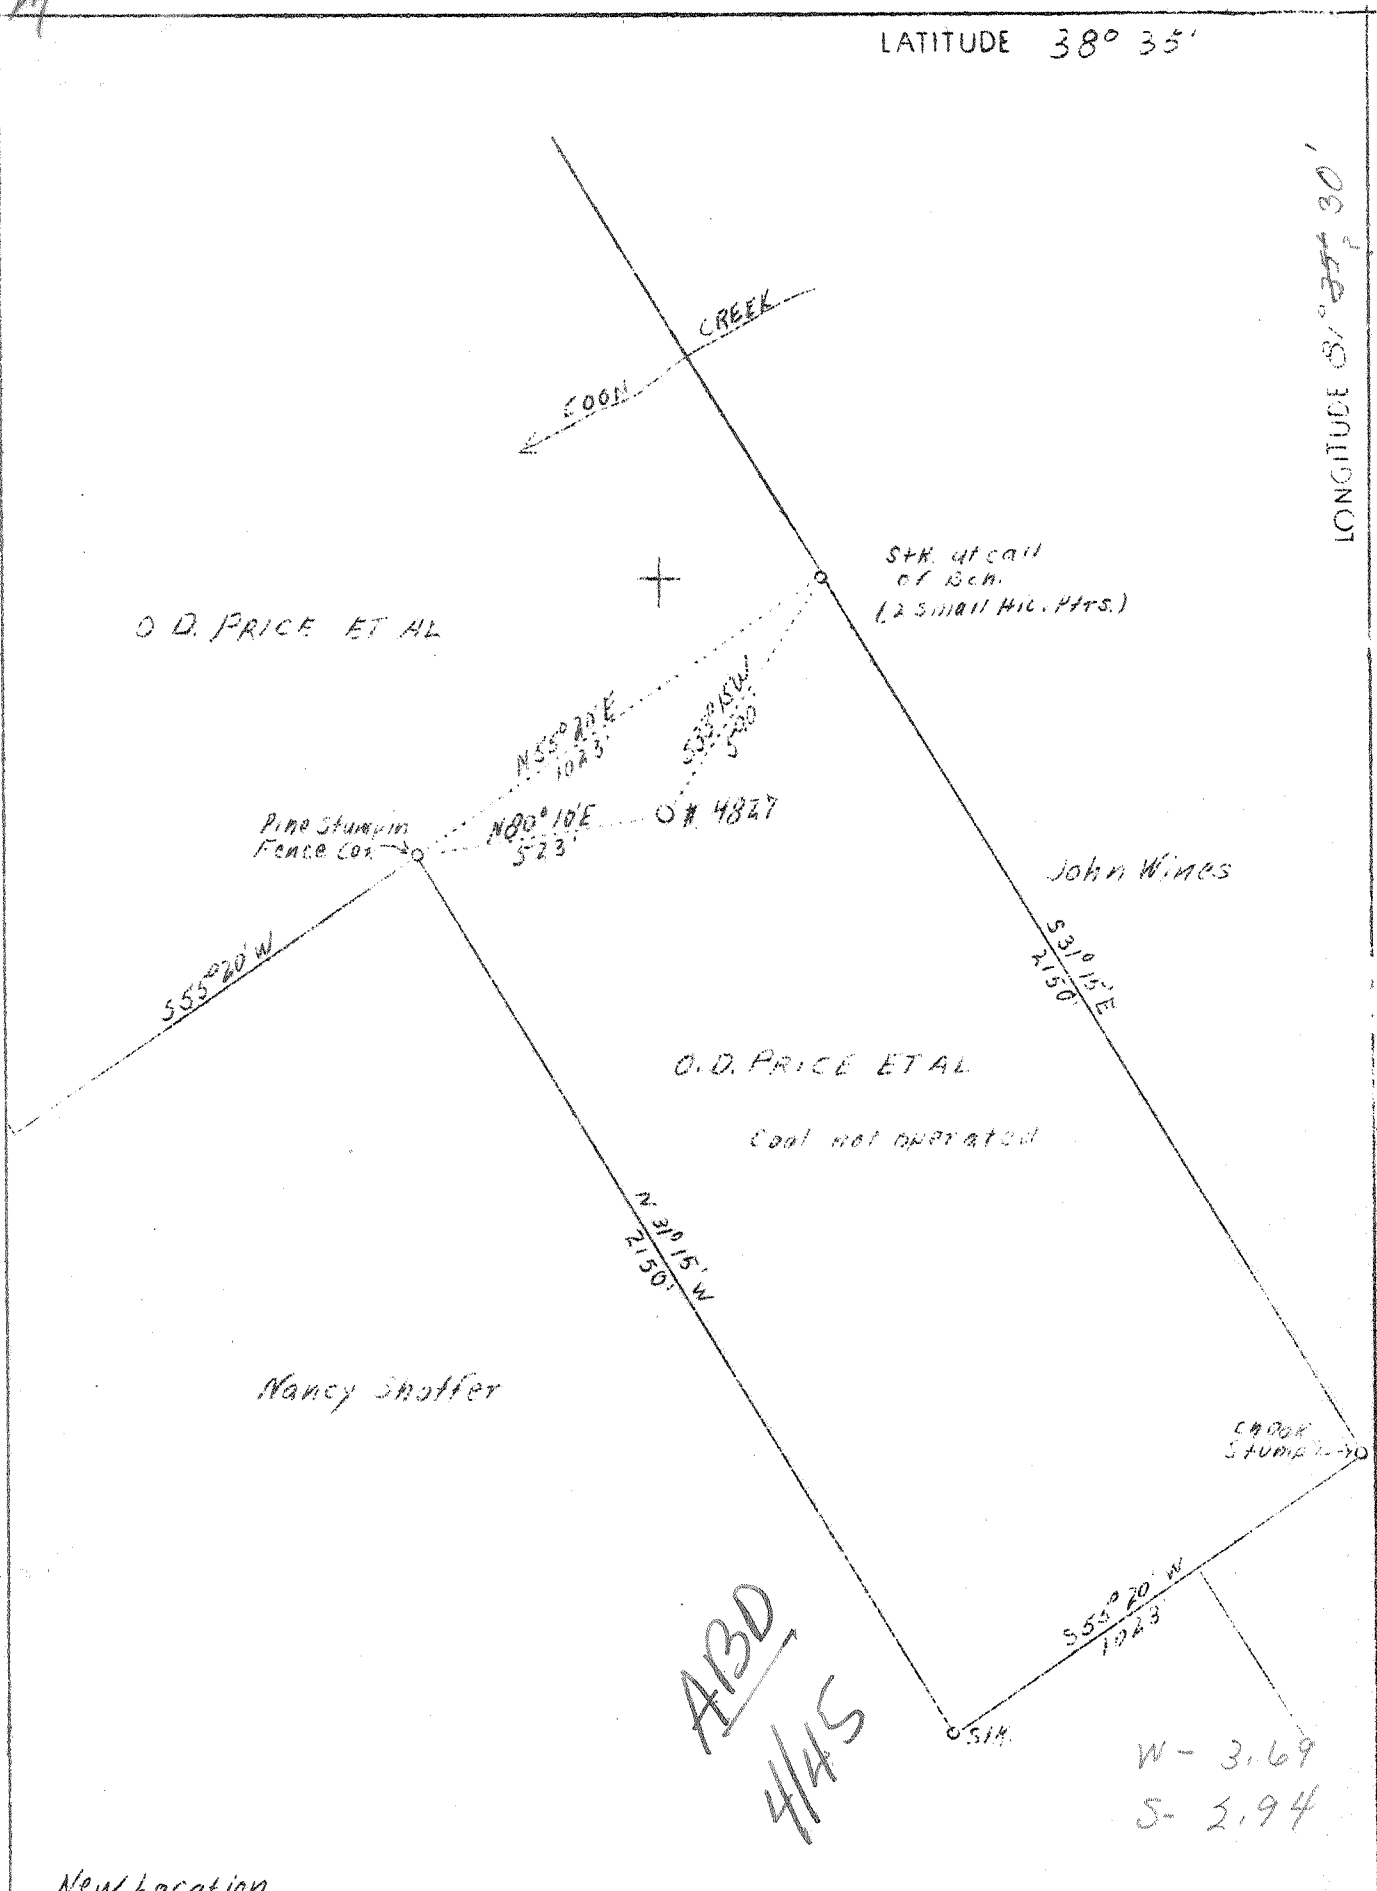

New Location

Company	United Fuel Gas Co.
Address	Charleston, W. Va.
Farm	O. D. Price, et al
Acres	54
Lease No.	42785
Well (Farm) No.	One
Serial No.	4827
Elevation	-
Quadrangle	Kenna <i>SE.</i>
County	Kanawha
District	Poca
Engineer	G. A. Cunningham
Eng. Reg. No.	659
File No.	64-71
Date	Dec. 19, 1938
Scale	1" - 400'

STATE OF WEST VIRGINIA
 Department of Mines
 OIL & GAS DIVISION
 Charleston

WELL LOCATION MAP
 File No. Kan-604

x Denotes location of well on U. S. Topographic Maps, scale 1 to 62,500, latitude and longitude lines being represented by border lines as shown.

- Denotes one inch spaces on border line of original tracing.

6-2-38

WEST VIRGINIA DEPARTMENT OF MINES

OIL & GAS DIVISION

WELL RECORD

Permit No. Kan-604

Gas Well

Kenna Quad.

CASING & TUBING

Company	United Fuel Gas Co.	13	14	14
Address	Charleston, W. Va.	10	541	541
Farm	O. D. Price, et al ACRES 54, 40 & 8	8-5/8	1904	1904
Location	Coon Creek	7	5020	5020
Well No.	4827 ELEV. 978.5			
District	Poca - Kanawha County			
Surface & Mineral Address	O. D. Price, et al, Sissonville, W. Va.			
Commenced	Jan. 14, 1939			
Completed	Apr. 27, 1939			
Shot	Not shot			
Open Flow	24/16ths Merc. in 7 inch			
Volume	7,647,000 c.f.			
Rock Pressure	1210 lbs. 48 hrs.			
Salt Water	1275			

Formation Color ^{Har}/₅ TOP Base Result Formation Color ^{Har}/₅ TOP Base Result

Formation	Color	^{Har} / ₅	TOP	Base	Result	Formation	Color	^{Har} / ₅	TOP	Base	Result
Soil				14							
Lime			14	35							
Blue Mud			35	123							
Red Rock			123	166							
Sand			166	218							
Red Rock			218	365							
Slate & Shells			365	448							
Red Rock			448	467							
Slate & Shells			467	513							
Red Rock			513	535							
Sand			535	560							
Slate & Shells			560	581							
Lime			581	668							
Slate & Shells			668	692							
Sand			692	720							
Slate & Shells			720	751							
Pink Rock			751	775							
Slate & Shells			775	816							
Sand			816	847							
Slate & Shells			847	908							
Sand			908	954							
Slate & Shells			954	995							
Sand			995	1050	Show oil	1050					
Slate & Shells			1050	1168							
Sand			1168	1252	Show Gas	1229					
Slate			1252	1258							
Salt Sand			1258	1550	Hole full water	1275					
Maxon			1550	1732							
Big Lime			1732	1868							
Injun			1868	1900	Oil and gas show	1878'					
Slate & Shells			1900	2295							
Brown Shale			2295	2312							
Berco Sand			2312	2318							
Slate & Shells			2318	3541							
Shale & Shells			3541	3622							
Slate & Shells			3622	3848							
Shale & Shells			3848	3950							
Slate & Shells			3950	3989							
Shale & Shells			3989	4197							
White Slate			4197	4652							
Slate & Shells			4652	4950							
Black Shale			4950	5005							
Corniferous Lime			5005	5126							
Oriskany Sand			5126	5149	Gas	5130-5132					
Total Depth				5149	Gas pay	5130-5148					