

WW-7
8-30-06



West Virginia Department of Environmental Protection
Office of Oil and Gas

WELL LOCATION FORM: GPS

API: 39-00620 WELL NO.: Solon Fletcher #1
 FARM NAME: Solon Fletcher
 RESPONSIBLE PARTY NAME: Shale Gas Production, LLC
 COUNTY: Kanawha DISTRICT: Union
 QUADRANGLE: Charleston West
 SURFACE OWNER: Michael K. Holley
 ROYALTY OWNER: Shale Gas Production, LLC
 UTM GPS NORTHING: 4246097.1
 UTM GPS EASTING: 435682.8 GPS ELEVATION: 578

The Responsible Party named above has chosen to submit GPS coordinates in lieu of preparing a new well location plat for a plugging permit or assigned API number on the above well. The Office of Oil and Gas will not accept GPS coordinates that do not meet the following requirements:

1. Datum: NAD 1983, Zone: 17 North, Coordinate Units: meters, Altitude: height above mean sea level (MSL) – meters.
2. Accuracy to Datum – 3.05 meters
3. Data Collection Method:

Survey grade GPS ____ : Post Processed Differential ____
 Real-Time Differential ____

Mapping Grade GPS ____ : Post Processed Differential ____
 Real-Time Differential ____

4. Letter size copy of the topography map showing the well location.


I the undersigned, hereby certify this data is correct to the best of my knowledge and belief and shows all the information required by law and the regulations issued and prescribed by the Office of Oil and Gas.

Doyle Doyle
Signature

Land Manager
Title

11-17-15
Date

Received
Office of Oil & Gas
NOV 19 2015

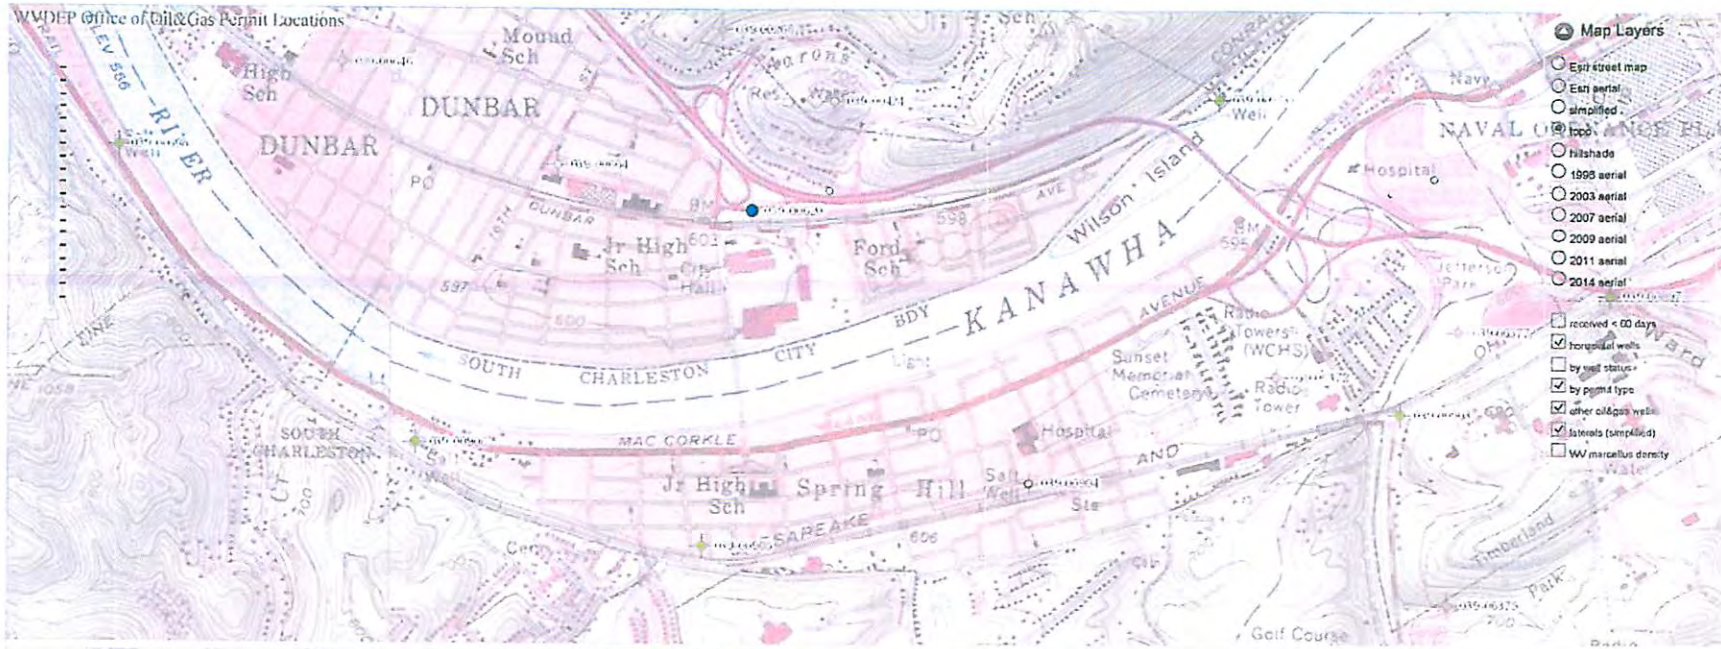

Attribute Search Results Legend Location Search About

API	Permit Type	Received	Issued	Complete	Operator	Formation	Well Status	Well Type	Well Use	Farm Name	Well No.	Lon	Lat
039-00620	Other Well	NA	1939-06-19	NA	AJAX PIPELINE COMPANY	Not Available	Active Well	Not Available	Not Available	Fletcher, Solon	1	-81.736166	38.380735

RECEIVED
Office of Oil and Gas

NOV 20 2015

WV Department of
Environmental Protection