

WW-7  
8-30-06



West Virginia Department of Environmental Protection  
Office of Oil and Gas

**WELL LOCATION FORM: GPS**

API: 47-39-00664 WELL NO.: RW Saunders  
 FARM NAME: RW Saunders  
 RESPONSIBLE PARTY NAME: Monument Oil & Gas, LLC  
 COUNTY: Kanawha DISTRICT: Union  
 QUADRANGLE: Charleston SW  
 SURFACE OWNER: GMC Real Estate LLC  
 ROYALTY OWNER: Shale Gas Production LLC  
 UTM GPS NORTHING: 4246178.64  
 UTM GPS EASTING: 434966.26 GPS ELEVATION: 574

The Responsible Party named above has chosen to submit GPS coordinates in lieu of preparing a new well location plat for a plugging permit or assigned API number on the above well. The Office of Oil and Gas will not accept GPS coordinates that do not meet the following requirements:

1. Datum: NAD 1983, Zone: 17 North, Coordinate Units: meters, Altitude: height above mean sea level (MSL) – meters.
2. Accuracy to Datum – 3.05 meters
3. Data Collection Method:

Survey grade GPS \_\_\_\_ : Post Processed Differential \_\_\_\_

Real-Time Differential \_\_\_\_

Mapping Grade GPS X : Post Processed Differential \_\_\_\_

Real-Time Differential \_\_\_\_

4. Letter size copy of the topography map showing the well location.

I the undersigned, hereby certify this data is correct to the best of my knowledge and belief and shows all the information required by law and the regulations issued and prescribed by the Office of Oil and Gas.


*LC 101*  
Signature

Land Manager  
Title

11/30/21  
Date

01/07/2022

# RW Saunders Well

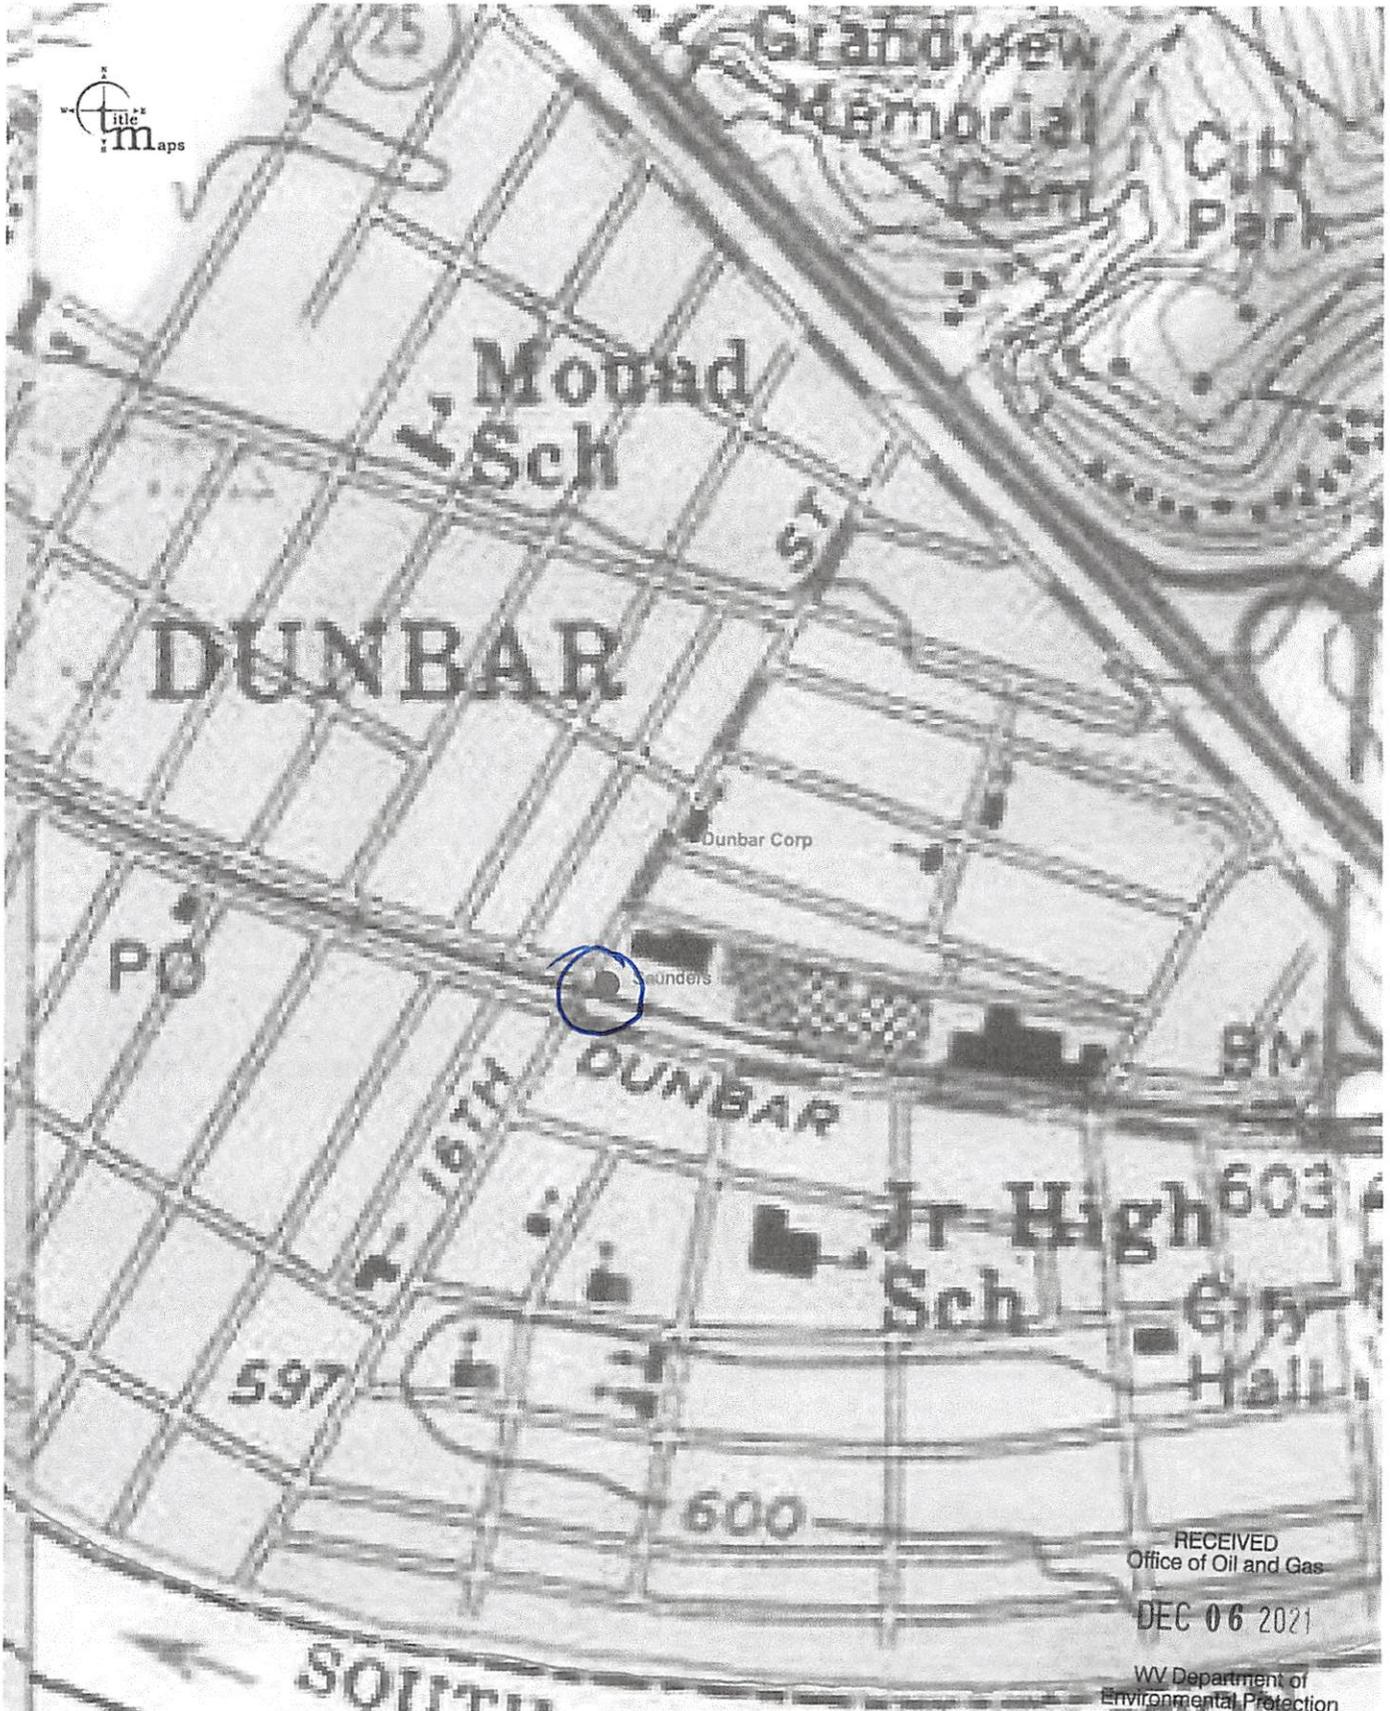

500ft

Approximate Scale 1:6,000

11/29/2021 - 03:29:52 PM

Disclaimer: The map information shown is from various sources including but not limited to tax maps and city agency web sites. The map information does not constitute a legal survey or legal depiction of the property or information shown. Title Maps LLC does not warrant the accuracy or correctness of the map information shown hereon.