

Company UNITED FUEL GAS CO.  
 Address CHARLESTON, W.VA.  
 Farm ALLIE PRITT ETAL  
 Tract 5 Acres 165.8 Lease No. 40818  
 Well (Farm) No. 1 Serial No. 4880  
 Elevation (Spirit Level) 851.2 GROUND  
 Quadrangle KENNA  
 County KANAWHA District POCA  
 Engineer \_\_\_\_\_  
 Engineer's Registration No. 659  
 File No. 60-71 Drawing No. \_\_\_\_\_  
 Date SEPT. 16, 1940 Scale 1" = 660'

STATE OF WEST VIRGINIA  
 DEPARTMENT OF MINES  
 OIL AND GAS DIVISION  
 CHARLESTON

**WELL LOCATION MAP**  
 FILE NO. **KAN-696R**

+ Denotes location of well on United States Topographic Maps, scale 1 to 62,500, latitude and longitude lines being represented by border lines as shown.

- Denotes one inch spaces on border line of original tracing

WEST VIRGINIA DEPARTMENT OF MINES  
OIL & GAS DIVISION  
W E L L R E C O R D

Permit No. Kan-696R  
Kenna Quad.

Gas Well

Company United Fuel Gas Co.  
Address Charleston, W. Va.  
Farm Allie Pritt, et al ACRES 60  
Location First Creek  
Well No. 4880 ELEV. 855.39  
District Poca - Kanawha County  
Surface & Mineral Allie Pritt, et al, Sissonville, W. Va.  
Commenced Oct. 4, 1940  
Completed Jan. 14, 1941  
Shot 1/16/41 - depth 5014  
Volume Gas Well  
Rock Pressure -  
Salt Water 1315 and 1350

CASING & TUBING

10	707	707
8-1/4	1967	1967
7	4919	4919

Surface	0	16	Slate	1966	1971	
Sand	16	40	Lime Shells	1971	1985	
Slate	40	52	Slate & Shells	1985	2367	
Red Rock	52	62	Br. Shale - <i>coffee</i>	2367	2370	
Sand	62	97	Berea	2370	2381	
Slate	97	135	Slate & Shells	2381	3575	
Red Rock	135	142	Br. Shale - 441	3575	3615	
Slate	142	165	Slate & Shells	3615	4000	
Red Rock	165	185	Br. Shale	4000	4147	
Slate	185	255	White Slate	4147	4575	
Red Rock	255	280	Br. Shale	4575	4810	
Slate	280	300	White Slate	4810	4828	
Red Rock	300	335	Black Shale - <i>Mucellus</i>	4828	4904	
Slate	335	350	Corniferous Lime	4904	5014	Gas 5014-
Sand	350	370				5019
Red Rock	370	402	Oriskany Sand	5014	5047	Gas 5027-
Sand	402	430				5030
Slate & Shells	430	495	Total Depth	5047	SL	Gas 5038-
Red Rock	495	510				5044
Sand	510	556				
Slate	556	565				
Sand	565	600				
Slate & Shells	600	660				
Sand	660	735				
Slate & Shells	735	865				
Sand	865	945				
Slate & Shells	945	1000				
Sand	1000	1029				
Slate & Shells	1029	1094				
Sand	1094	1110				
Slate & Shells	1110	1185				
Sand	1185	1220				
Slate	1220	1224				
Sand	1224	1245				
Slate & Shells	1245	1260				
Salt Sand	1260	1628	W 1315			
Slate	1628	1630	W 1350 HF			
Maxon Sand	1630	1665				
Slate & Shells	1665	1673				
Sand	1673	1708				
Little Lime	1708	1728				
Big Lime	1728	1893				
Injun	1893	1953				
Slate	1953	1961				
Sand - <i>Squaw?</i>	1961	1966				

4904    5014  
 855    855  
 -----  
 4049    4159

475

STATE OF WEST VIRGINIA  
DEPARTMENT OF MINES  
OIL AND GAS DIVISION 5

WELL RECORD

Permit No. KAN-696-Re-Drill W

Oil or Gas Well Gas  
(KIND)

Company UNITED FUEL GAS COMPANY  
Address P.O. Box 1273, Charleston 25, W. Va.  
Farm Shelly E. Pritt, et al Acres 61.8  
Location (waters) First Creek  
Well No. X-5-7275 Elev. 851.2  
District Poca County Kanawha  
The surface of tract is owned in fee by \_\_\_\_\_  
Address \_\_\_\_\_  
Mineral rights are owned by Shelly Pritt, et al  
205 Wilson St., Dunbar, W. Va. & Faye Holstein  
Drilling commenced 10-1-40  
Drilling completed 1-14-41  
Date Shot 3-16-41 From 5014 To 5045  
With 60 qts.  
Open Flow 38/10ths Water in \_\_\_\_\_ 7 Inch  
\_\_\_\_\_/10ths Merc. in \_\_\_\_\_ Inch  
Volume 2,918,000 Cu. Ft.  
Rock Pressure 600 lbs. 48 hrs.  
Oil \_\_\_\_\_ bbls., 1st 24 hrs.  
Fresh water 1315' feet feet  
Salt water 1350' feet feet

Casing and Tubing	Used in Drilling	Left in Well	Packers
Size			Kind of Packer
16			
18			
10 - 3/4"		707'	Size of
8 3/4 - 5/8"		1967'	
5 3/8 - 7"		4919'	Depth set
3			Perf. top
2			Perf. bottom
Liners Used			Perf. top
			Perf. bottom


CASING CEMENTED \_\_\_\_\_ SIZE \_\_\_\_\_ No. Ft. \_\_\_\_\_ Date \_\_\_\_\_

COAL WAS ENCOUNTERED AT \_\_\_\_\_ FEET \_\_\_\_\_ INCHES

\_\_\_\_\_ FEET \_\_\_\_\_ INCHES \_\_\_\_\_ FEET \_\_\_\_\_ INCHES

\_\_\_\_\_ FEET \_\_\_\_\_ INCHES \_\_\_\_\_ FEET \_\_\_\_\_ INCHES

Formation	Color	Hard or Soft	Top	Bottom	Oil, Gas or Water	Depth Found	Remarks
Surface			0	16			
Sand			16	40			
Slate			40	52			
Red Rock			52	62			
Sand			62	97			
Slate			97	135			
Red Rock			135	142			
Slate			142	165			
Red Rock			165	185			
Slate			185	255			
Red Rock			255	280			
Slate			280	300	Water 1315'		
Red Rock			300	335	Hole full water 1350'		
Slate			335	350			
Sand			350	370	Show gas 5014'		
Red Rock			370	402	Gas 5019, 8/10 W 7" 2 1/2# 1,196 M		
Sand			402	430	Gas 5021, 8/10 W 7" 2 1/2# 1,196 M		
Slate & Shells			430	495	Gas 5022, 8/10 W 7" 2 1/2# 1,196 M		
Red Rock			495	510	Gas 5027, 12/10 W 7" 2 1/2# 1,465 M		
Sand			510	556	Gas 5030, 15/10 W 7" 2 1/2# 1,639 M		
Slate			556	565	Gas 5031, 13/10 W 7" 2 1/2# 1,525 M		
Sand			565	600	Gas 5034, 13/10 W 7" 2 1/2# 1,525 M		
Slate & Shells			600	660	Gas 5037, 12/10 W 7" 2 1/2# 1,465 M		
Sand			660	735	Gas 5038-5044, 18/10 W 7" 2 1/2# 1,796 M		
Slate & Shells			735	865	Show water 5044-5047'		
Sand			865	945	Show gas 5014--		
Slate & Shells			945	1000			
Sand			1000	1029			
Slate & Shells			1029	1094	Test before shot 14/10 W 7" 22# 1,614 M		
Sand			1094	1110	Shot 1-16-41 with 60 qts. (open show)		
Slate & Shells			1110	1185	from 5014-5045'		
Sand			1185	1220	Test 1 hr. after shot 38/10 W 7" 22# 2,6		
Slate			1220	1224	59 M		
Sand			1224	1245	Final Open Flow - 2,918 M - Criskany		
Slate & Shells			1245	1260	48 Hr. R.P. 600%		
Salt Sand			1260	1628			
Slate			1628	1630			
Maron			1630	1665			
Slate & Shells			1665	1673			
Sand			1673	1708			
Little Lime			1708	(Over) 1728			

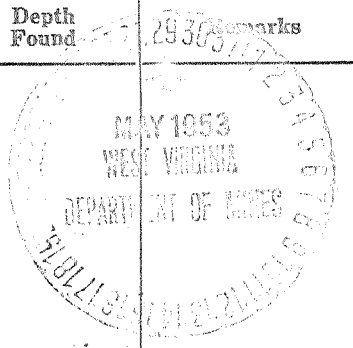

Formation	Color	Hard or Soft	Top <sup>5</sup>	Bottom	Oil, Gas or Water	Depth Found	Remarks
Big Lime			1728	1893			
Injun Slate			1892	1953			
Slate			1953	1961			
Sand			1961	1966			
Slate			1966	1971			
Lime Shells			1971	1985			
Slate & Shells			1985	2367			
Brown Shale			2367	2370			
Berea			2370	2381			
Slate & Shells			2381	3575			
Brown Shale			3575	3615			
Slate & Shells			3615	4000			
Brown Shale			4000	4147			
White Slate			4147	4575			
Brown Shale			4575	4810			
White Slate			4810	4828			
Black Shale			4828	4904			
Corniferous Lime			4904	5014			
Criskany Lime			5014	5047			
Total depth			5047' SLM				

475  
RE-DRILL

Note: This well was drilled out to bottom of Big Lime to be used for storage.

Total depth - 1893'  
Open flow - 18 M - Gas 1808-1847, 18 M  
Completed Drilling Out 2-13-53  
24 Hr. R.P. 170#

Size	Casing	Point
10"		705'
7"		1774'
2" Tubing		1893'

Date MAY 28, 19 53

APPROVED UNITED FUEL GAS COMPANY, Owner

By \_\_\_\_\_ (TWO)