

4703900954P

WW-7
8-30-06



West Virginia Department of Environmental Protection
Office of Oil and Gas

WELL LOCATION FORM: GPS

API: 47-039-00954 WELL NO.: Jones A-10

FARM NAME: Homer C. Jones

RESPONSIBLE PARTY NAME: Trevor L. Schaffer

COUNTY: Kanawha DISTRICT: Poca

QUADRANGLE: Romance

SURFACE OWNER: Slater, Jeffery A.

ROYALTY OWNER: Multiple (attached)

UTM GPS NORTHING: 4269123.30

UTM GPS EASTING: 450824.00 GPS ELEVATION: 656.50

The Responsible Party named above has chosen to submit GPS coordinates in lieu of preparing a new well location plat for a plugging permit or assigned API number on the above well. The Office of Oil and Gas will not accept GPS coordinates that do not meet the following requirements:

1. Datum: NAD 1983, Zone: 17 North, Coordinate Units: meters, Altitude: height above mean sea level (MSL) – meters.
2. Accuracy to Datum – 3.05 meters
3. Data Collection Method:

Survey grade GPS ____: Post Processed Differential ____
Real-Time Differential ____

Mapping Grade GPS ____: Post Processed Differential ____
Real-Time Differential ____

RECEIVED
Office of Oil and Gas

MAY 10 2021

WV Department of
Environmental Protection

4. Letter size copy of the topography map showing the well location.

I the undersigned, hereby certify this data is correct to the best of my knowledge and belief and shows all the information required by law and the regulations issued and prescribed by the Office of Oil and Gas.

Trevor L. Schaffer
Signature


COO
Title

4/20/2021
Date

06/18/2021

4703900954P

USGS Map Name: Romance, WV Map MRC: 38081E5
Map Center: N38.56575° W81.55962° Datum: NAD83 Zoom: 4m/pixel

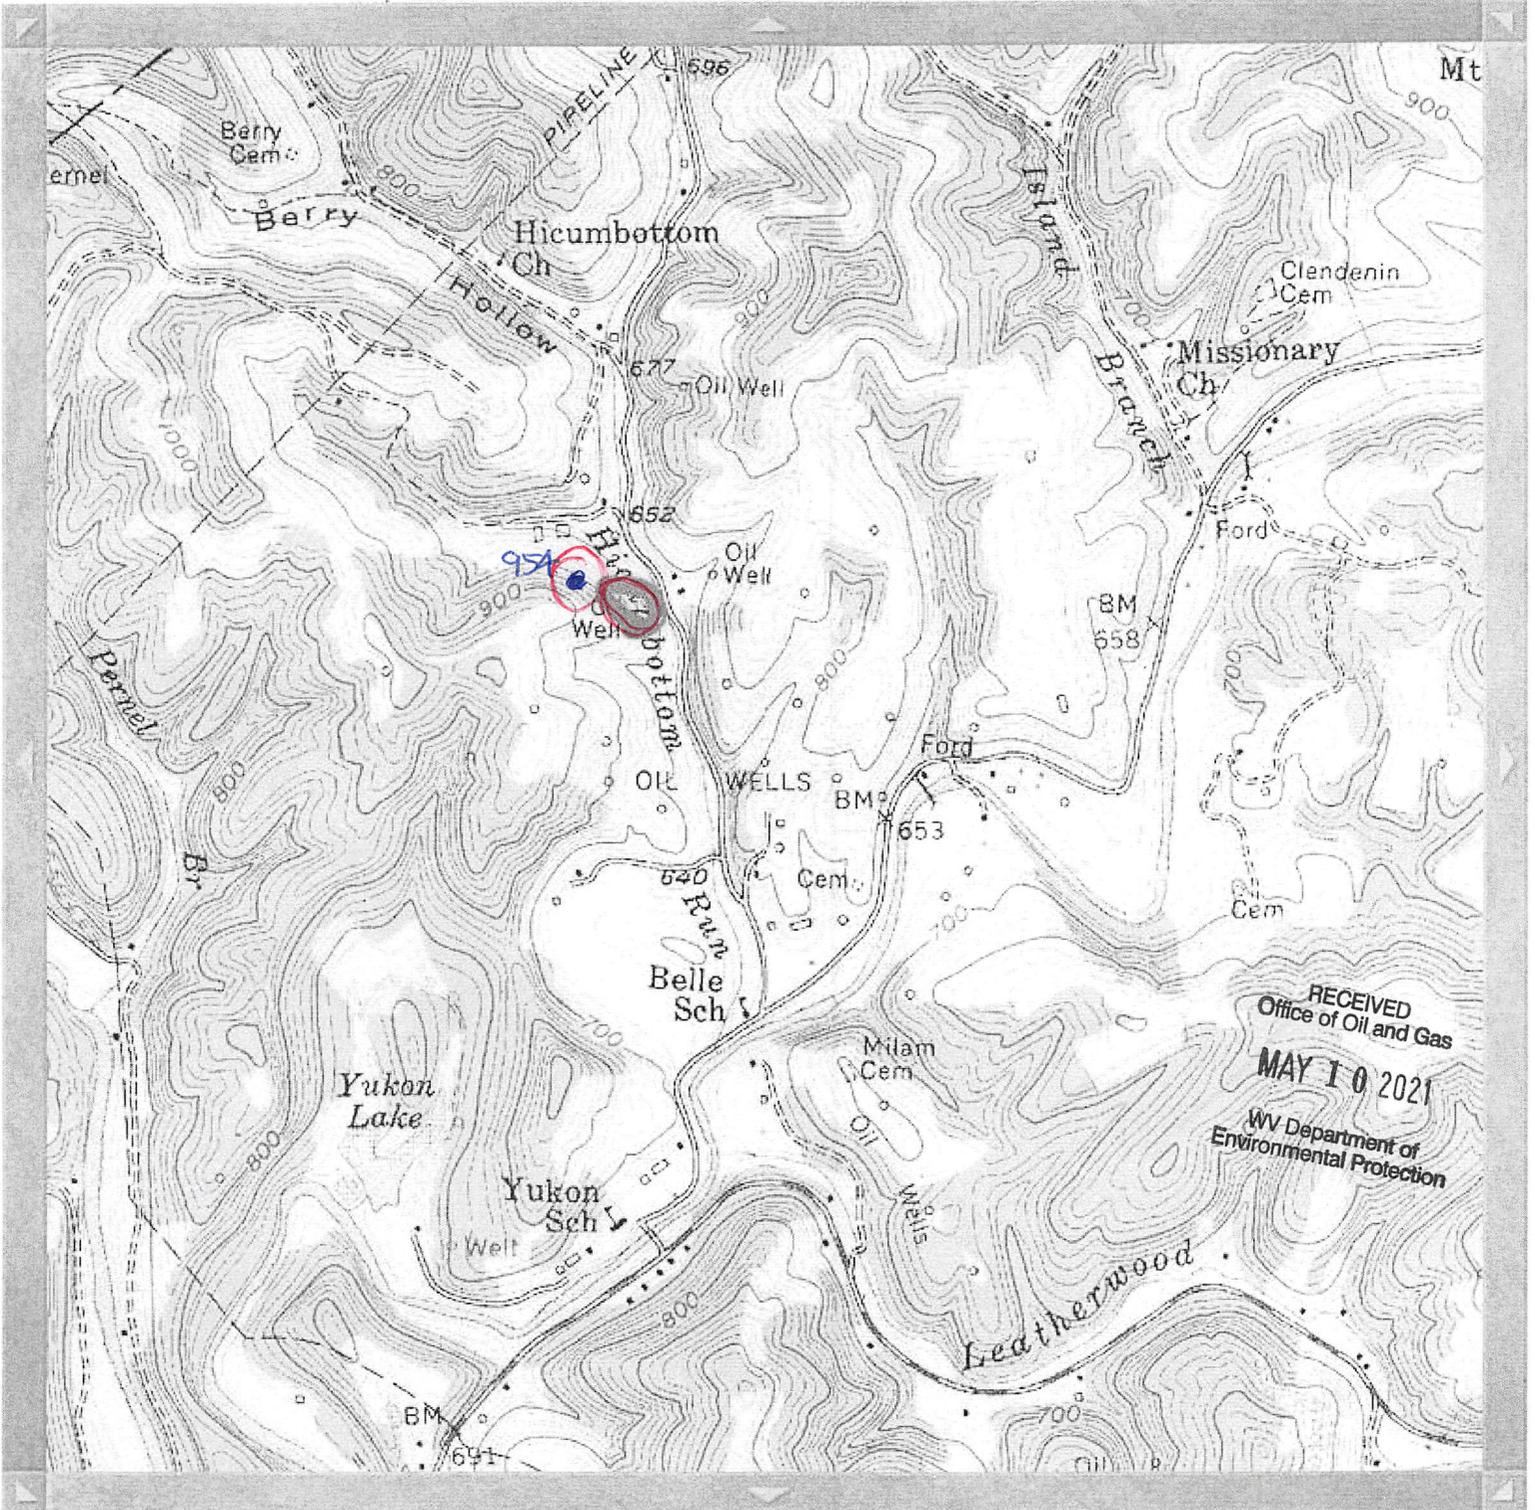

06/18/2021