

STATE OF WEST VIRGINIA
DEPARTMENT OF ENVIRONMENTAL PROTECTION
OFFICE OF OIL AND GAS



ORIGINAL

AFFIDAVIT OF PLUGGING AND FILLING WELL

AFFIDAVIT SHOULD BE IN TRIPLICATE, one copy mailed to the Department, one copy to be retained by the Well Operator and the third copy (and extra copies if required) should be mailed to each coal operator at their respective addresses.

Farm name: Matt Amos, Et Al Operator Well No.: Coco B 7230

LOCATION: Elevation: 776 Quadrangle: Blue Creek, WV
District: Elk County: Kanawha
Latitude: 2801 Feet South of 38 Deg. 25 Min. 00 Sec.
Longitude: 4919 Feet West of 81 Deg. 27 Min. 30 Sec.

Well Type: OIL _____ GAS X _____

Company Columbia Gas Transmission, LLC Coal Operator Not Operated
1700 MacCorkle Avenue S.E. or Owner _____
Charleston, WV 25314 _____

Agent Maria Medvedeva Coal Operator _____
or Owner _____

Permit Issued Date 03/29/2021

RECEIVED
Office of Oil and Gas

AFFIDAVIT

MAY 27 2022

STATE OF WEST VIRGINIA,
County of Kanawha ss:

WV Department of
Environmental Protection


Maria Medvedeva and Nathan Salyers being first duly sworn according to law depose and say that they are experienced in the work of plugging and filling oil and gas wells and were employed by the above named well operator, and participated in the work of plugging and filling the above well say that said work was commenced on the 31 day of March, 2022, and the well was plugged and filled in the following manner:

TYPE	FROM	TO	PIPE REMOVED	LEFT
15.6 ppg Class A Cement	5120	5047	N/A	openhole
15.6 ppg Class A Cement	5047	4968	N/A	7"
15.6 ppg Class A Cement	4968	3952	3-1/2"	7"
Cast Iron Bridge Plug	3952	3952	3-1/2"	7"
15.6 ppg Class A Cement	3952	1968	3-1/2"	7"
15.6 ppg Class A Cement	1968	1290	3-1/2"	7", 8-5/8"
Cement Retainer	1290	1290	3-1/2"	7", 8-5/8"

See additional plugging data.

Description of monument: 7" casing, 4' above ground level, API number affixed and that the work of plugging and filling said well was completed on the 03 day of May, 2022.

And further deponents saith not. Nathan Salyers
Maria Medvedeva

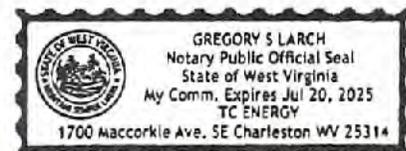

Sworn and subscribe before me this 19 day of May, 2022

My commission expires: 7/20/2025
Notary Public

Affidavit reviewed by the Office of Oil and Gas: [Signature] Title: Inspector Oil & Gas


06/03/2022

~ not to scale ~

SCSSSV as integral part of tubing from 62 to 82 ft

COCO B 7230

Prior to P&A
(as of 10/20/2020)

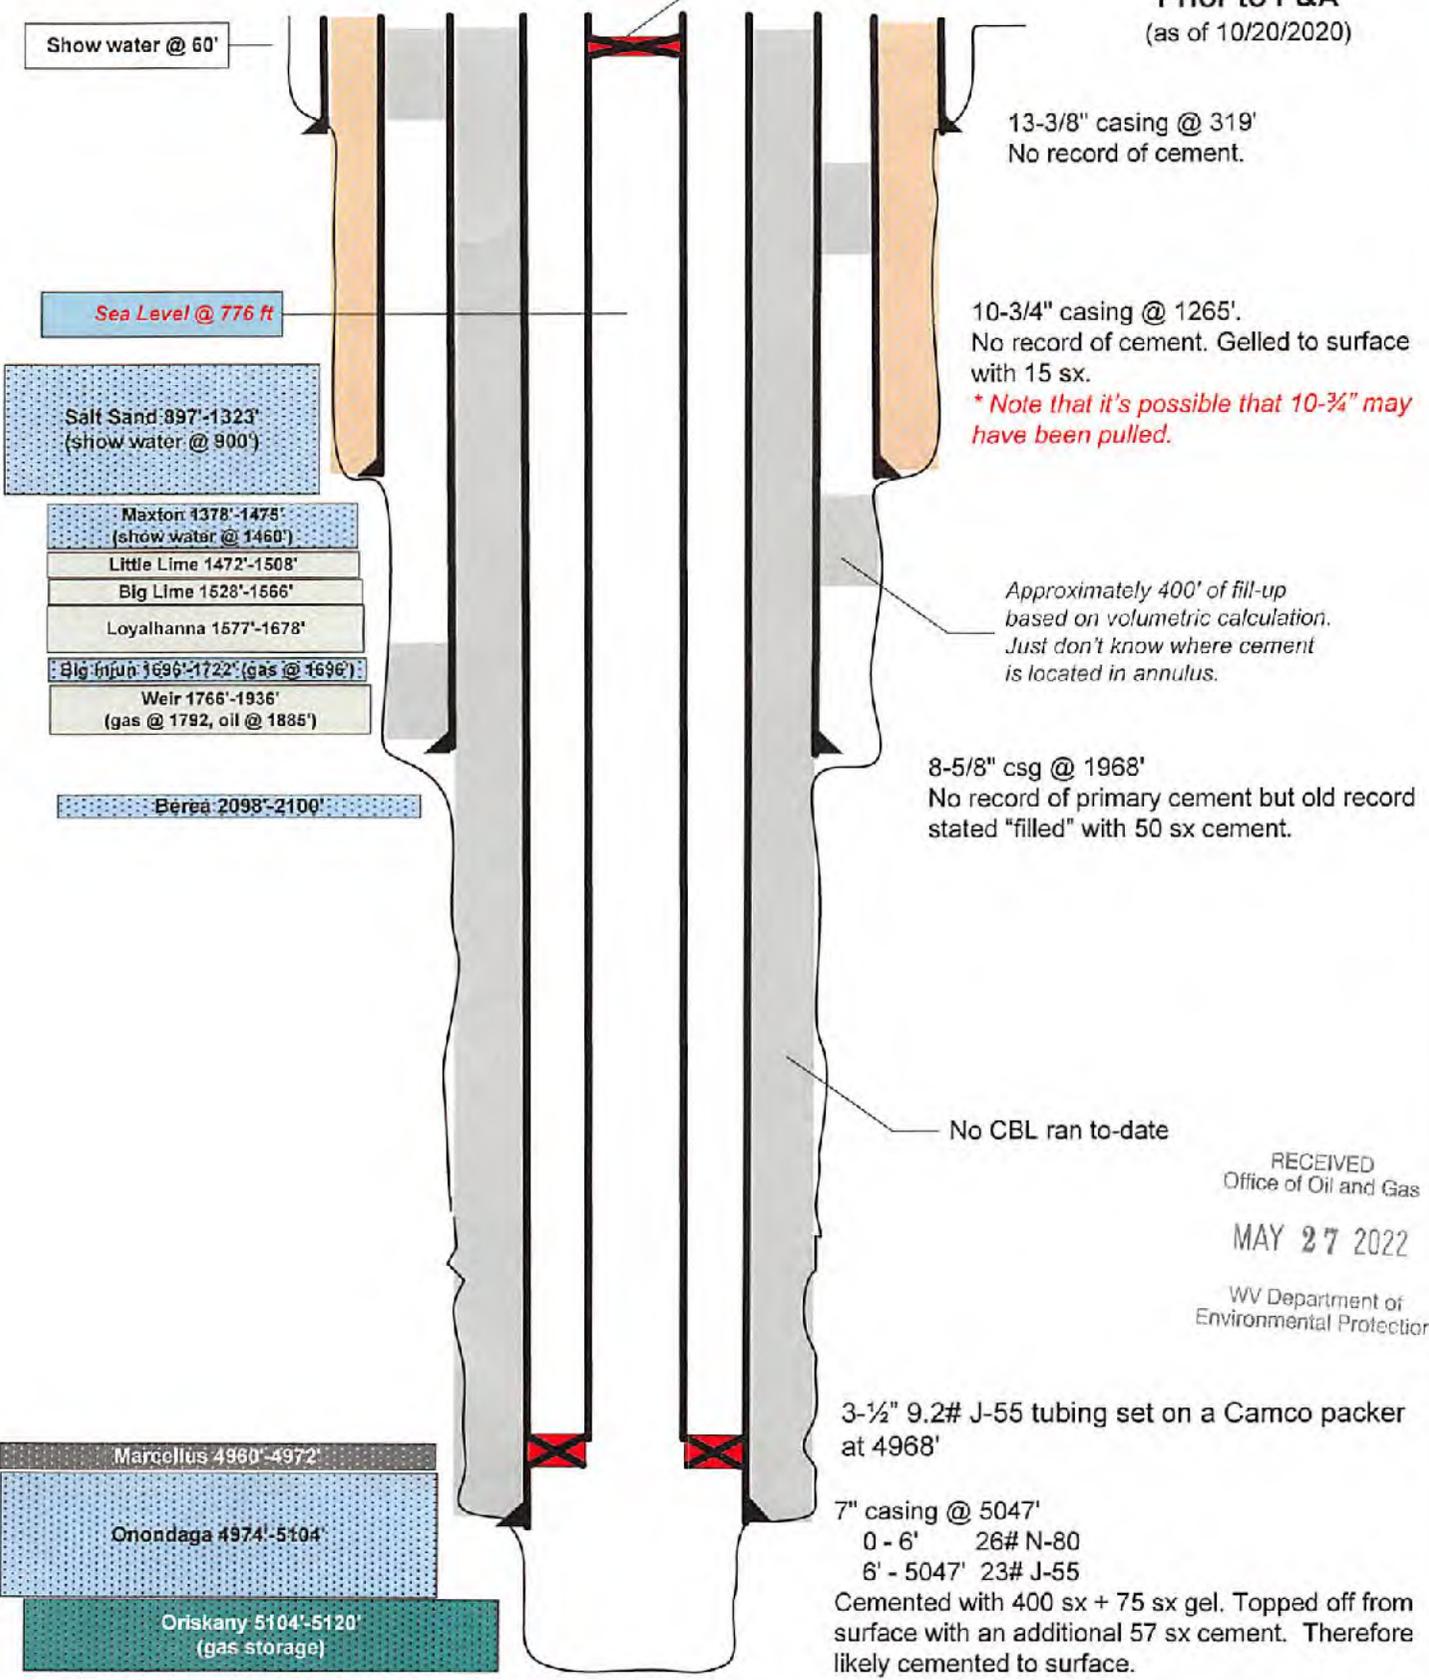

Show water @ 60'

Sea Level @ 776 ft

Salt Sand 897'-1323'
(show water @ 900')

Maxton 1378'-1478'
(show water @ 1460')

Little Lime 1472'-1508'

Big Lime 1528'-1566'

Loyalhanna 1577'-1678'

Big Injun 1696'-1722' (gas @ 1696')

Weir 1766'-1936'
(gas @ 1792, oil @ 1885')

Berea 2098'-2100'

Marcellus 4960'-4972'

Onondaga 4974'-5104'

Oriskany 5104'-5120'
(gas storage)

13-3/8" casing @ 319'
No record of cement.

10-3/4" casing @ 1265'.
No record of cement. Gelled to surface with 15 sx.
** Note that it's possible that 10-3/4" may have been pulled.*

Approximately 400' of fill-up based on volumetric calculation. Just don't know where cement is located in annulus.

8-5/8" csg @ 1968'
No record of primary cement but old record stated "filled" with 50 sx cement.

No CBL ran to-date

3-1/2" 9.2# J-55 tubing set on a Camco packer at 4968'

7" casing @ 5047'
0 - 6' 26# N-80
6' - 5047' 23# J-55

Cemented with 400 sx + 75 sx gel. Topped off from surface with an additional 57 sx cement. Therefore likely cemented to surface.

TD 5120'

RECEIVED
Office of Oil and Gas
MAY 27 2022
WV Department of
Environmental Protection


06/03/2022

~ not to scale ~

COCO B 7230

Post P&A

(as of 05/03/2022)

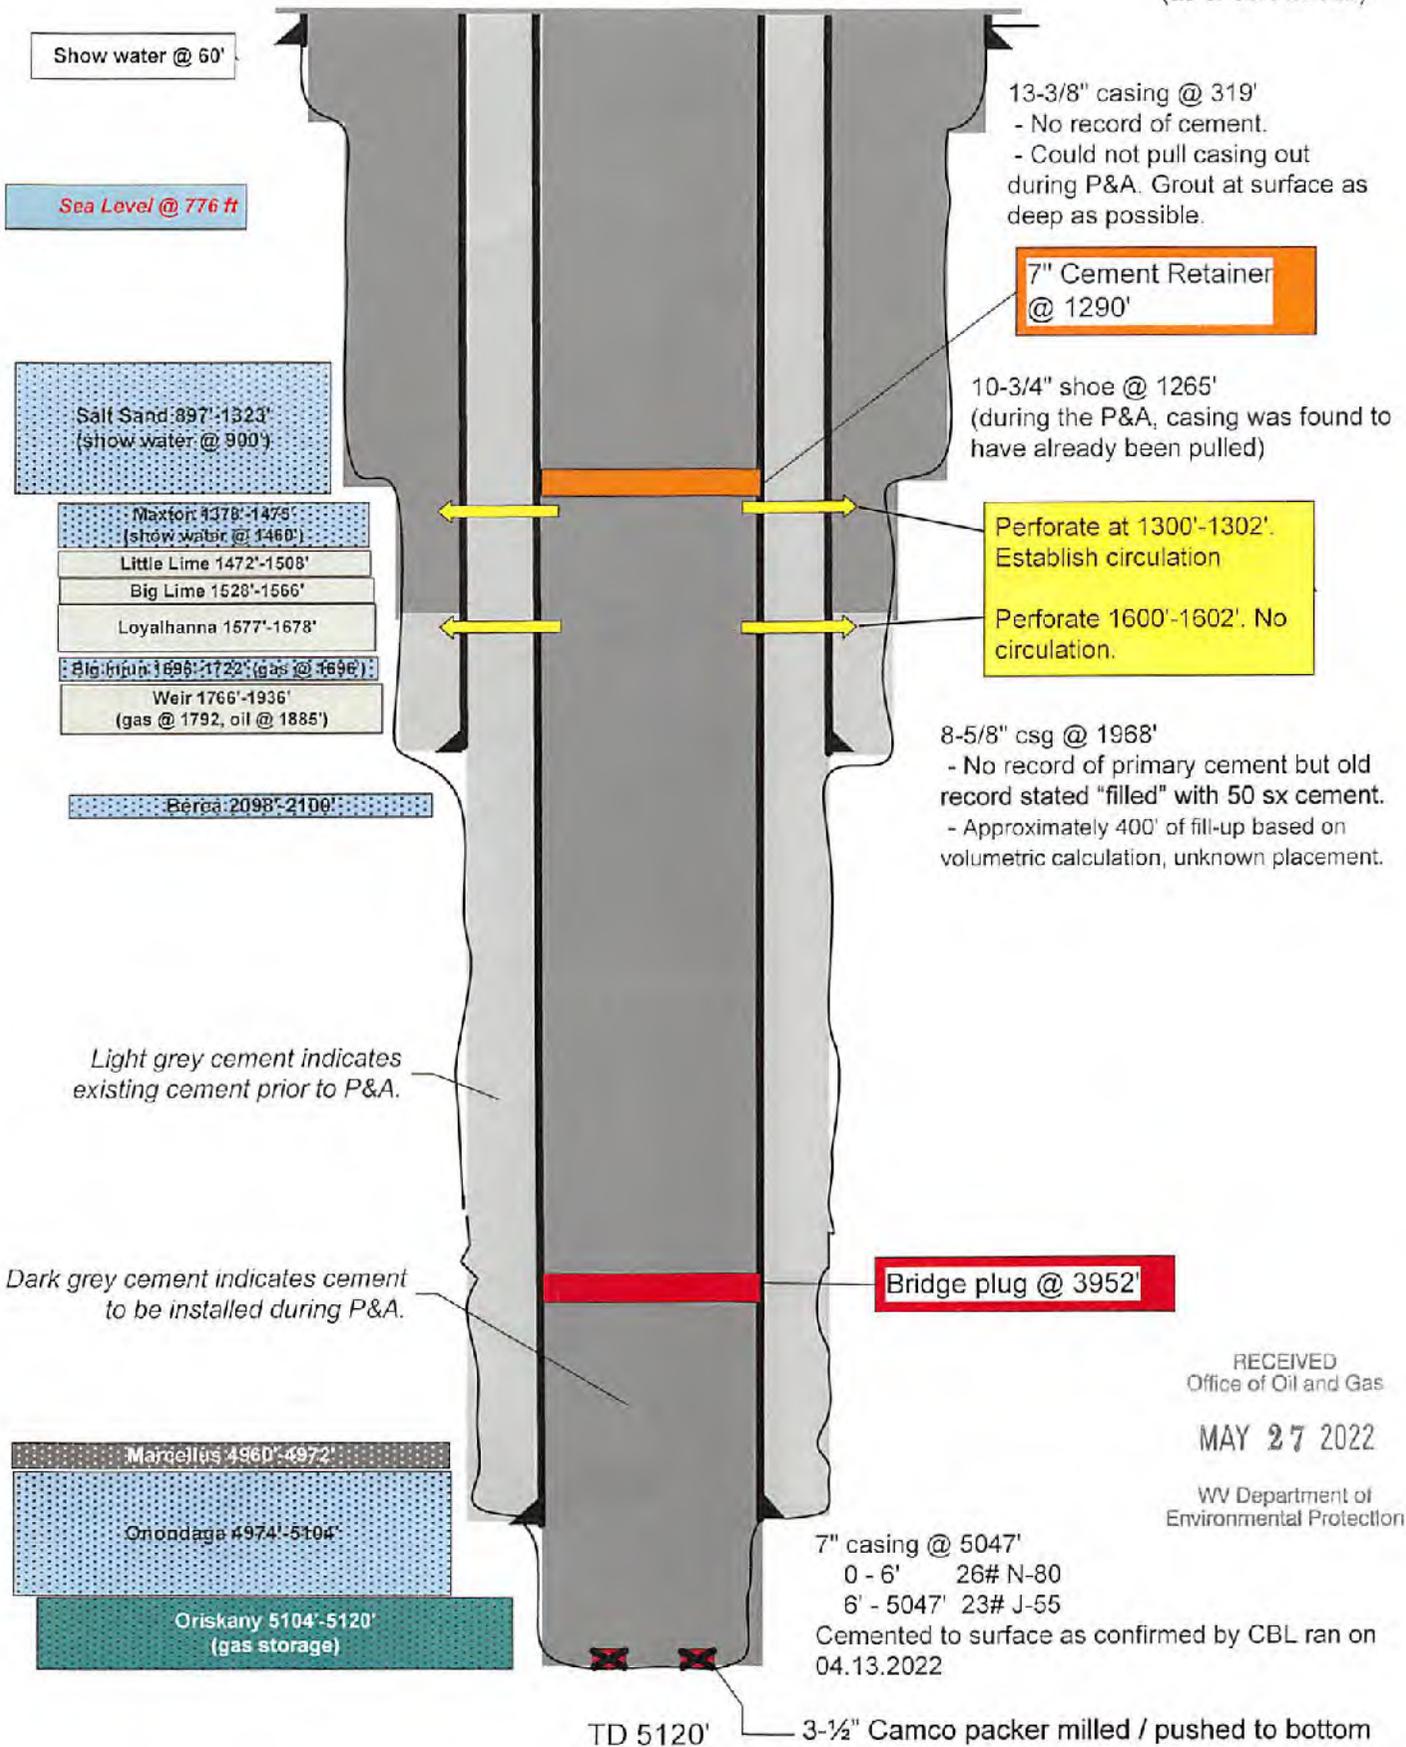

RECEIVED
Office of Oil and Gas

MAY 27 2022

WV Department of
Environmental Protection

06/03/2022

Columbia Gas Transmission, LLC
1700 MacCorkle Ave., SE, Charleston, WV, USA 25314



May 25, 2022

WV DEP – Office of Oil & Gas
601 57th Street, SE
Charleston, WV 25304-2345

Enclosed are post well plugging and abandonment permit applications for the following Columbia Gas Transmission storage well:

Coco B 7230 (039-01585)

If you have questions, feel free to call.

Regards,

A handwritten signature in blue ink, appearing to read "Maria Medvedeva", written over a light blue circular stamp.

Maria Medvedeva
Senior Wells Engineer
Well Engineering & Technology
Columbia Gas Transmission, LLC
Off: 304-357-2445
Mob: 304-410-4313
maria_medvedeva@tcenergy.com

RECEIVED
Office of Oil and Gas

MAY 27 2022

WV Department of
Environmental Protection