

WW-7  
8-30-06



West Virginia Department of Environmental Protection  
Office of Oil and Gas  
**WELL LOCATION FORM: GPS**

API: 47-039-01935 WELL NO.: Blue Creek A-3

FARM NAME: Blue Creek Coal & Land

RESPONSIBLE PARTY NAME: \_\_\_\_\_

COUNTY: Kanawha DISTRICT: ELK

QUADRANGLE: Quick

SURFACE OWNER: Blue Eagle Land

ROYALTY OWNER: Blue Eagle Land

UTM GPS NORTHING: 4244321

UTM GPS EASTING: 0465690 GPS ELEVATION: 1043'

The Responsible Party named above has chosen to submit GPS coordinates in lieu of preparing a new well location plat for a plugging permit or assigned API number on the above well. The Office of Oil and Gas will not accept GPS coordinates that do not meet the following requirements:

1. Datum: NAD 1983, Zone: 17 North, Coordinate Units: meters, Altitude: height above mean sea level (MSL) – meters.
2. Accuracy to Datum – 3.05 meters
3. Data Collection Method:

Survey grade GPS \_\_\_\_\_: Post Processed Differential \_\_\_\_\_

Real-Time Differential \_\_\_\_\_

Mapping Grade GPS /: Post Processed Differential \_\_\_\_\_

Real-Time Differential \_\_\_\_\_

4. Letter size copy of the topography map showing the well location.

I the undersigned, hereby certify this data is correct to the best of my knowledge and belief and shows all the information required by law and the regulations issued and prescribed by the Office of Oil and Gas.


[Signature]  
Signature

CEO  
Title

3-3-22  
Date

RECEIVED  
Office of Oil and Gas  
MAR 21 2022  
WV Department of  
Environmental Protection

47-039-01935P

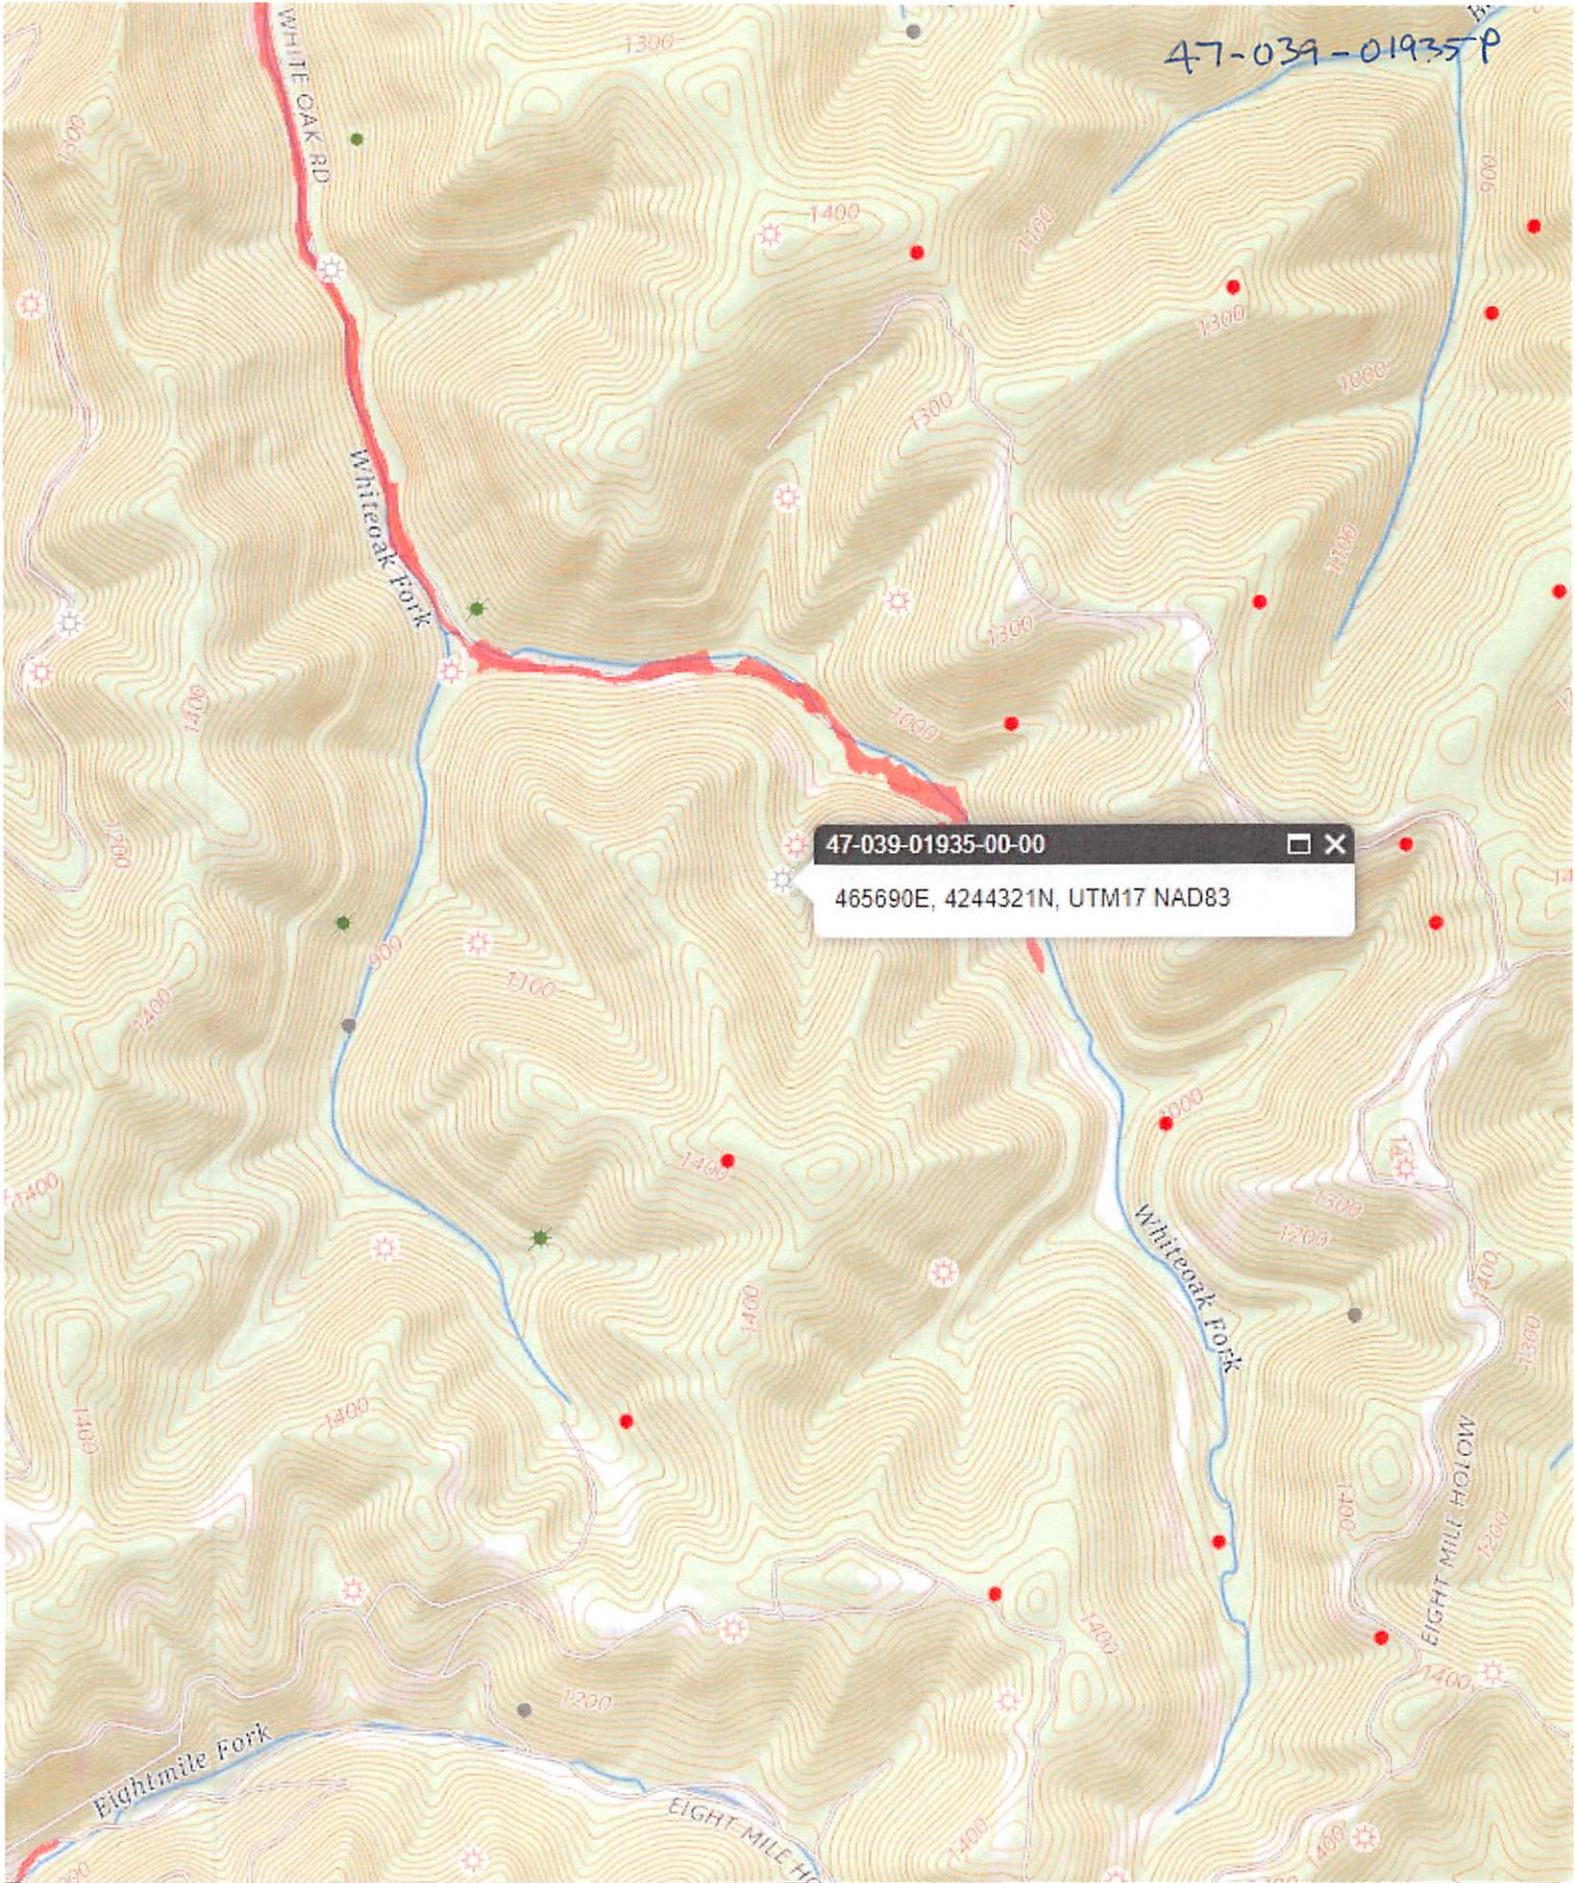

47-039-01935-00-00  
465690E, 4244321N, UTM17 NAD83

05/20/2022