

WW-7
8-30-06



West Virginia Department of Environmental Protection
Office of Oil and Gas
WELL LOCATION FORM: GPS

API: 4703902018 WELL NO.: 1

FARM NAME: C.C. Dickinson Trust

RESPONSIBLE PARTY NAME: Diversified Production LLC

COUNTY: Kanawha DISTRICT: Malden

QUADRANGLE: Charleston East

SURFACE OWNER: Amherst Industries Inc

ROYALTY OWNER: Black Band LLC

UTM GPS NORTHING: 4239721.06

UTM GPS EASTING: 452236.38 GPS ELEVATION: 875.86

The Responsible Party named above has chosen to submit GPS coordinates in lieu of preparing a new well location plat for a plugging permit or assigned API number on the above well. The Office of Oil and Gas will not accept GPS coordinates that do not meet the following requirements:

1. Datum: NAD 1983, Zone: 17 North, Coordinate Units: meters, Altitude: height above mean sea level (MSL) – meters.
2. Accuracy to Datum – 3.05 meters
3. Data Collection Method:

Survey grade GPS : Post Processed Differential

Real-Time Differential

Mapping Grade GPS : Post Processed Differential

Real-Time Differential

4. Letter size copy of the topography map showing the well location.

I the undersigned, hereby certify this data is correct to the best of my knowledge and belief and shows all the information required by law and the regulations issued and prescribed by the Office of Oil and Gas.

Digitally signed by Austin Stutler
Date: 2022.01.17 09:26:45 -05'00'

Sr. Proj. Manager

1/17/2022

Signature


Title

Date

RECEIVED
Office of Oil and Gas

FEB 01 2022

WV Department of
Environmental Protection

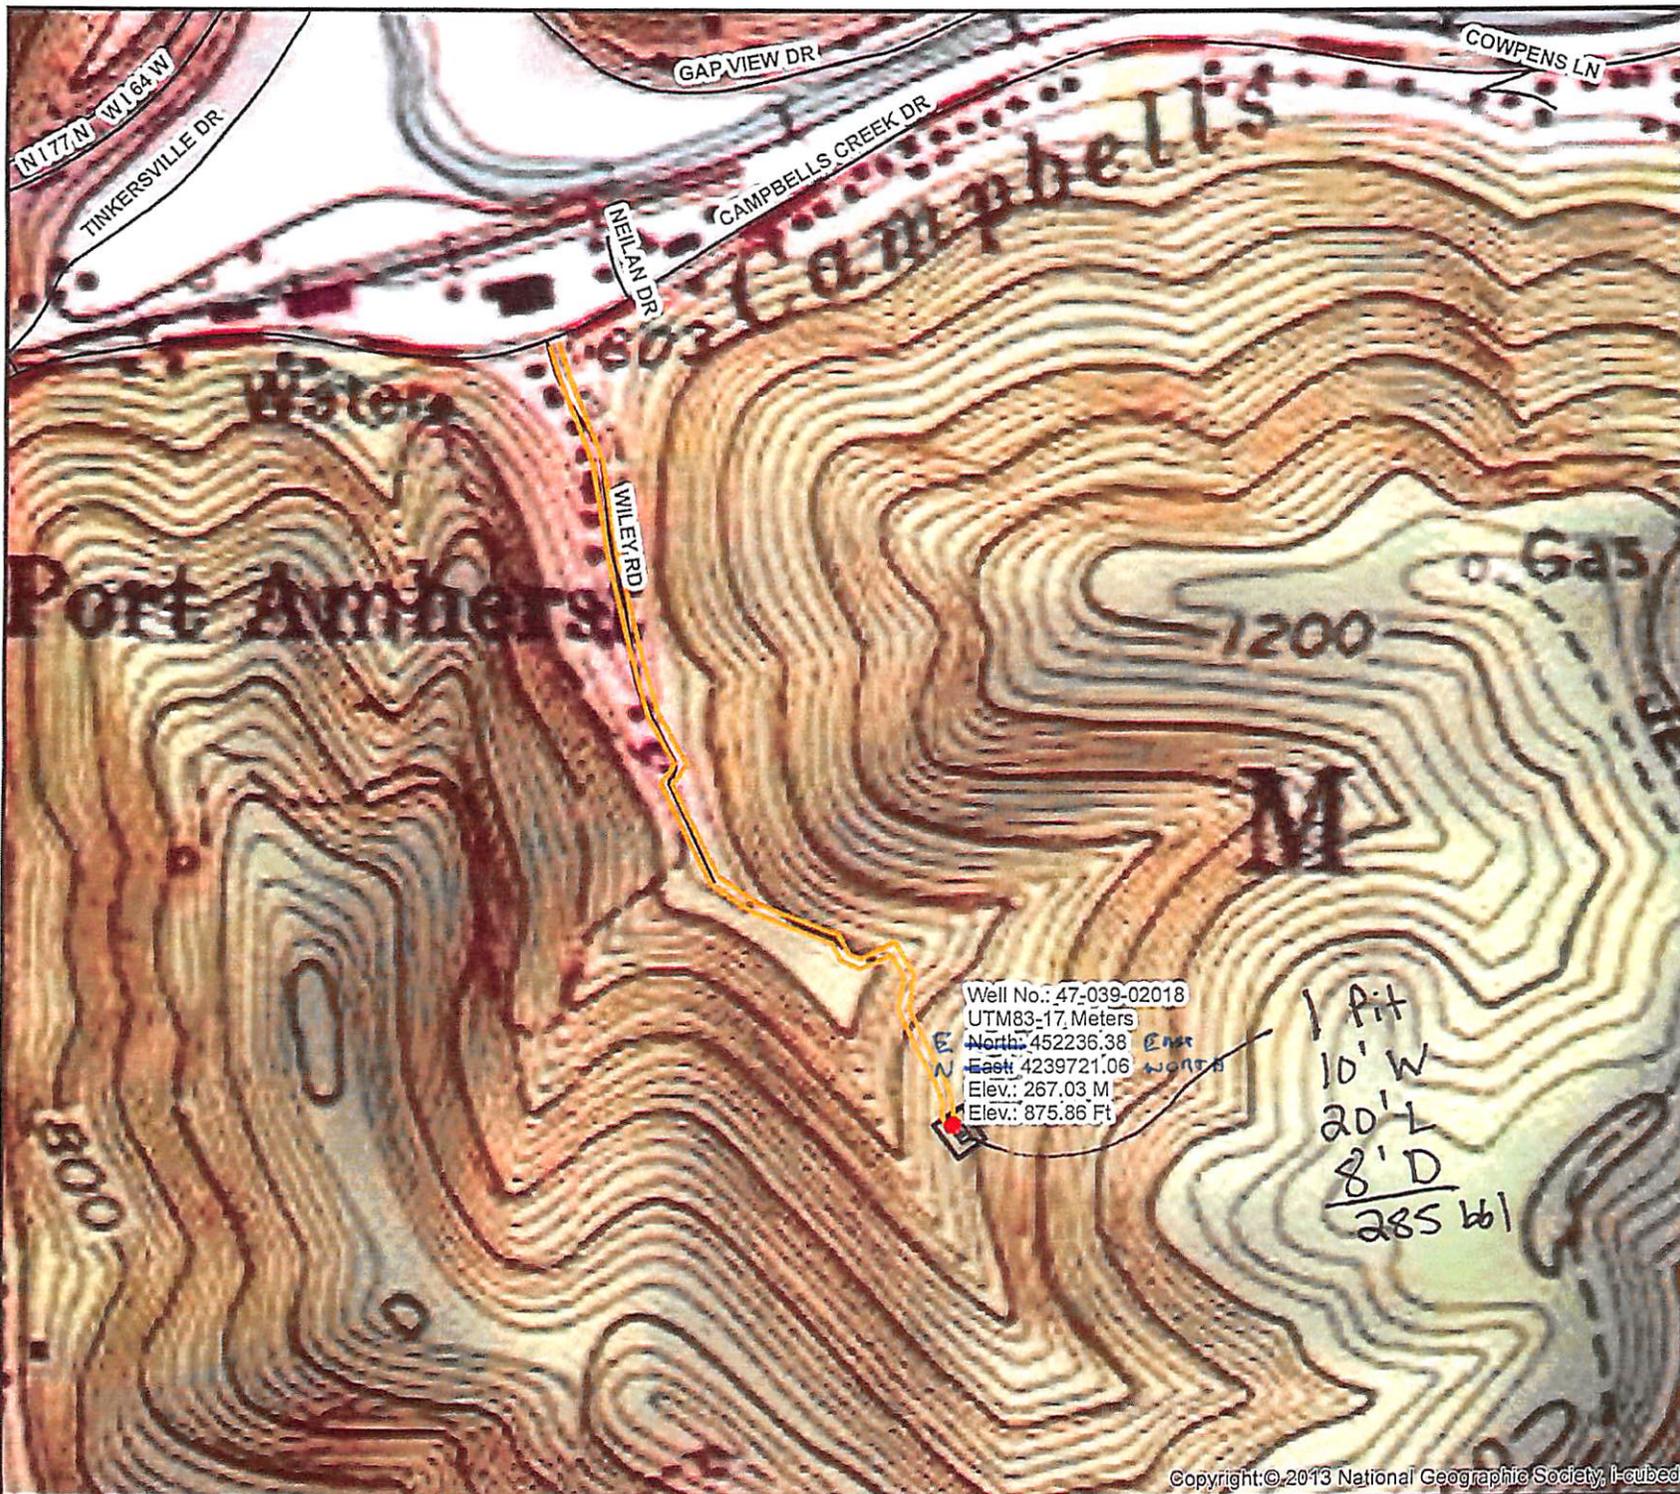

Diversified Gas & Oil Corporation
 100 Diversified Way
 Pikeville KY, 41051

47-039-02018



Plugging Map

Legend

- Well
- Access Road
- Pits
- Pad
- Public Roads

Well No.: 47-039-02018
 UTM83-17, Meters
 North: 452236.38
 East: 4239721.06
 Elev.: 267.03 M
 Elev.: 875.86 Ft

1 Pit
 10' W
 20' L
 8' D
 285 lb

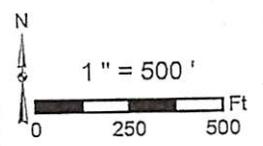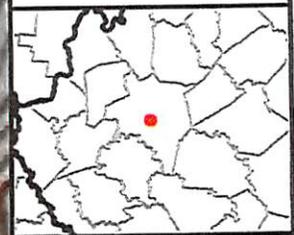

4703902018