

4703902063 P

WW-7
8-30-06

RECEIVED
Office of Oil and Gas

JUN 29 2021

WV Department of
Environmental Protection



West Virginia Department of Environmental Protection
Office of Oil and Gas
WELL LOCATION FORM: GPS

API: 039-02063 WELL NO.: 1- Lemasters (aka Union)

FARM NAME: Saulsbury

RESPONSIBLE PARTY NAME: Brewer Natural Resources, LLC

COUNTY: Kanawha DISTRICT: Malden

QUADRANGLE: Charleston East

SURFACE OWNER: EBX-EM LLC

ROYALTY OWNER: George's Creek Investment Ltd.

UTM GPS NORTHING: 4234903.97

UTM GPS EASTING: 454157.58 GPS ELEVATION: 800'

The Responsible Party named above has chosen to submit GPS coordinates in lieu of preparing a new well location plat for a plugging permit or assigned API number on the above well. The Office of Oil and Gas will not accept GPS coordinates that do not meet the following requirements:

1. Datum: NAD 1983, Zone: 17 North, Coordinate Units: meters, Altitude: height above mean sea level (MSL) – meters.
2. Accuracy to Datum – 3.05 meters
3. Data Collection Method:

Survey grade GPS ; Post Processed Differential

Real-Time Differential

Mapping Grade GPS ; Post Processed Differential

Real-Time Differential

4. **Letter size copy of the topography map showing the well location.**


I the undersigned, hereby certify this data is correct to the best of my knowledge and belief and shows all the information required by law and the regulations issued and prescribed by the Office of Oil and Gas.

Signature

MENDEYR
Title

6-22-21
Date

07/09/2021

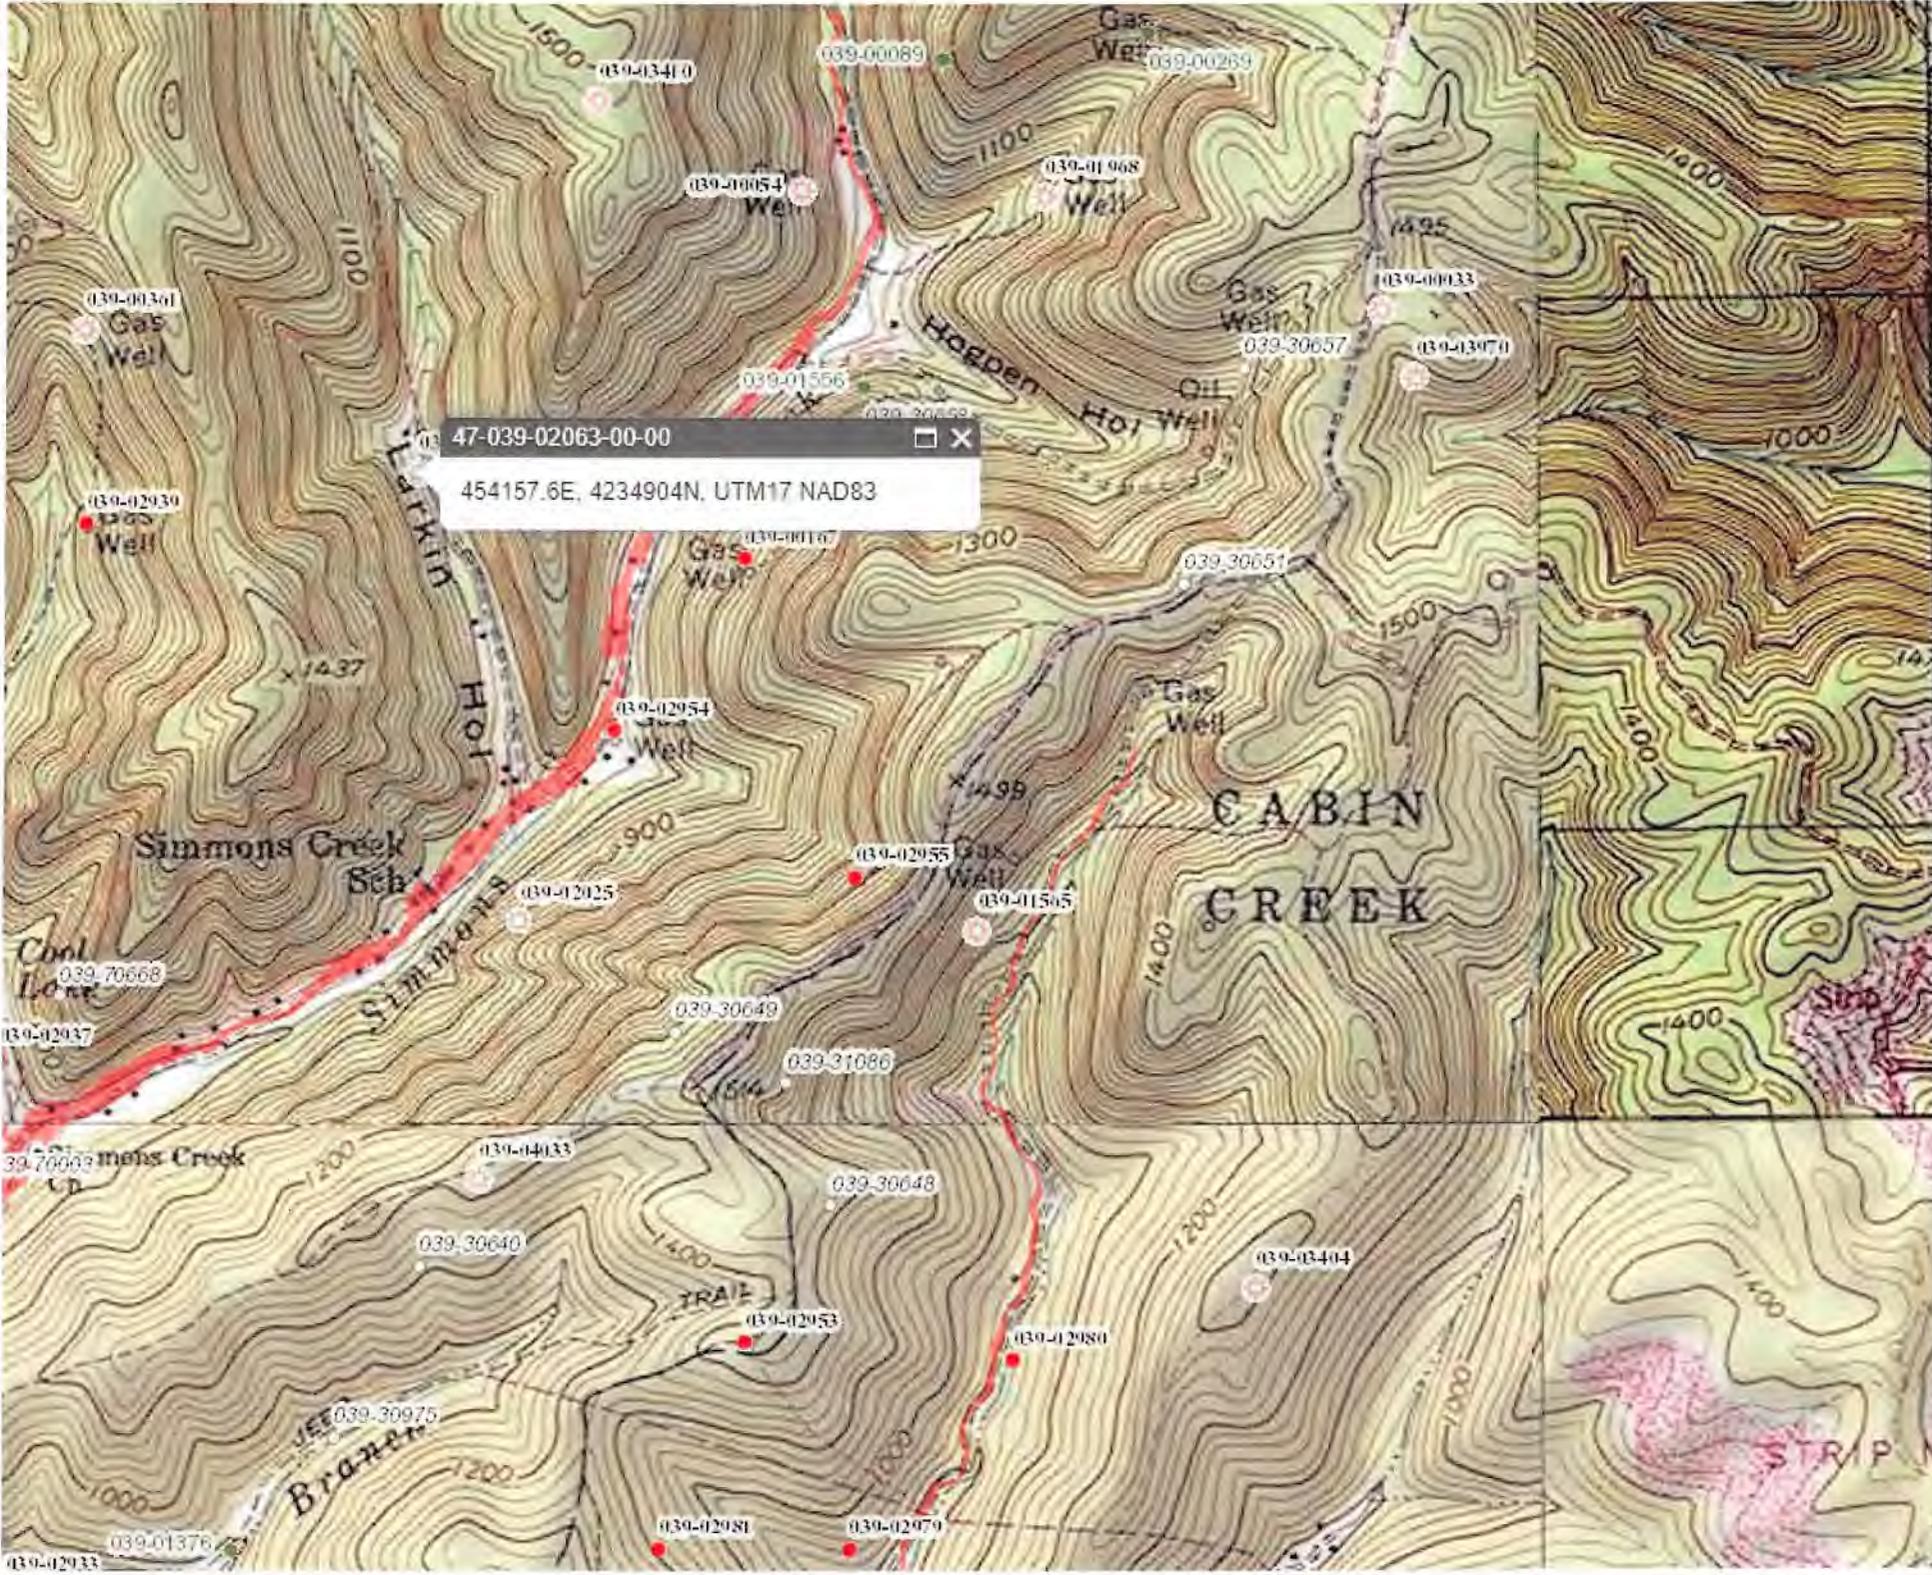

4703902063P