

WW-7
8-30-06

MAY 1



West Virginia Department of Environmental Protection
Office of Oil and Gas
WELL LOCATION FORM: GPS

API: 47-039-02373 WELL NO.: Holmes Morton

FARM NAME: Holmes Morton

RESPONSIBLE PARTY NAME: Viking Energy Corp.

COUNTY: Kanawha DISTRICT: Poca

QUADRANGLE: Kenna

SURFACE OWNER: Dana & Patricia Page

ROYALTY OWNER: Cabot Oil and Gas

UTM GPS NORTHING: 4264803

UTM GPS EASTING: 438402 GPS ELEVATION: 945'

The Responsible Party named above has chosen to submit GPS coordinates in lieu of preparing a new well location plat for a plugging permit or assigned API number on the above well. The Office of Oil and Gas will not accept GPS coordinates that do not meet the following requirements:

- Datum: NAD 1983, Zone: 17 North, Coordinate Units: meters, Altitude: height above mean sea level (MSL) – meters.
- Accuracy to Datum – 3.05 meters
- Data Collection Method:

Survey grade GPS : Post Processed Differential
Real-Time Differential

Mapping Grade GPS : Post Processed Differential
Real-Time Differential


4. Letter size copy of the topography map showing the well location.

I the undersigned, hereby certify this data is correct to the best of my knowledge and belief and shows all the information required by law and the regulations issued and prescribed by the Office of Oil and Gas.

Eva Pinkerton
Signature

Operations Manager
Title

4/29/13
Date

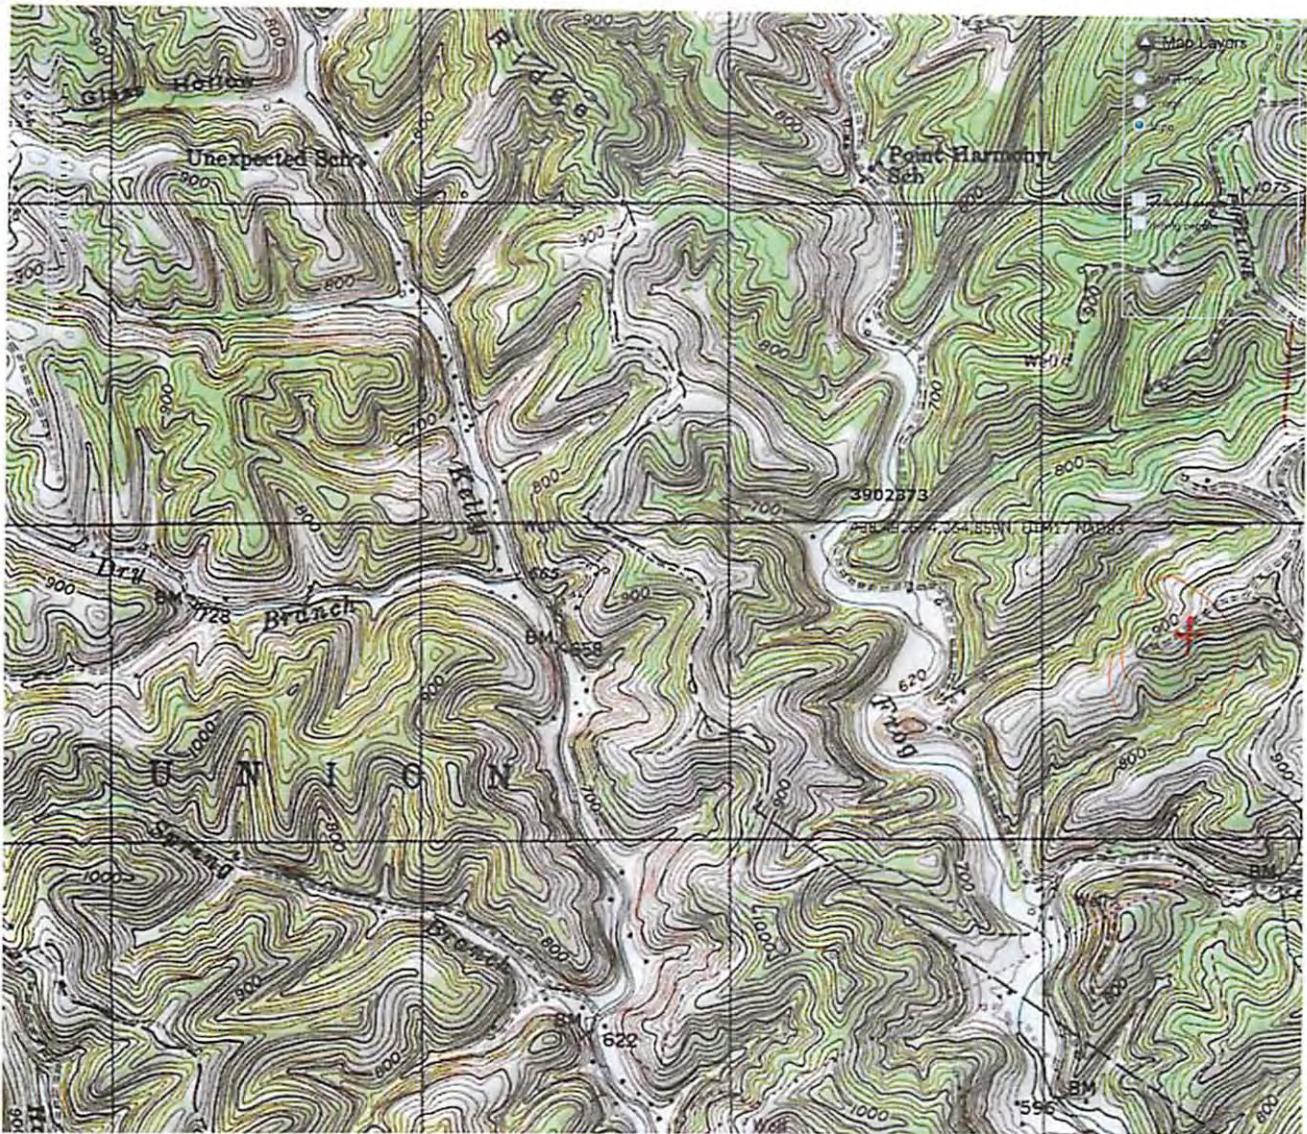

438,492 E
4,264,859 N
UTM 17, NAD 83