
WW-7 8-30-06



West Virginia Department of Environmental Protection Office of Oil and Gas WELL LOCATION FORM: GPS

_{API:} 47-039-02380	WELL NO.: SUTTON 1
FARM NAME: HARRY SUTTON	
RESPONSIBLE PARTY NAME: EXCO	RESOURCES (PA), LLC
COUNTY: KANAWHA	
QUADRANGLE: CLENDENIN	
SURFACE OWNER: JARED A STE	INER
ROYALTY OWNER: Lois W Walker	
UTM GPS NORTHING: 4258053	
	GPS ELEVATION: 825'
The Responsible Party named above has chosen preparing a new well location plat for a plugging above well. The Office of Oil and Gas will not a the following requirements: 1. Datum: NAD 1983, Zone: 17 North, height above mean sea level (MSL) - 2. Accuracy to Datum - 3.05 meters 3. Data Collection Method: Survey grade GPS: Post Processed Diff	ccept GPS coordinates that do not meet Coordinate Units: meters, Altitude: meters. Received
Real-Time Differen	- MOO E ! COM
Mapping Grade GPS X : Post Processed I	MA DEDI OF ENVIOUNCEMENT ASSESSED
4. Letter size copy of the topography 1 the undersigned, hereby certify this data is corr belief and shows all the information required by prescribed by the Office of Oil and Gas.	ect to the best of my knowledge and
Mile Scarbrough Surfa	re Landman 9/24/15 Title Date

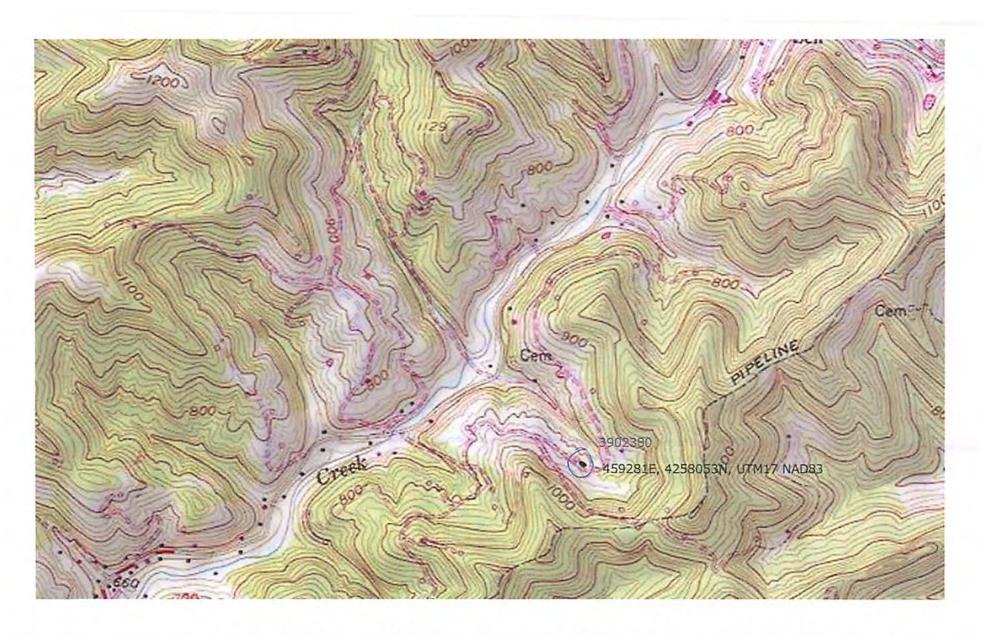

 $http://deparcgis1/ooggis/index.html?x = 459281\&y = 4258053\&datum = NAD83\&ex = 1500\&ey = 1000\&towns = Y\&topo = Y\&px = 459... \ \ 9/2/2015 = 1000\&towns = Y\&topo = Y\&top$