






Diversified Gas & Oil
Corporation
100 Diversified Way
Pikeville KY, 41051

47-039-02482

Plugging Map

Legend

- Well
- Access Road
- ▨ Pits
- Pad
- Public Roads

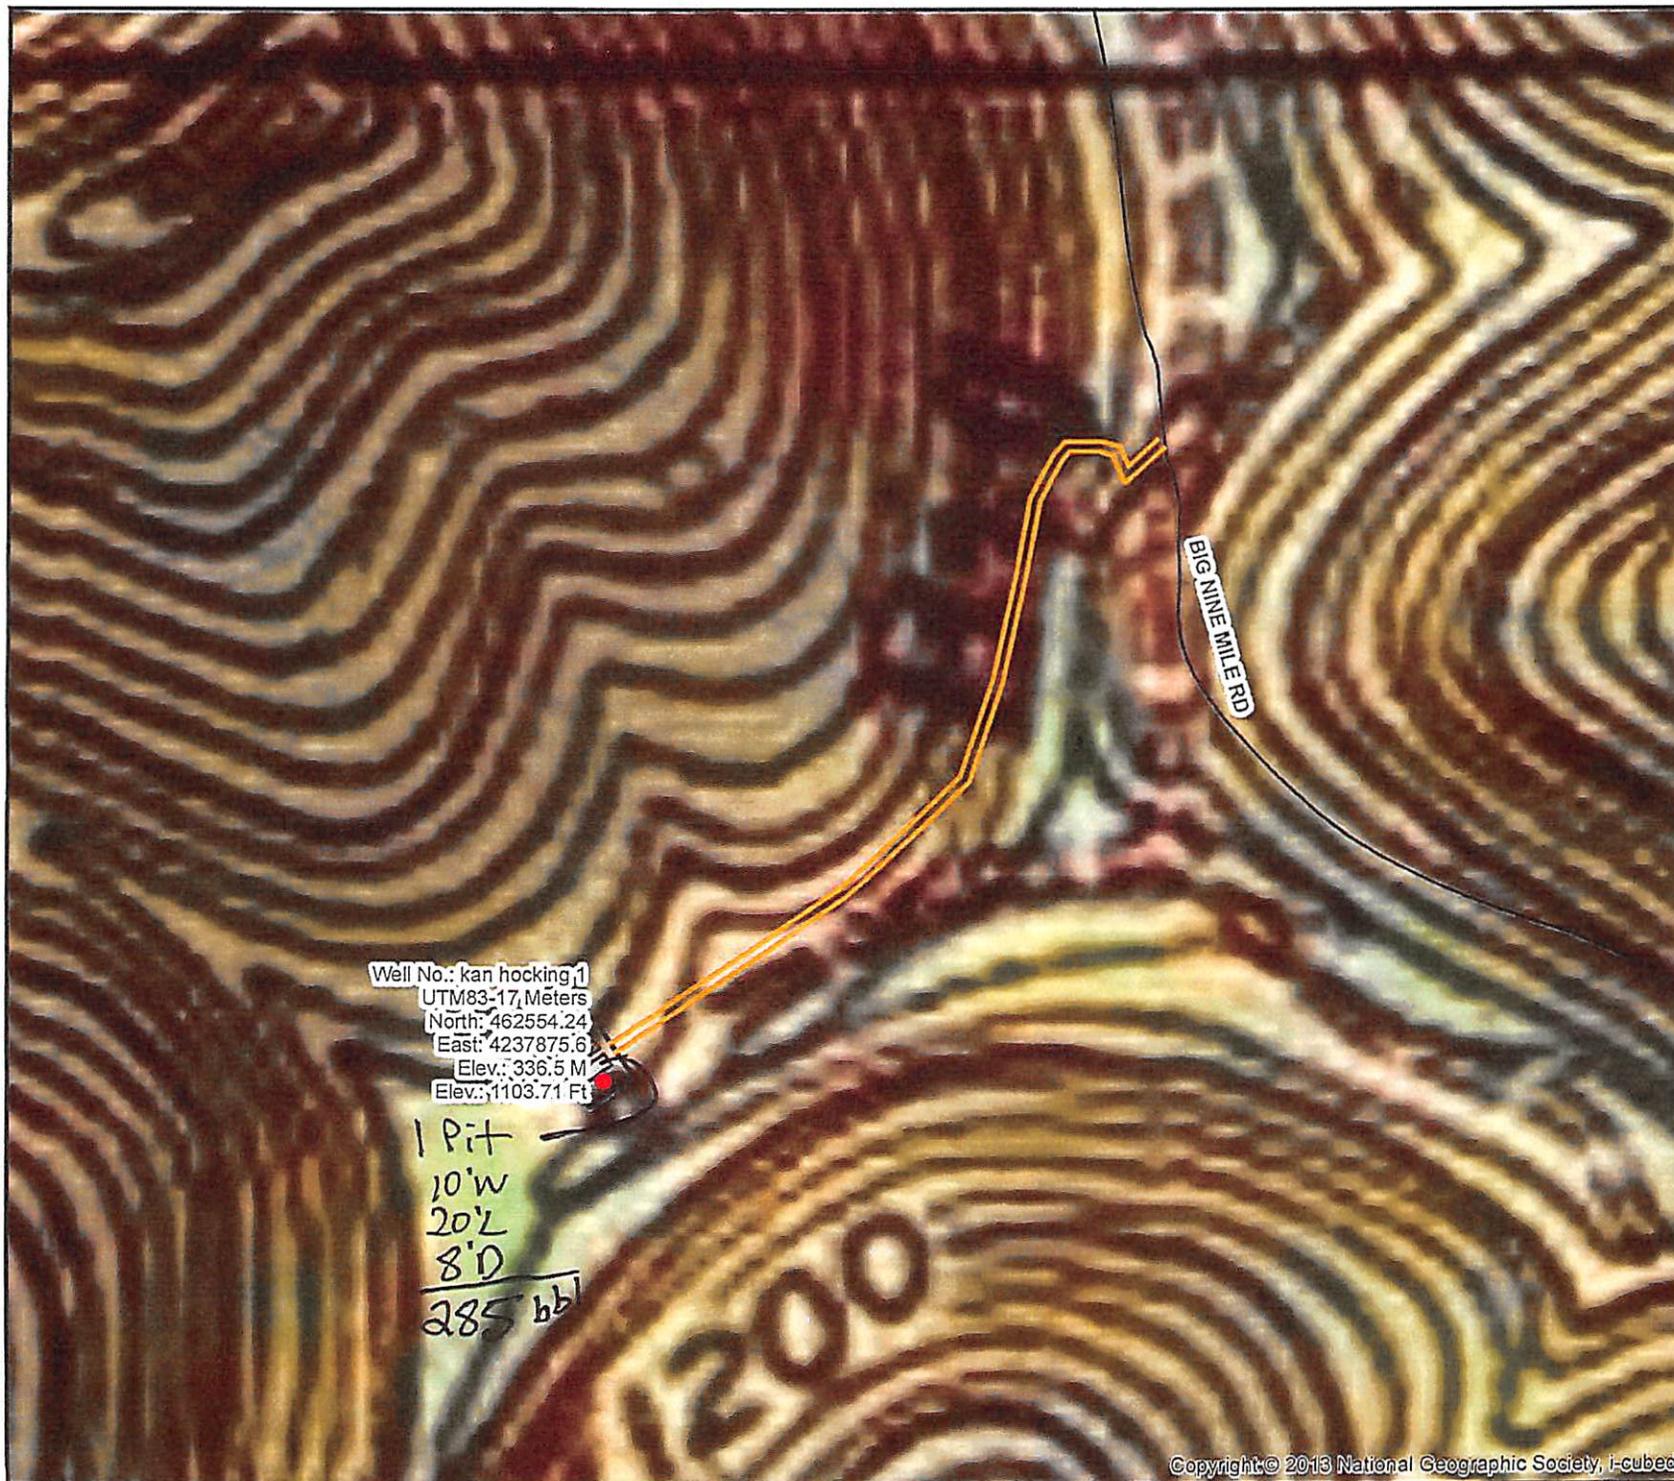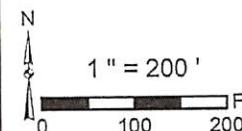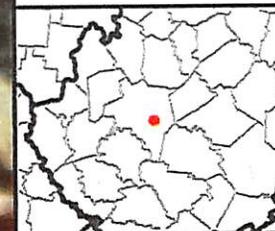

Copyright © 2013 National Geographic Society, i-cubed

4703902482P