

West Virginia Department of Environmental Protection
Office of Oil & Gas
WELL LOCATION FORM: GPS

API: 47-039-2486 P WELL NO: 29

FARM NAME: BLACK BAND FUEL

RESPONSIBLE PARTY NAME: East Resources, Inc.

COUNTY: Kanawha DISTRICT: Washington

QUADRANGLE: Racine 7.5'

SURFACE OWNER: Dickinson Fuel Co.

ROYALTY OWNER: East Resources, Inc. et al.

UTM GPS NORTHING: 4,231,193 (NAD 27)

UTM GPS EASTING: 438,438 (NAD 27) GPS ELEVATION: 291 m.

The Responsible Party named above has chosen to submit GPS coordinates in lieu of preparing a new well location plat for a plugging permit on the above well. The Office of Oil & Gas will not accept GPS coordinates that do not meet the following requirements:


1. Datum: NAD 1983, Zone: 17 North, Coordinate Units: meters, Altitude: height above mean sea level (MSL) - meters.
2. Accuracy to Datum - 3.05 meters
3. Data Collection Method:

Survey Grade GPS	<input type="checkbox"/>	Post Processed Differential	<input type="checkbox"/>
		Real-Time Differential	<input type="checkbox"/>
Mapping Grade GPS	<input checked="" type="checkbox"/>	Post Processed Differential	<input checked="" type="checkbox"/>
		Real-Time Differential	<input type="checkbox"/>

RECEIVED
Office of Oil & Gas

JAN 19 2012


I the undersigned, hereby certify this data is correct to the best of my knowledge and belief and shows all the information required by law and the regulations issued and prescribed by the Office of Oil and Gas.


Signature Timothy P. Roush

Professional Surveyor
Title

December 8, 2011
Date

SUBJECT WELL
Black Band Fuel No.29
47-039-2486

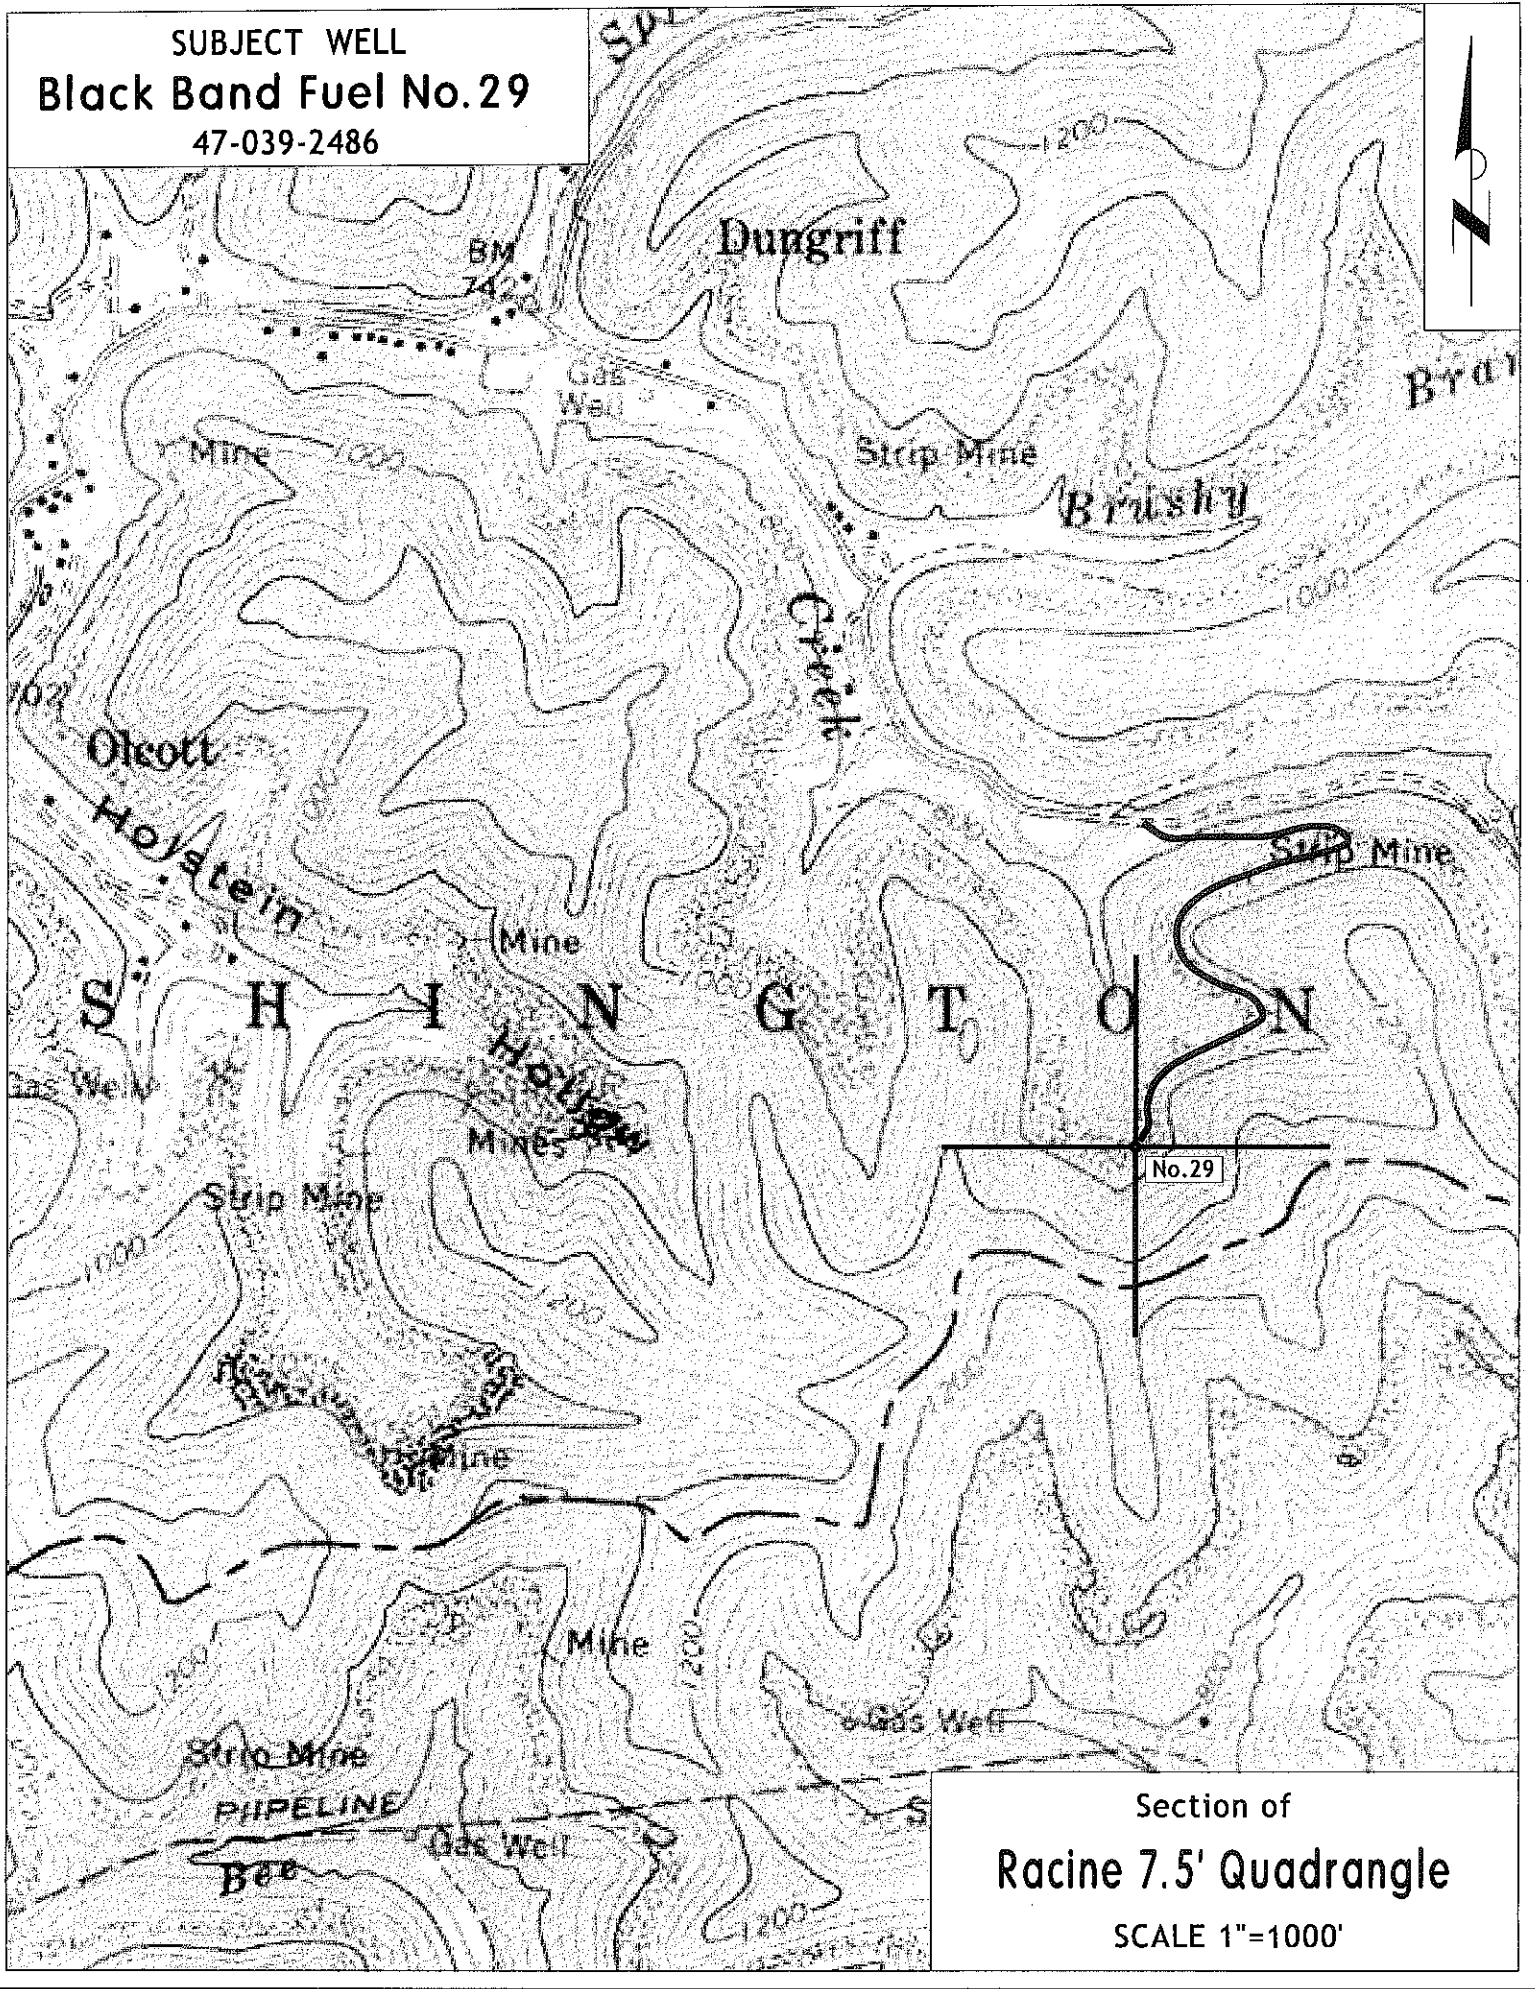

Section of
Racine 7.5' Quadrangle
SCALE 1"=1000'