



West Virginia Department of Environmental Protection  
Office of Oil and Gas  
**WELL LOCATION FORM: GPS**

API: 4703902507 WELL NO.: 4

FARM NAME: Kan & Hocking Coal and Coke Co

RESPONSIBLE PARTY NAME: Diversified Production LLC

COUNTY: Kanawha DISTRICT: Cabin Creek

QUADRANGLE: Quick

SURFACE OWNER: ACIN LLC

ROYALTY OWNER: William A McMillan Etal

UTM GPS NORTHING: 4237715.18

UTM GPS EASTING: 461536.41 GPS ELEVATION: 1223.21

The Responsible Party named above has chosen to submit GPS coordinates in lieu of preparing a new well location plat for a plugging permit or assigned API number on the above well. The Office of Oil and Gas will not accept GPS coordinates that do not meet the following requirements:

- Datum: NAD 1983, Zone: 17 North, Coordinate Units: meters, Altitude: height above mean sea level (MSL) – meters.
- Accuracy to Datum – 3.05 meters
- Data Collection Method:  
Survey grade GPS  : Post Processed Differential   
Real-Time Differential   
Mapping Grade GPS  : Post Processed Differential   
Real-Time Differential

RECEIVED  
Office of Oil and Gas

FEB 01 2022

WV Department of  
Environmental Protection

4. Letter size copy of the topography map showing the well location.


I the undersigned, hereby certify this data is correct to the best of my knowledge and belief and shows all the information required by law and the regulations issued and prescribed by the Office of Oil and Gas.

Signature

Digitally signed by Austin Suttler  
Date: 2022.01.14 16:07:44  
-05'00'

Sr. Proj. Manager  
Title

1/14/2022  
Date

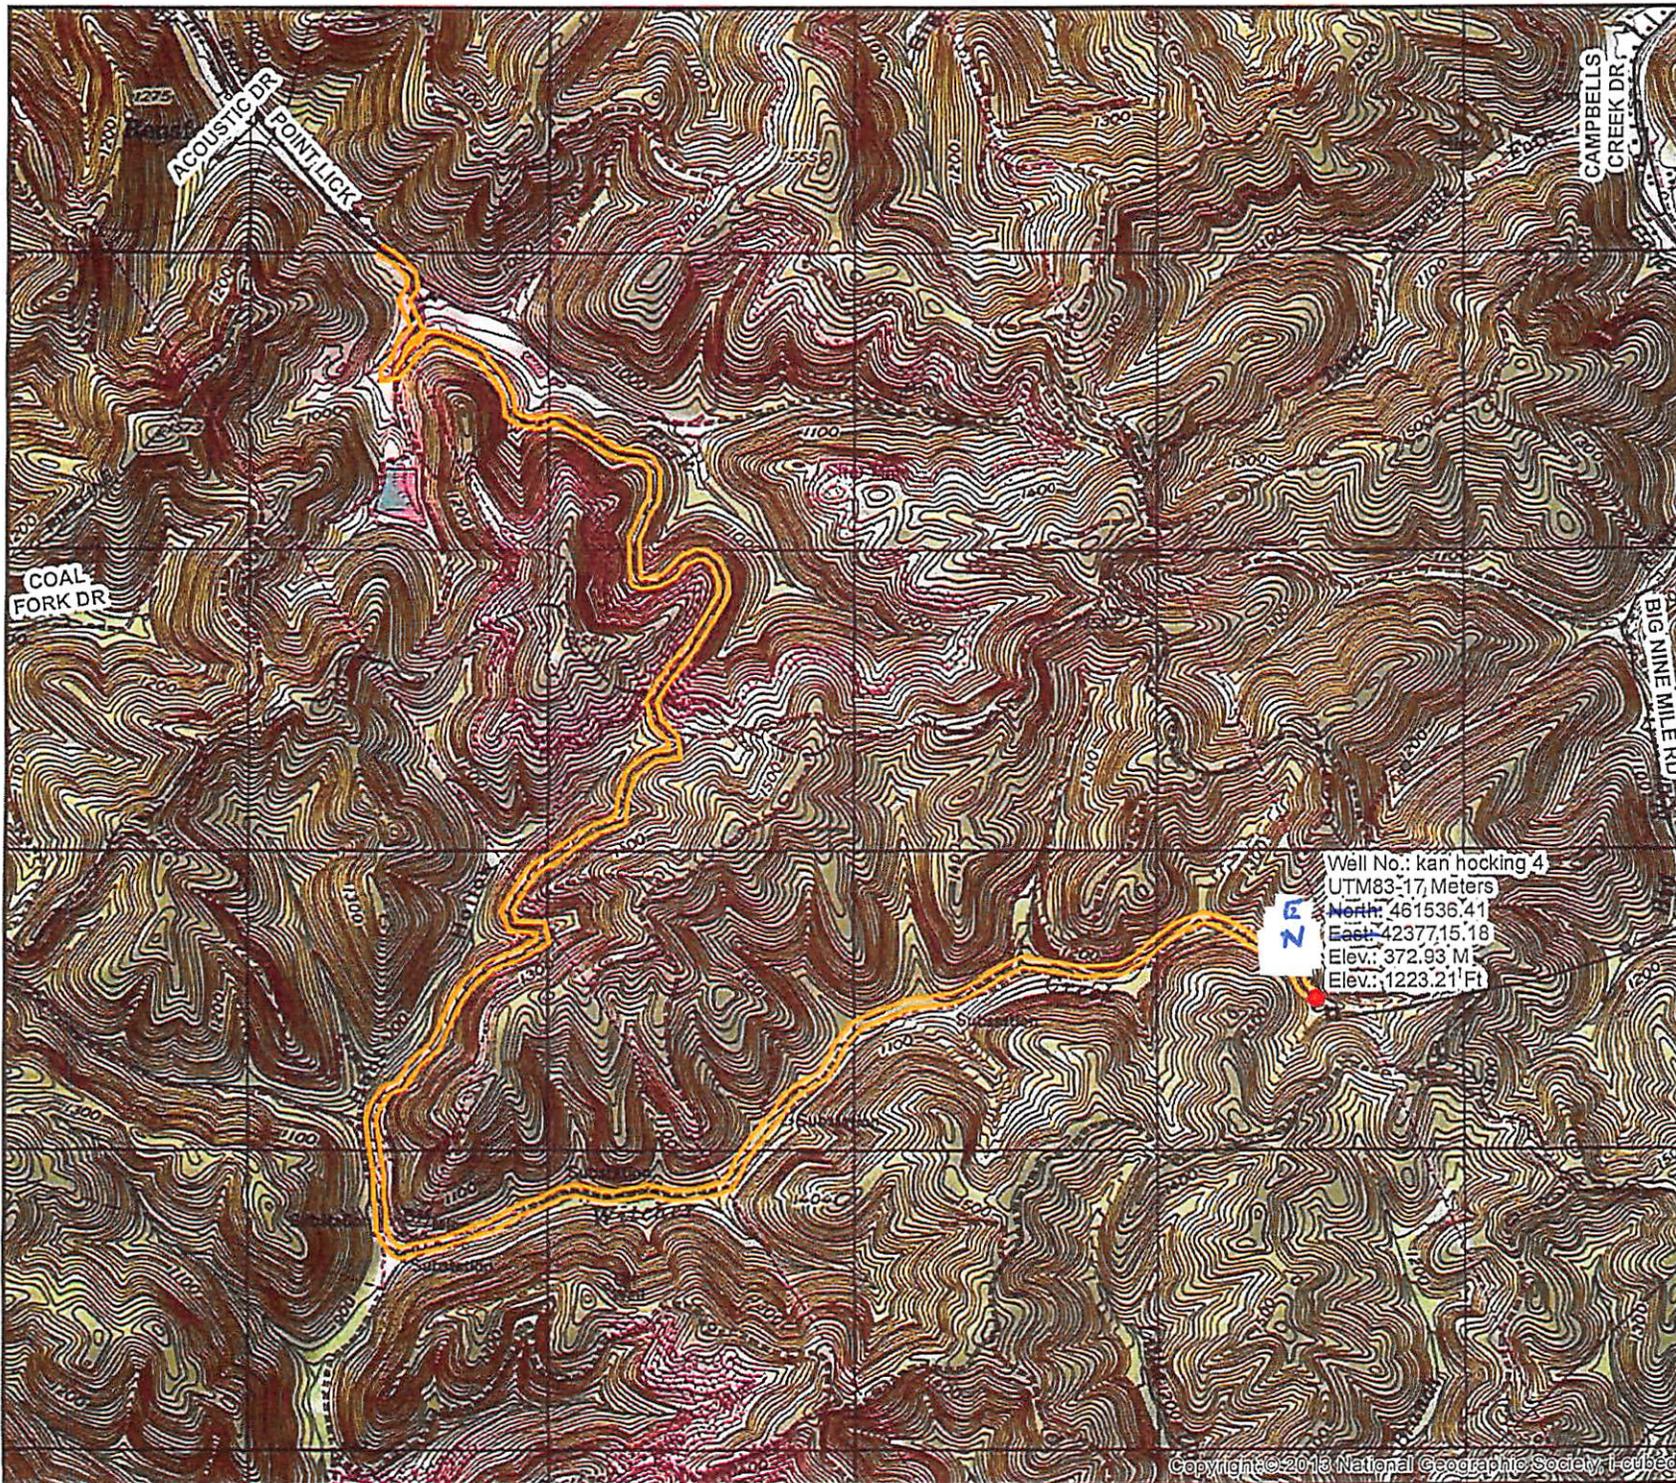

Diversified Gas & Oil Corporation  
 100 Diversified Way  
 Pikeville KY, 41051

47-039-02507



Plugging Map

**Legend**

- Well
- Access Road
- Pits
- Pad
- Public Roads

Well No.: kan hocking 4  
 UTM83-17, Meters  
 North: 461536.41  
 East: 4237715.18  
 Elev.: 372.93 M  
 Elev.: 1223.21 Ft

1 Pit  
 10' W  
 20' L  
 8' D  
 285 bbl

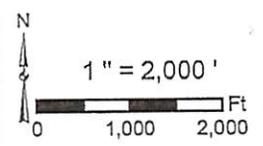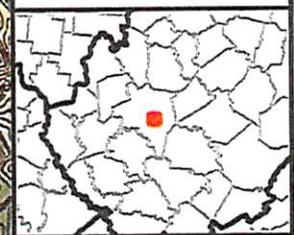

4703902507P