WW-7 8-30-06




West Virginia Department of Environmental Protection Office of Oil and Gas

WELL LOCATION FORM: GPS

_{API}: 47-039-02818 WELL NO.: SUTTON 4 FARM NAME: HARRY SUTTON RESPONSIBLE PARTY NAME: EXCO RESOURCES (PA), LLC COUNTY: KANAWHA DISTRICT: ELK

QUADRANGLE: CLENDENIN SURFACE OWNER: ELKVIEW, LLC ROYALTY OWNER: Lois W Walker et al UTM GPS NORTHING: 4257988 UTM GPS EASTING: 459098 GPS ELEVATION: 1007' The Responsible Party named above has chosen to submit GPS coordinates in lieu of preparing a new well location plat for a plugging permit or assigned API number on the above well. The Office of Oil and Gas will not accept GPS coordinates that do not meet the following requirements: Datum: NAD 1983, Zone: 17 North, Coordinate Units: meters, Altitude: Received height above mean sea level (MSL) – meters. 2. Accuracy to Datum – 3.05 meters Data Collection Method: Survey grade GPS _____: Post Processed Differential _____ Real-Time Differential Mapping Grade GPS X: Post Processed Differential Office of Oil and Gas WV Dept. of Environmental Protection 4. Letter size copy of the topography map showing the well location. I the undersigned, hereby certify this data is correct to the best of my knowledge and belief and shows all the information required by law and the regulations issued and prescribed by the Office of Oil and Gas.

Mike Scarling Sylve Landman 8/24/15
Signature Title Date

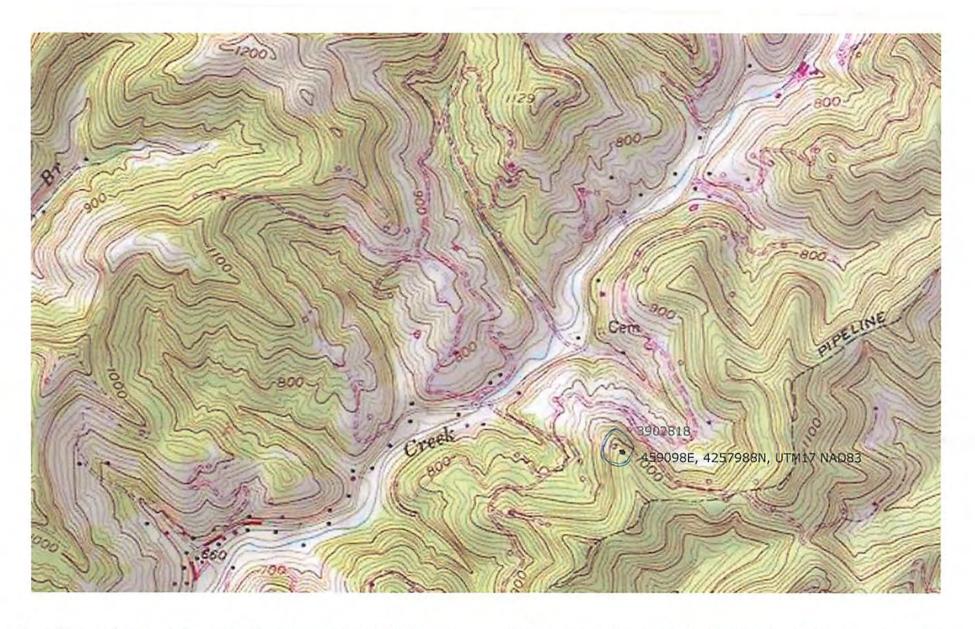

http://deparcgis1/ooggis/index.html?x=459098&y=4257988&datum=NAD83&ex=1500&ey=1000&towns=Y&topo=Y&px=459... 9/2/2015