

WW-7
8-30-06



West Virginia Department of Environmental Protection
Office of Oil and Gas
WELL LOCATION FORM: GPS

API: 47-039-02992 WELL NO.: 801016

FARM NAME: Brown, Goshorn, and Swan

RESPONSIBLE PARTY NAME: Diversified Production LLC

COUNTY: Kanawha DISTRICT: Big Sandy Union

QUADRANGLE: Newton ELKVIEW

SURFACE OWNER: WV Public Land Corps

ROYALTY OWNER: T. William Truesdell Et al.

UTM GPS NORTHING: 4,262,294.06

UTM GPS EASTING: 479,416.6 GPS ELEVATION: 981.8

The Responsible Party named above has chosen to submit GPS coordinates in lieu of preparing a new well location plat for a plugging permit or assigned API number on the above well. The Office of Oil and Gas will not accept GPS coordinates that do not meet the following requirements:

1. Datum: NAD 1983, Zone: 17 North, Coordinate Units: meters, Altitude: height above mean sea level (MSL) – meters.
2. Accuracy to Datum – 3.05 meters
3. Data Collection Method:

Survey grade GPS : Post Processed Differential

Real-Time Differential

Mapping Grade GPS : Post Processed Differential

Real-Time Differential

4. Letter size copy of the topography map showing the well location.

I the undersigned, hereby certify this data is correct to the best of my knowledge and belief and shows all the information required by law and the regulations issued and prescribed by the Office of Oil and Gas.

AA
Signature


Director Production
Title

03/19/2021
Date

RECEIVED
Office of Oil and Gas

MAY 12 2021

WV Department of
Environmental Protection

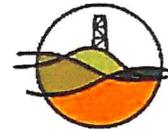

Diversified Gas & Oil Corporation
100 Diversified Way
Pikeville KY, 41051



801016

Plugging Map

47-039-02992

Legend

- Well
- Access Road
- ▨ Pits
- Pad
- Public Roads

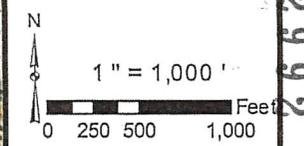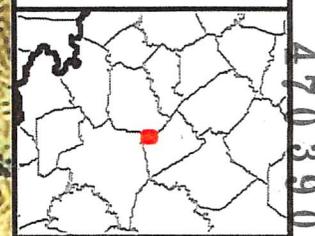

Well No.: 801016
UTM83-17 Meters
North: 4794 16.6
East: 4262294.06
Elev.: 299.34 M
Elev.: 981.85 Ft

4703902992