

WW-7  
8-30-06



West Virginia Department of Environmental Protection  
Office of Oil and Gas

**WELL LOCATION FORM: GPS**

API: 4703903430 WELL NO.: 3

FARM NAME: Quincy Coal Co.

RESPONSIBLE PARTY NAME: Diversified Production LLC

COUNTY: Kanawha DISTRICT: Cabin Creek

QUADRANGLE: Cedar Grove

SURFACE OWNER: Ranger Scientific LLC

ROYALTY OWNER: DP Bluegrass LLC

UTM GPS NORTHING: 4229843.49

UTM GPS EASTING: 456711.04 GPS ELEVATION: 1298.73

The Responsible Party named above has chosen to submit GPS coordinates in lieu of preparing a new well location plat for a plugging permit or assigned API number on the above well. The Office of Oil and Gas will not accept GPS coordinates that do not meet the following requirements:

1. Datum: NAD 1983, Zone: 17 North, Coordinate Units: meters, Altitude: height above mean sea level (MSL) – meters.
2. Accuracy to Datum – 3.05 meters
3. Data Collection Method:

Survey grade GPS  : Post Processed Differential

Real-Time Differential

Mapping Grade GPS  : Post Processed Differential

Real-Time Differential

4. Letter size copy of the topography map showing the well location.

I the undersigned, hereby certify this data is correct to the best of my knowledge and belief and shows all the information required by law and the regulations issued and prescribed by the Office of Oil and Gas.

RECEIVED  
Office of Oil and Gas

JAN 21 2021

WV Department of  
Environmental Protection

  
Signature

Digitally signed by Austin Suttler  
Date: 2022.01.14 15:47:56  
-05'00'

Sr. Proj. Engineer  
Title

1/14/2022  
Date

02/11/2022



Diversified Gas & Oil  
Corporation  
100 Diversified Way  
Pikeville KY, 41051



47-039-03430

Plugging Map

### Legend

- Well
- Access Road
- Pits
- Pad
- Public Roads

1 Pit  
10' W  
20' L  
8' D  
285 bbl

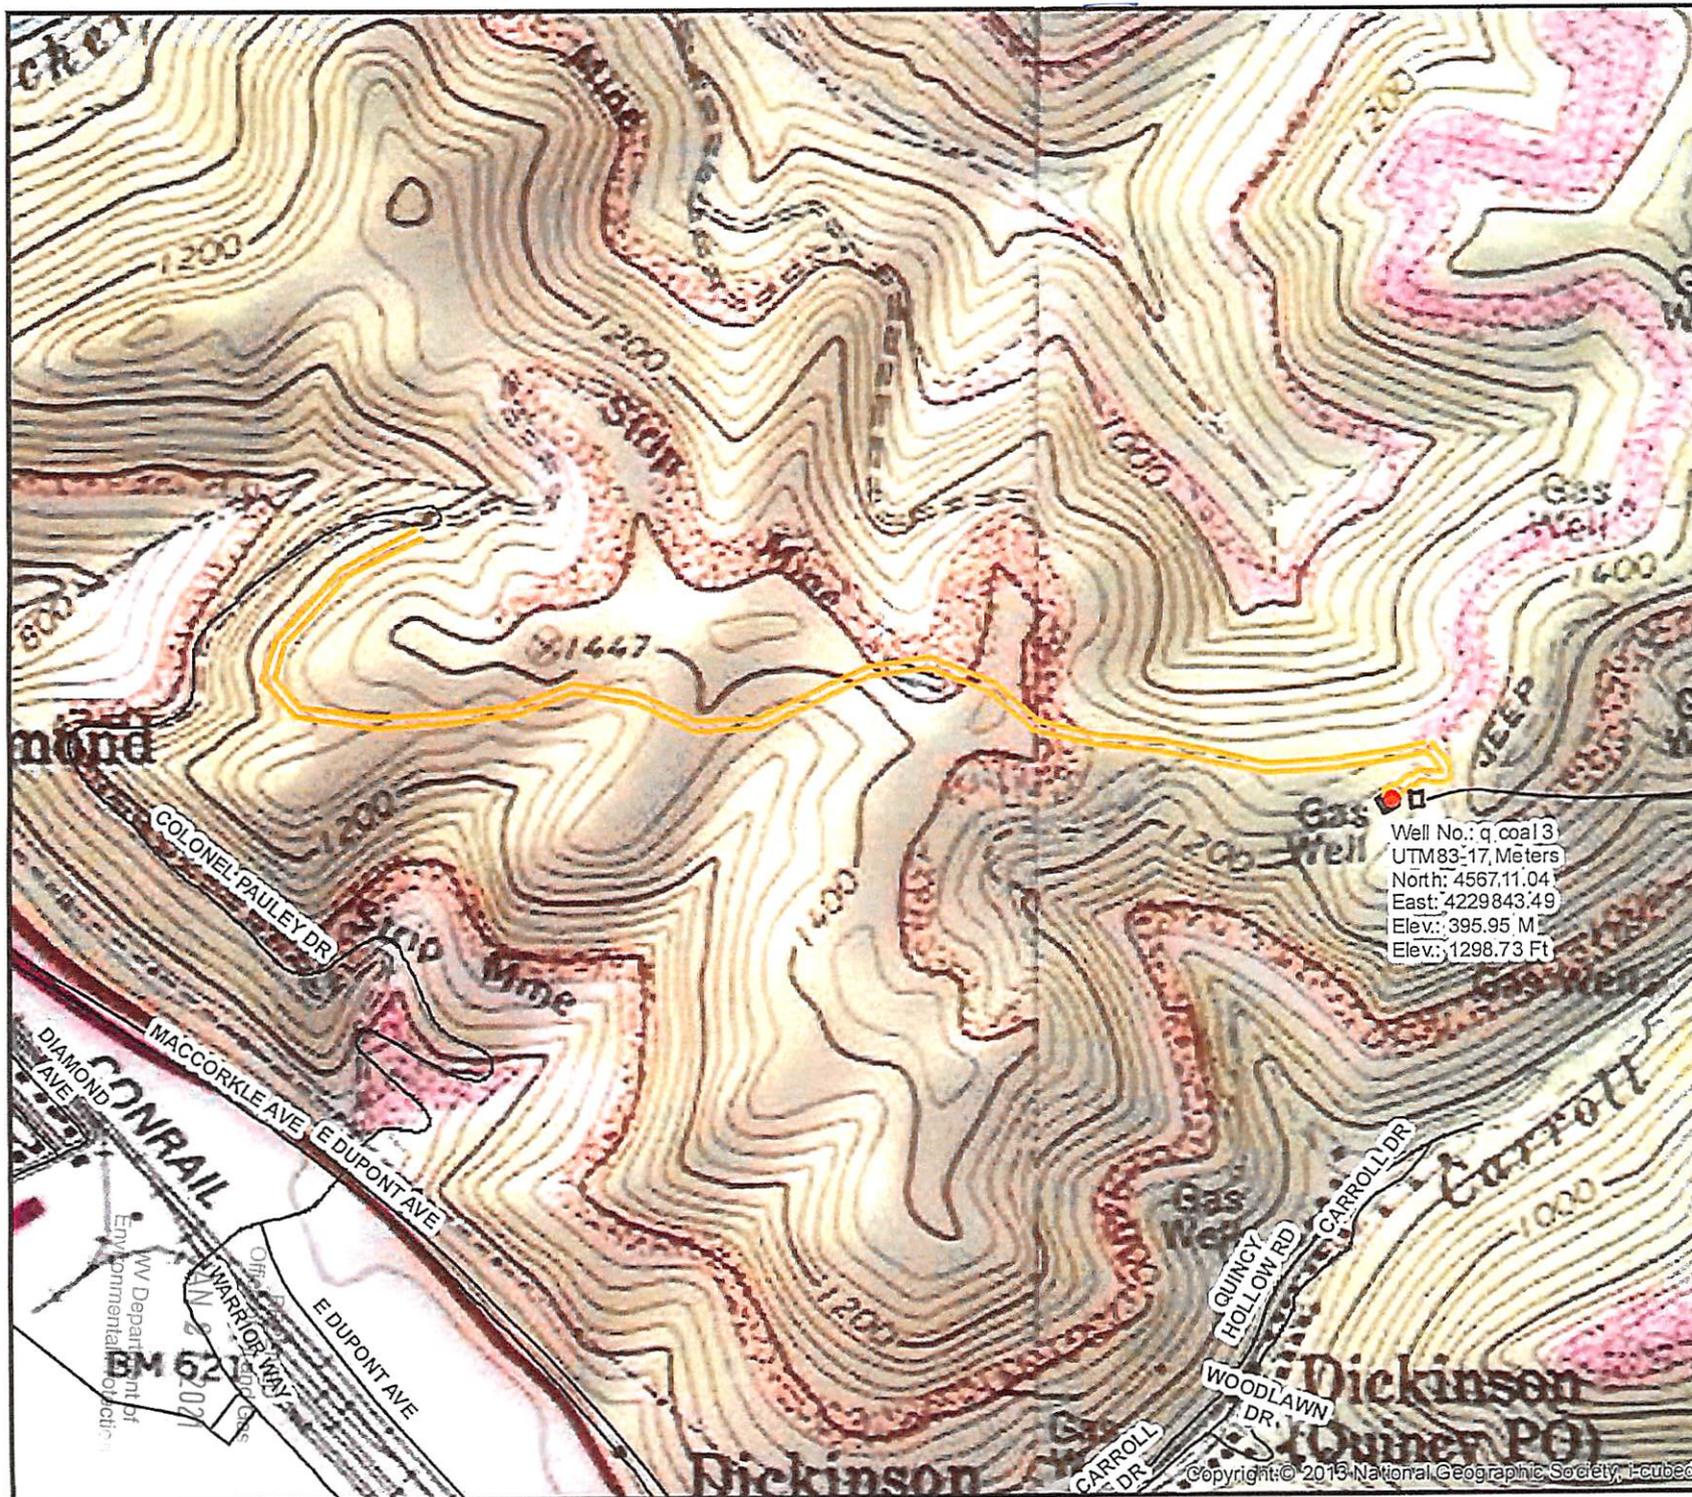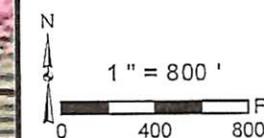

Well No.: q coal 3  
UTM83: 17, Meters  
North: 4567,11,04  
East: 4229843,49  
Elev.: 395.95 M  
Elev.: 1298.73 Ft

4703903430P