

3904907 A

WW-7
8-30-06



West Virginia Department of Environmental Protection
Office of Oil and Gas
WELL LOCATION FORM: GPS

API: 47-3904907 WELL NO.: CROMWELL #2

FARM NAME: MIKE ROSS, INC.

RESPONSIBLE PARTY NAME: RAVEN RIDGE ENERGY, LLC/CUNNINGHAM ENERGY, LLC

COUNTY: KANAWHA DISTRICT: BIG SANDY

QUADRANGLE: CLIO 7.5'

SURFACE OWNER: MIKE ROSS, INC. & WACO OIL & GAS CO.

ROYALTY OWNER: MIKE ROSS, INC. & WACO OIL & GAS CO.

UTM GPS NORTHING: 4261527

UTM GPS EASTING: 468456 GPS ELEVATION: 1132'

RECEIVED
Office of Oil and Gas
AUG 3 2017

The Responsible Party named above has chosen to submit GPS coordinates in lieu of preparing a new well location plat for a plugging permit or assigned API number on the above well. The Office of Oil and Gas will not accept GPS coordinates that do not meet the following requirements:

- Datum: NAD 1983, Zone: 17 North, Coordinate Units: meters, Altitude: height above mean sea level (MSL) – meters.
- Accuracy to Datum – 3.05 meters
- Data Collection Method:
Survey grade GPS : Post Processed Differential
Real-Time Differential
Mapping Grade GPS : Post Processed Differential
Real-Time Differential

WV Department of Environmental Protection

RECEIVED
Office of Oil and Gas

SEP 21 2016

WV Department of Environmental Protection


4. Letter size copy of the topography map showing the well location.
I the undersigned, hereby certify this data is correct to the best of my knowledge and belief and shows all the information required by law and the regulations issued and prescribed by the Office of Oil and Gas.

[Signature] MEMBER 9/21/16
Signature Title Date

08/18/2017

Form W-9

RAVEN RIDGE ENERGY, LLC. CROMWELL #2 (47-039-04907)

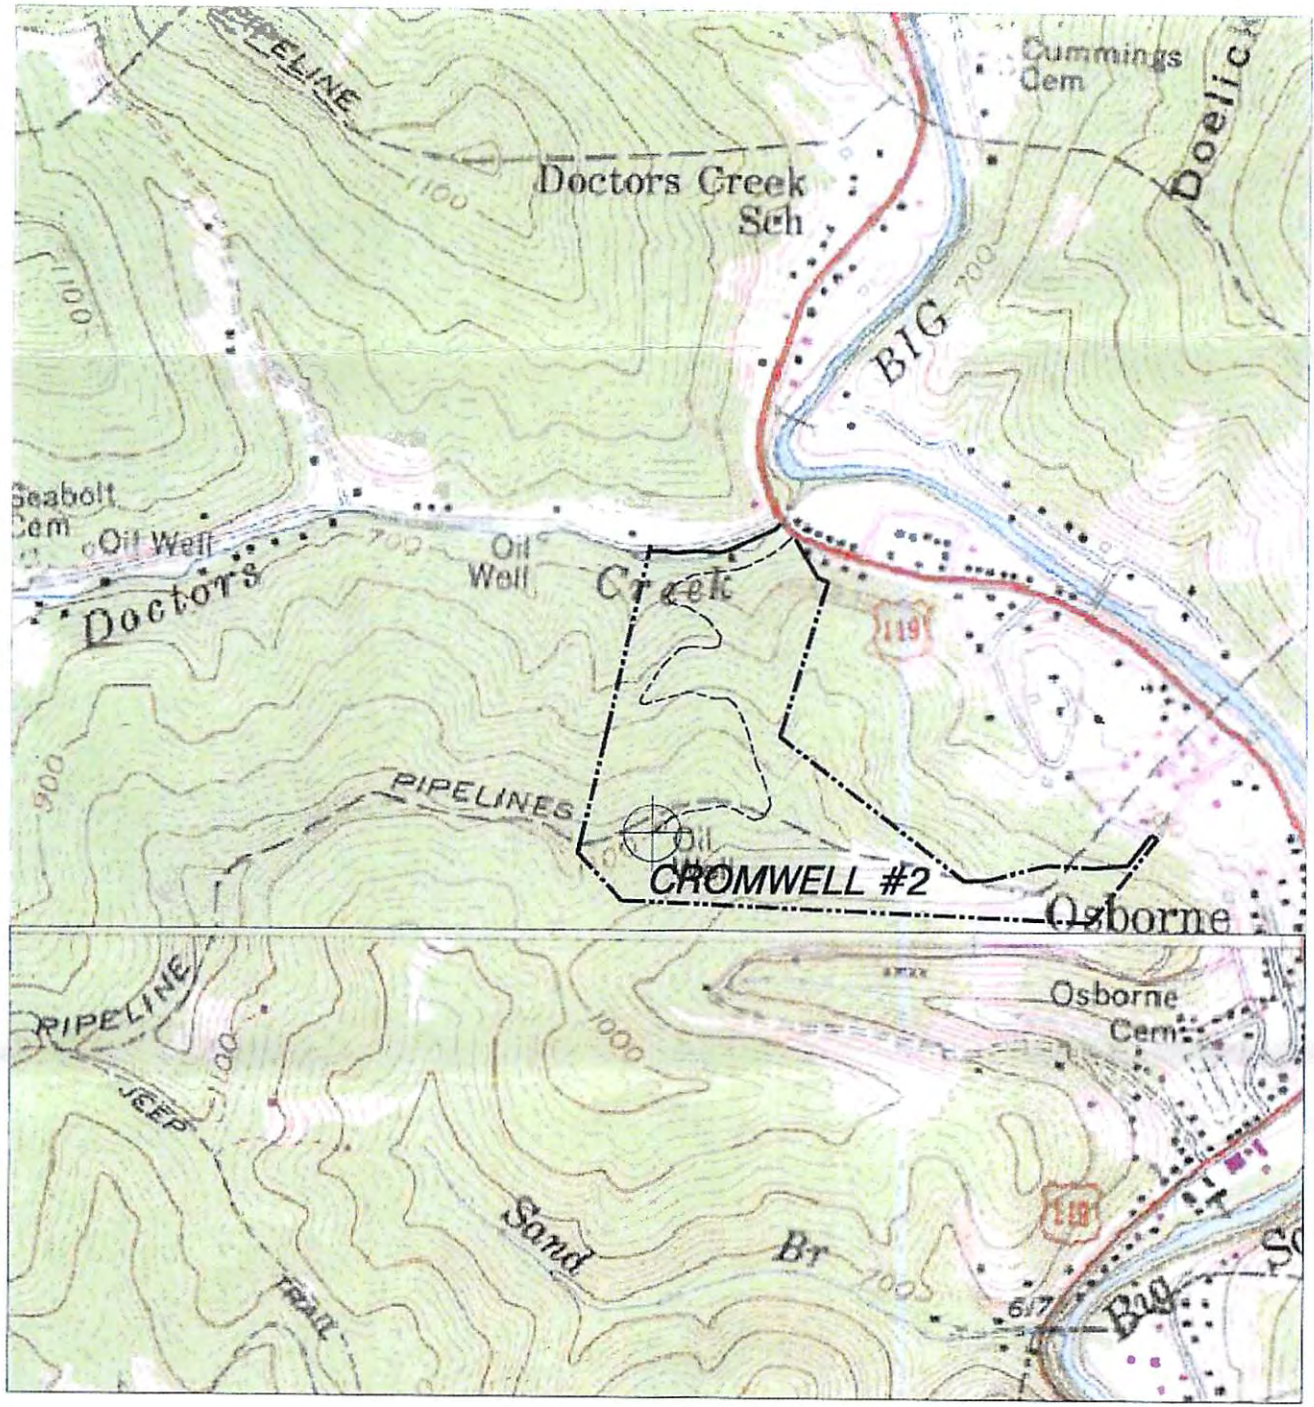

NORTH

<p>HUPP Surveying & Mapping P.O. BOX 647 GRANTSVILLE, WV 26147 PH: (304)354-7035 E-MAIL: hupp@frontiernet.net</p>	<p>1" = 1000' CLIO Quad</p>	<p>RAVEN RIDGE ENERGY, LLC. 3230 PENNSYLVANIA AVE. CHARLESTON, WV 25302</p>
--	--	--