

New Location   
 Drill Deeper   
 Abandonment

AUG 25 1941

Company	VIRGINIAN GASOLINE & OIL CO.
Address	CLENDENIN, W. VA.
Farm	S. YOUNG
Tract	Acres 37
Lease No.	568
Well (Farm) No.	1
Serial No.	3523
Elevation (Spirit Level)	1123.3
Quadrangle	CLENDENIN
County	KANAWHA
District	BIG SANDY
Engineer	G.A. Cunningham
Engineer's Registration No.	659
File No.	74-69
Drawing No.	
Date	AUG. 15, 1941
Scale	1" = 400'

STATE OF WEST VIRGINIA  
 DEPARTMENT OF MINES  
 OIL AND GAS DIVISION  
 CHARLESTON

**WELL LOCATION MAP**  
 FILE NO. KAN-330A

+ Denotes location of well on United States Topographic Maps, scale 1 to 62,500, latitude and longitude lines being represented by border lines as shown.

- Denotes one inch spaces on border line of original tracing.

S. YOUNG No. 1 (3523) - VIRGINIAN GASOLINE & OIL CO. - KAN-330-A

STATE OF WEST VIRGINIA  
DEPARTMENT OF MINES  
OIL AND GAS DIVISION

923

WELL RECORD

Permit No. 33-A


Oil or Gas Well Oil  
(KIND)

Company Virginian Gasoline & Oil Company  
 Address Charleston, West Virginia  
 Farm S. Young Acres 37  
 Location (waters) Jordan Creek  
 Well No. 3523 Elev. 1123.3  
 District Big Sandy County Kanawha  
 The surface of tract is owned in fee by Sophonria Young  
 Address Elkview, W. Va.  
 Mineral rights are owned by Sophonria Young, et al  
 Address Elkview, W. Va.  
 Drilling commenced October 3, 1919  
 Drilling completed November 26, 1919  
 Date shot \_\_\_\_\_ Depth of shot 2282  
 Open Flow /10ths Water in \_\_\_\_\_ Inch  
 /10ths Merc. in \_\_\_\_\_ Inch  
 Volume \_\_\_\_\_ Cu. Ft.  
 Rock Pressure \_\_\_\_\_ lbs \_\_\_\_\_ hrs.  
 Oil 40 \_\_\_\_\_ bbls., 1st 24 hrs.  
 Fresh water \_\_\_\_\_ feet \_\_\_\_\_ feet  
 Salt water \_\_\_\_\_ feet \_\_\_\_\_ feet

Casing and Tubing	Used in Drilling	Left in Well	Packers
Size			
16			Kind of Packer
13			
10	19	19	Size of
8 1/4	395		
6 5/8	1946	1946	Depth set
5 3/16	2123	2123	
3			Perf. top
2			Perf. bottom
Liners Used			Perf. top
			Perf. bottom

CASING CEMENTED \_\_\_\_\_ SIZE \_\_\_\_\_ No. Ft. \_\_\_\_\_ Date \_\_\_\_\_  
 COAL WAS ENCOUNTERED AT \_\_\_\_\_ FEET \_\_\_\_\_ INCHES  
 \_\_\_\_\_ FEET \_\_\_\_\_ INCHES \_\_\_\_\_ FEET \_\_\_\_\_ INCHES  
 \_\_\_\_\_ FEET \_\_\_\_\_ INCHES \_\_\_\_\_ FEET \_\_\_\_\_ INCHES

Formation	Color	Hard or Soft	Top	Bottom	Oil, Gas or Water	Depth Found	Remarks
Sand				35			
Red Rock			35	375			
Slate			375	385			
Sand			385	390			
Red Rock			390	420			
Sand			420	435			
Red Rock			435	450			
Slate			450	465			
Sand			465	485			
Red Rock			485	495			
Slate			495	510			
Sand			510	750			
Slate			750	785			
Sand			785	900			
Slate			900	915			
Sand			915	1050			
Slate			1050	1100			
Sand			1100	1125			
Slate & Shells			1125	1200			
Sand			1200	1220			
Slate & Shells			1220	1365			
Salt Sand			1365	1735			
Black Lime			1735	1760			
Slate			1760	1770			
Lime			1770	1795			
Maxon Sand			1795	1883			
Little Lime			1883	1911			
Slate			1911	1923			
Lime			1923	1936			
Pencil Cave			1936	1941			
Big Lime			1941	2056			
Injun Sand			2056	2104			
Slate & Shells			2104	2277			
Weir Sand			2277	2292			
Total Depth				2292			

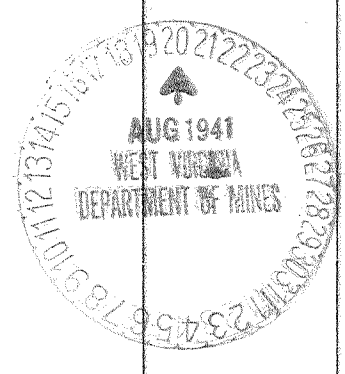

(Over)

OCT - 8 1941

