


Latitude 39 30

Longitude 81 20

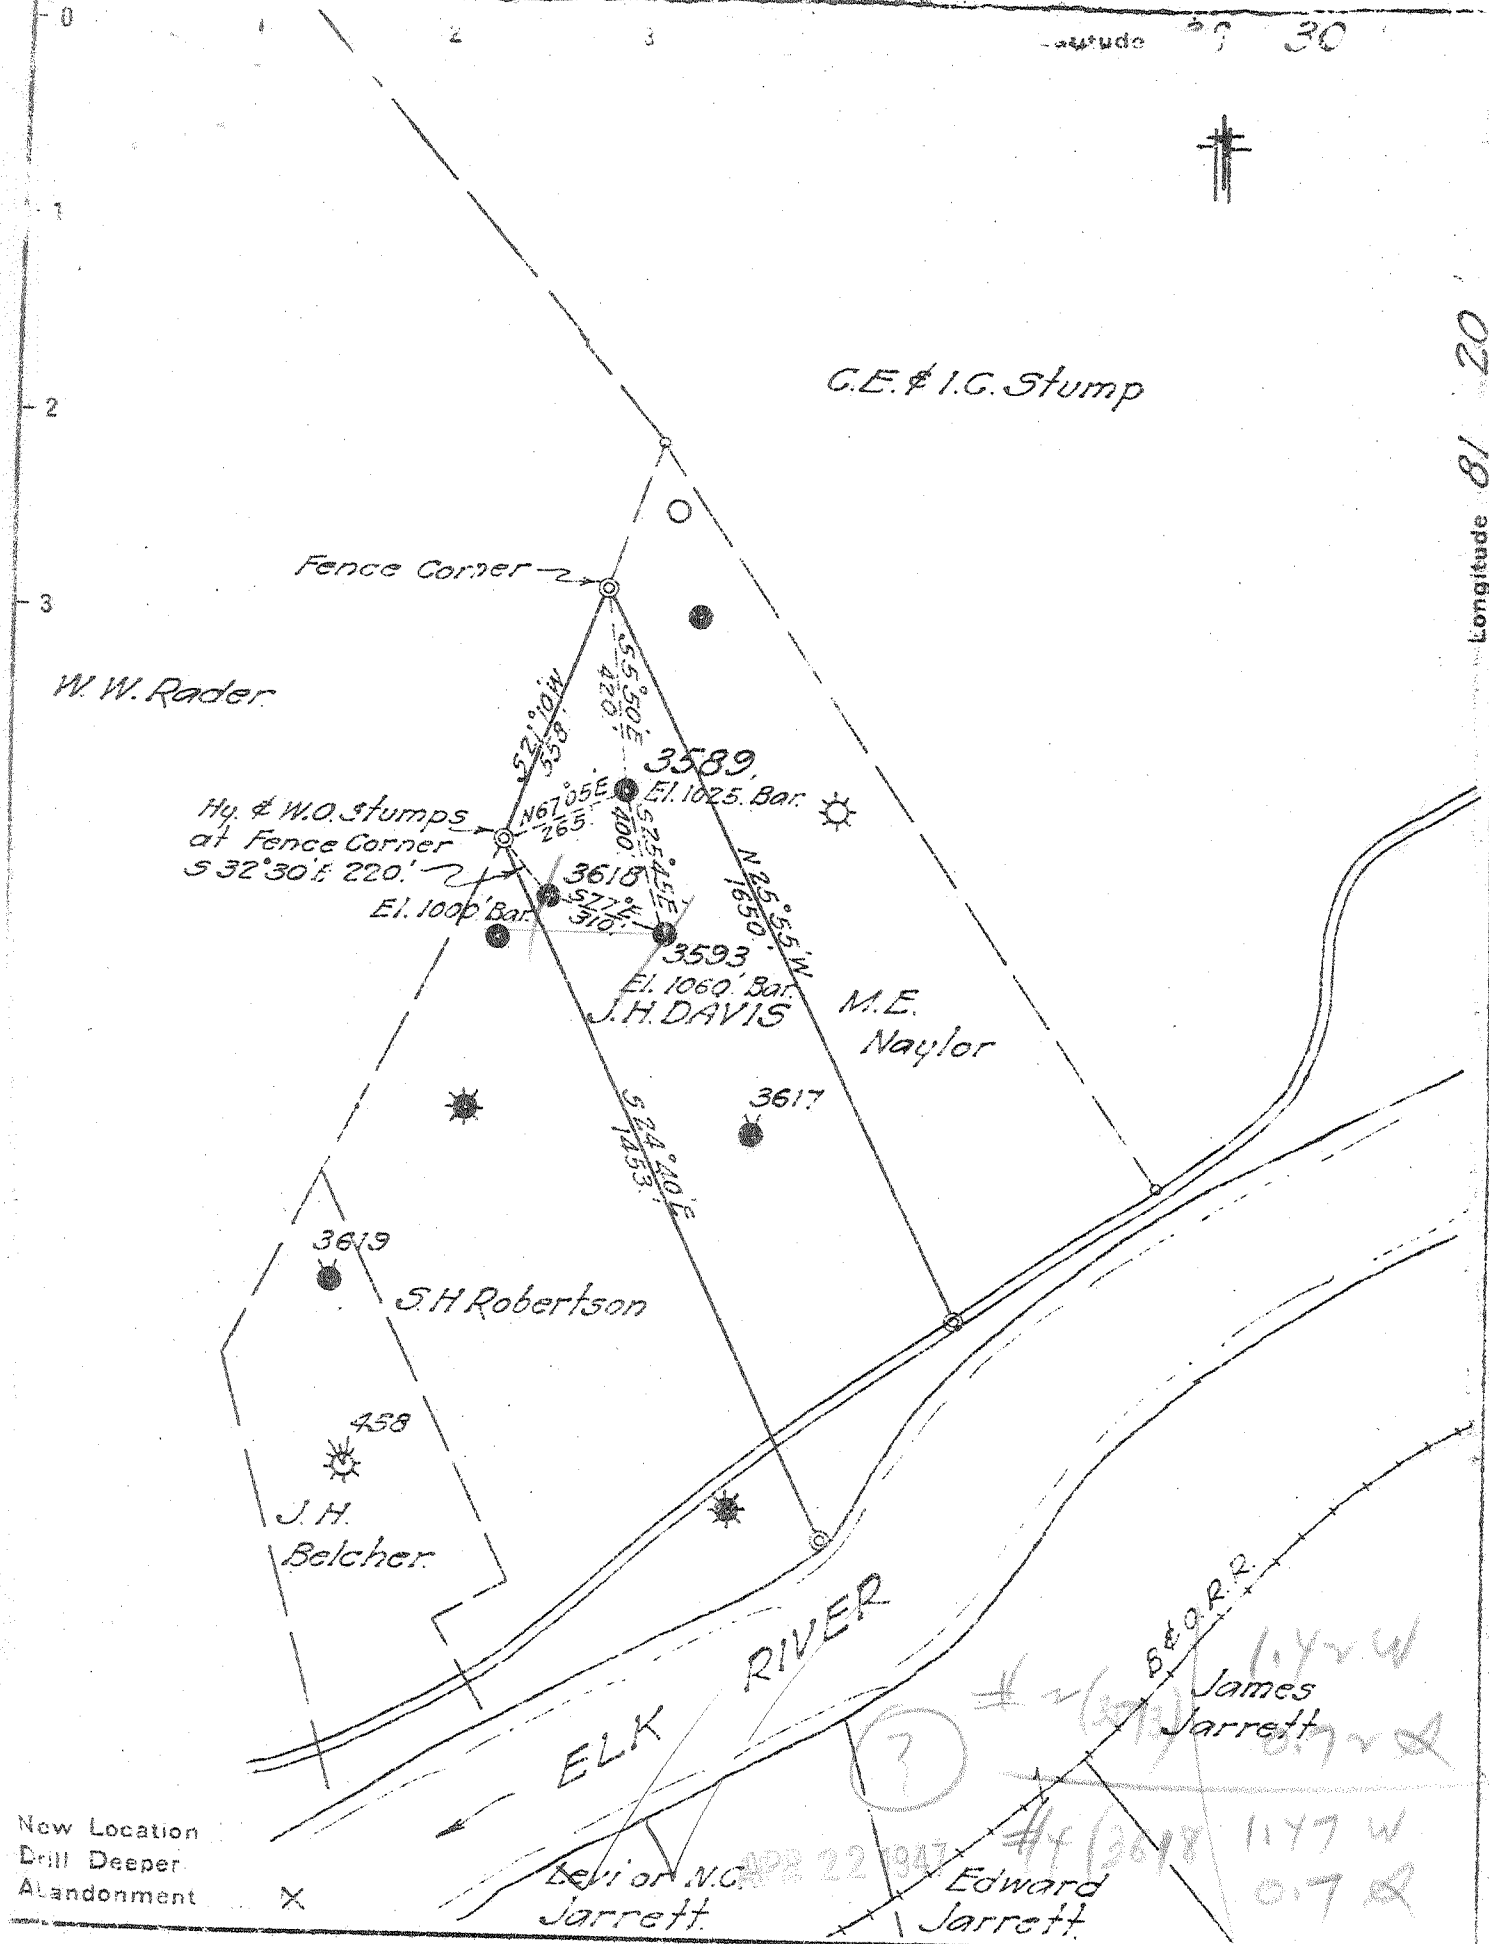

New Location
Drill Deeper
Abandonment

Company ROANE OIL & GAS CO
 Address GLENDENIN W. VA.
 Farm J.H. DAVIS
 Tract _____ Acres 15 Lease No. 10226
 Well (Farm) No. 1-2-4 Serial No. 3589 - 3593
 Elevation (Spirit Level) AS SHOWN
 Quadrangle GLENDENIN
 County KANAWHA District BIG SANDY
 Engineer J.H. Moore
 Engineer's Registration No. 662
 File No. 76-69 Drawing No. _____
 Date AUG 13, 1946 Scale 1" = 400'

STATE OF WEST VIRGINIA
DEPARTMENT OF MINES
OIL AND GAS DIVISION
CHARLESTON

WELL LOCATION MAP
 FILE NO. ROA-468-A, #2
KAN-ROA-469-A, #4

+ Denotes location of well on United States Topographic Maps, scale 1 to 62,500, latitude and longitude lines being represented by border lines as shown.

- Denotes one inch spaces on border line of original tracing.

J.H. DAVIS MS. 2 & 4 (3593) (3618) ROANE O. & G. CO. - ROA-468-469-A



STATE OF WEST VIRGINIA
DEPARTMENT OF MINES
OIL AND GAS DIVISION

1231

WELL RECORD

Permit No. 469-A

Oil or Gas Well X (KIND)

Company Roane Oil & Gas Company (Ohio Fuel Oil Co)
 Address Clendenin, W. Va.
 Farm J. H. Davis Acres 15
 Location (waters) Elk River
 Well No. 4 Serial 3618 Elev. 1000 B
 District Big Sandy County Kanawha
 The surface of tract is owned in fee by _____
 Address _____
 Mineral rights are owned by _____
 Address _____
 Drilling commenced May 15, 1920
 Drilling completed June 24, 1920
 Date Shot --- From _____ To _____
 With _____
 Open Flow /10ths Water in _____ Inch
 /10ths Merc. in _____ Inch
 Volume _____ Cu. Ft.
 Rock Pressure _____ lbs. _____ hrs.
 Oil _____ bbls., 1st 24 hrs.
 Fresh water _____ feet _____ feet
 Salt water _____ feet _____ feet

Casing and Tubing	Used in Drilling	Left in Well	Packers
Size			Kind of Packer
16			
13			
10	16	16	Size of
8 1/2	525		
6 5/8	1765	1765	Depth set
5 3/16			
3			Perf. top
2			Perf. bottom
Liners Used			Perf. top
			Perf. bottom

CASING CEMENTED _____ SIZE _____ No. Ft. _____ Date _____
 COAL WAS ENCOUNTERED AT _____ FEET _____ INCHES
 _____ FEET _____ INCHES FEET _____ INCHES
 _____ FEET _____ INCHES FEET _____ INCHES

Formation	Color	Hard or Soft	Top	Bottom	Oil, Gas or Water	Depth Found	Remarks
Slate & Shells				1080			
Sand			1080	1120			
Slate & shells			1120	1150			
SALT SAND			1150	1545			
Slate & shells			1545	1570			
MAXON SAND			1570	1700			
Little Line			1700	1725			
Slate			1725	1730			
Line Shells			1730	1752			
Pencil Cave			1752	1754			
BIG LIME			1754	1885			
Slate & shells			1885	2108			
WEIR SAND			2108	2124			
Total Depth				2124			