


## Latitude

38°30

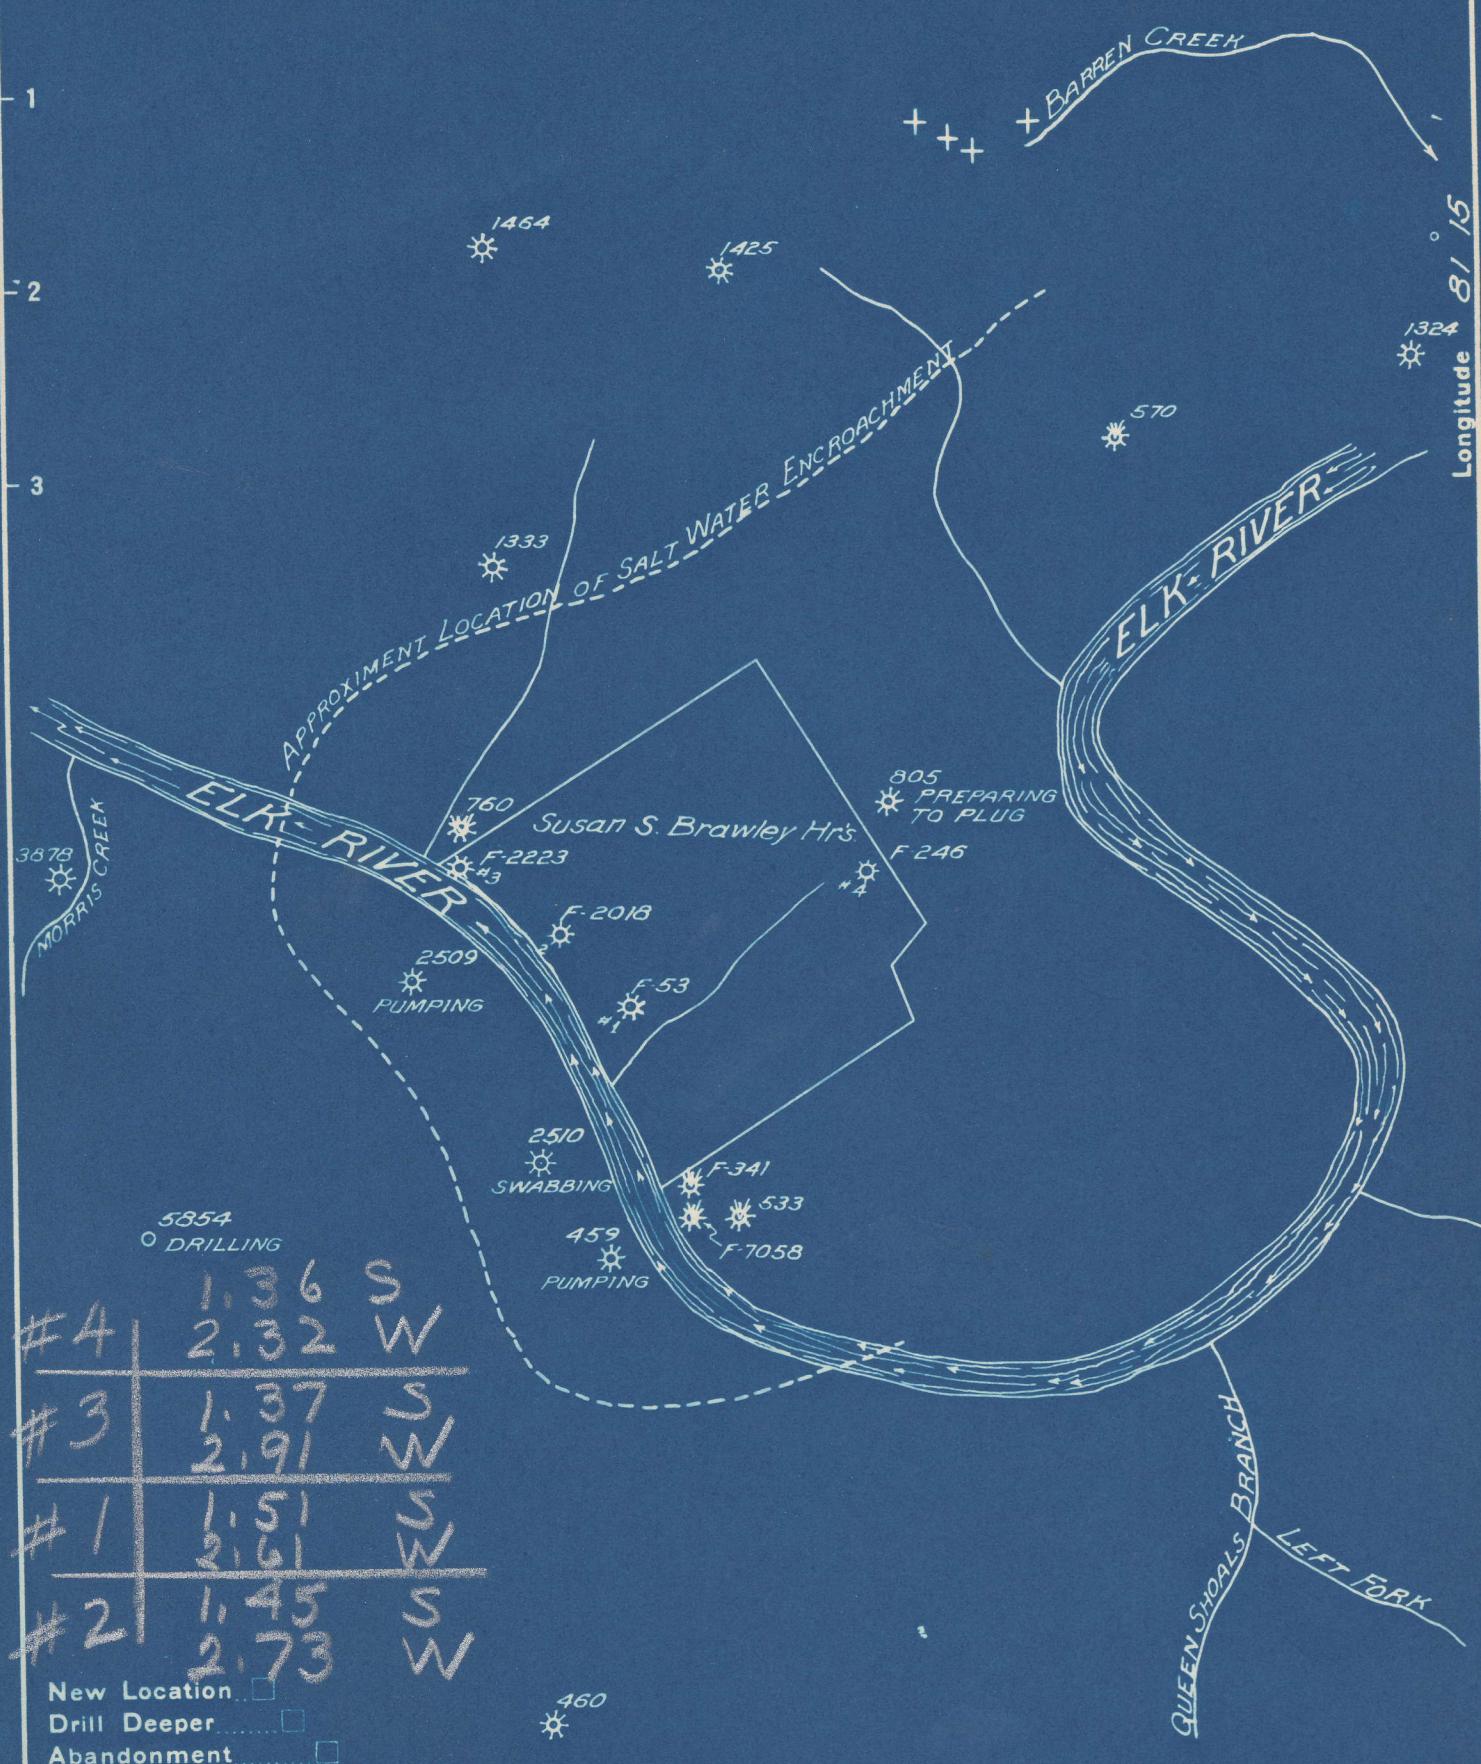

GAS COAL OIL COMPANY  
CHARLESTON  
W. VA.  
WEST VIRGINIA

Address **H.M. BRAWLEY, WEST VIRGINIA**  
**1000 W. CLEVELAND ST., P.O. BOX 102**

Farm SUSAN S. BRAWLEY FRS.

Tract \_\_\_\_\_ Acres 142 Lease No. 18

Well (Farm) No. \_\_\_\_\_ Serial No. ME

Elevation (Spirit Level) \_\_\_\_\_

Quadrangle **CLENDENIN**

County KANAWHA District BIG SANDY

**Engineer** *[Signature]*

**Engineer \_\_\_\_\_**

**Engineer's Registration No.** \_\_\_\_\_

File No. Drawing No. Date APRIL 6 1948 Scale 1" = 1320'

Date 11/20, 1940 Scale 1:1000  
IMPERIAL TRACING CLOTH

STATE OF WEST VIRGINIA  
DEPARTMENT OF MINES  
OIL AND GAS DIVISION  
CHARLESTON

# WELL LOCATION MAP

FILE NO. KAN- H97-A-#4  
KAN- H98-A-#3

KAN-510-A-#1

+ Denotes location of well on United States Topographic Maps, scale 1 to 62,500, latitude and longitude lines being represented by border lines as shown.

— Denotes one inch spaces on border line  
of original tracing.



STATE OF WEST VIRGINIA  
DEPARTMENT OF MINES  
OIL AND GAS DIVISION

## WELL RECORD

Permit No. KAN-397-A

Oil or Gas Well Gas  
(None)

Company	Gascoaloil Company		
Address	Charleston W. Va.		
Farm	Brawley	Acre	
Location (waters)	Elk River		
Well No.	4	Elev.	
District	Big Sandy	County	Kanawha
The surface of tract is owned in fee by Brawley Hrs.			
Address Charleston W. Va.			
Mineral rights are owned by Brawley Hrs.			
Address Charleston W. Va.			
Drilling commenced			
Drilling completed			
Date Shot	From	To	
With			
Open Flow	/10ths Water in	Inch	
	/10ths Merc. in	Inch	
Volume	Cu. Ft.		
Rock Pressure	lbs.	hrs.	
Oil	bbls., 1st 24 hrs.		
Fresh water	feet	feet	
Salt water	feet	feet	
CASING CEMENTED SIZE No. Ft. Date			
COAL WAS ENCOUNTERED AT FEET INCHES			
FEET INCHES FEET INCHES			
FEET INCHES FEET INCHES			

Formation	Color	Hard or Soft	Top	Bottom	Oil, Gas or Water	Depth Found	Remarks
Sand			0	135		135	
Slate			135	137		2	
Sand			137	170		33	
Slate			170	175		5	
Sand			175	240		65	
Coal			240	246		6	
Sand			246	385		139	
Slate & Shells			385	450		65	
Sand			450	580		130	
Slate			580	770		190	
Salt Sand			770	1375		605	
Little Lime			1375	1404		29	
Slate & Shells			1404	1420		16	
Pencil Cave			1420	1428		8	
Big Lime			1428	1553		125	
Keener Sand			1553	1576		23	
White Slate			1576	1588		12	
Red Rock			1588	1620		92	
Total Depth			1620				