

New Location   
 Deeper   
 Abandonment

AUG 31 1948

2141 W  
 K. Y. R. Q

Company VIRGINIAN GASLINE & OIL CO.  
 Address 1 CHARLESTON, W. VA.  
 Farm SCHWARTZ & BARTH  
 Tract \_\_\_\_\_ Acres 100 Lease No. 730  
 Well (Farm) No. 2 Serial No. 2814  
 Elevation (Spirit Level) 749  
 Quadrangle CLENDENIN  
 County HANAWHA District ELK  
 Engineer \_\_\_\_\_  
 Engineer's Registration No. 662  
 File No. 70-65 Drawing No. \_\_\_\_\_  
 Date AUGUST 5 1948 Scale 1" = 660

STATE OF WEST VIRGINIA  
 DEPARTMENT OF MINES  
 OIL AND GAS DIVISION  
 CHARLESTON

WELL LOCATION MAP  
 FILE NO. KAN-520-A

+ Denotes location of well on United States Topographic Maps, scale 1 to 62,500, latitude and longitude lines being represented by border lines as shown.  
 - Denotes one inch spaces on border line of original tracing.



STATE OF WEST VIRGINIA  
DEPARTMENT OF MINES  
OIL AND GAS DIVISION

1306

WELL RECORD

Permit No. \_\_\_\_\_ Abandonment Oil or Gas Well Oil (KIND)


Company VIRGINIAN GASOLINE & OIL COMPANY  
 Address P.O. Box 1273, Charleston 25, W. Va.  
 Farm Swartz & Barth Acres 100  
 Location (waters) Inhoff Br. of Elk River  
 Well No. 2814 Elev. 749-1  
 District Elk County Kanawha  
 The surface of tract is owned in fee by \_\_\_\_\_  
 Address \_\_\_\_\_  
 Mineral rights are owned by Margaret Crowe, et al  
206 Tennessee Ave. Address Charleston, W. Va.  
 Drilling commenced 12-11-11  
 Drilling completed 1-16-12  
 Date Shot Not Given From \_\_\_\_\_ To \_\_\_\_\_  
 With \_\_\_\_\_

Casing and Tubing	Used in Drilling	Left in Well	Packers
Size			
16			Kind of Packer _____
13			
10	45'	45'	Size of <u>57</u>
8 1/4	512'	512'	
6 3/4	1556'	1556'	Depth set <u>all Sect. 1 2</u>
5 3/16			
3			Perf. top _____
2			Perf. bottom _____
Liners Used			Perf. top _____
			Perf. bottom _____

Open Flow /10ths Water in \_\_\_\_\_ Inch  
 /10ths Merc. in \_\_\_\_\_ Inch  
 Volume \_\_\_\_\_ Cu. Ft.  
 Rock Pressure \_\_\_\_\_ lbs. \_\_\_\_\_ hrs.  
 Oil 800 bbls., 1st 24 hrs.  
 Fresh water 150, 390 feet \_\_\_\_\_ feet  
 Salt water 970, 1631 feet \_\_\_\_\_ feet

CASING CEMENTED \_\_\_\_\_ SIZE \_\_\_\_\_ No. Ft. \_\_\_\_\_ Date \_\_\_\_\_  
 COAL WAS ENCOUNTERED AT 396 FEET 48 INCHES  
 \_\_\_\_\_ FEET \_\_\_\_\_ INCHES \_\_\_\_\_ FEET \_\_\_\_\_ INCHES  
 \_\_\_\_\_ FEET \_\_\_\_\_ INCHES \_\_\_\_\_ FEET \_\_\_\_\_ INCHES

Formation	Color	Hard or Soft	Top	Bottom	Oil, Gas or Water	Depth Found	Remarks
Coal			396	400	Water	150'	Fresh
Slate			400	410	Water	390'	Fresh
Sand			410	512			
Slate & Sand			512	565			
Slate			565	690			
Sand			690	805			
Lime & Shells			805	840			
Salt Sand			840	1344	Oil	842'	Show Oil
Red Rock			1344	1362	Water	970'	Salt Water
White Slate			1362	1424			
Red Rock			1424	1435			
Lime			1435	1512			
Slate			1512	1517			
Little Lime			1517	1532			
Pencil Cave			1532	1540			
Lime & Shells			1540	1546			
Big Lime			1546	1710	Gas	1626	In Line
Sand			1710	1725	Water	1631	In Line
Red Rock			1725	1776			
Black Sand			1776	1810			
Oil Sand			1810	1823			
Total Depth:				1823'			

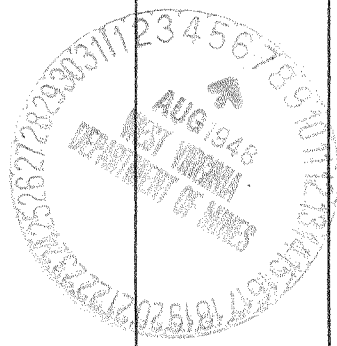

SEP 23 1948

